

KANSAS


Butler

Section 8 Township 26 Range 5EWell No. 2 3 SigmanCompany K.T. Weidemann

Misc.

NORTH

WEST

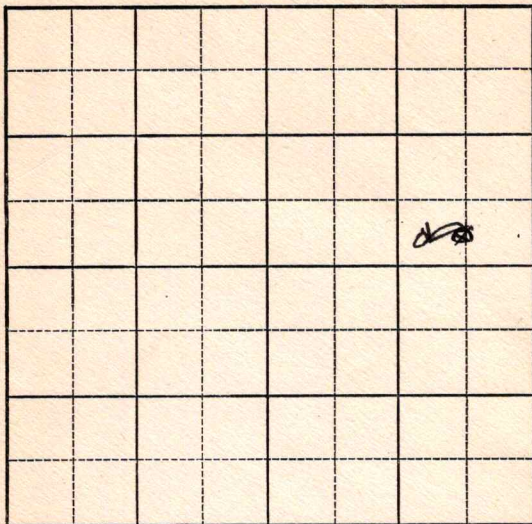

EAST

SOUTH

KANSAS

Butler

Sec. 8 Twp. 26 R. 5E ✓Well No. #2
#3 Sigan Farm

K. T. Weidemann

Company

Miscellaneous


Ft. from N. Line

330' Ft. from S. Line

990
~~600~~ Ft. from E. Line

Ft. from W. Line

NORTH

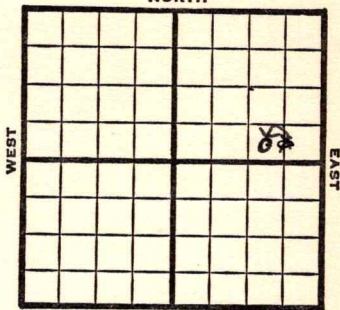

SOUTH

Sw 1/4 NE.

CS L SE NE

1949 Elev ¹³⁵⁹ 1357' REPORT

3/9

RUR

3/16 8" @ 41'

Lansing 1677'

KC 1968'

Drlg. 2055'

3/23 Arb. 2419-20'

TD 2420'

5" @ 2419'

3/30 TD 2455' - 60 qts

4/6 "

4/12 "

4/20 "

4/27 "

5/4 TD 2455'

Arb. 2419'

5" @ 2419'

Pump 25 Oil Pot

38° Gr.

Comp

COMPLETED

Map No. _____ Sec. 8 Twp. 26 R. 5E

Well No. 3 Sigman

K. T. Weidemann Company

FIRST REPORT Contractor

C S L SE NE

SECTION PLAT

_____ Ft. from N. Line

330 Ft. from S. Line

660 Ft. from E. Line

_____ Ft. from W. Line

Butler County

Location _____

Rig up _____

Drilling and Remarks:

R U R

RECORD

Cased _____ in., _____ ft.

Sand _____

Gas _____

Oil _____

Total Depth _____

PRODUCTION

1st 24 hrs. Nat. _____

1st 24 hrs. after shot _____

Gas _____ Cu. Ft.

Dry Hole _____

Abandoned _____

Date

MAR 9 1949

19

S. J. LEWIS

Scout

Map No. 14 Sec. 8 Twp. 26 R. 5E

Well No. 2 Sigman

K. T. Weidemann Company

CORRECTION Contractor

SW SE NE

SECTION PLAT

 Ft. from N. Line

330 Ft. from S. Line

990 Ft. from E. Line

 Ft. from W. Line

Butler County

Location

Rig up

Drilling and Remarks:

Reported as

#3 Sigman

C S L SE NE

RECORD

Cased in., ft.

Sand

Gas

Oil

Total Depth

PRODUCTION

1st 24 hrs. Nat.

1st 24 hrs. after shot

Gas Cu. Ft.

Dry Hole

Abandoned

Date

APR 6 1949 19

S. J. LEWIS Scout

Map No. K14 Sec. 8 Twp. 26 R. 5EWell No. 2 SigmanK. T. Weidemann

Company

COMPLETE

Contractor

SW SE NE

E1, 1959
SECTION PLAT

			0

 Ft. from N. Line330 Ft. from S. Line990 Ft. from E. Line Ft. from W. LineButler CountyLocation Rig up

Drilling and Remarks:

CR 824195" @ 2419Pump 25 oil 803800**RECORD**Cased in., ft.Sand Gas Oil Total Depth 2455**PRODUCTION**1st 24 hrs. Nat. 1st 24 hrs. after shot Gas Cu. Ft.Dry Hole Abandoned

Date

MAY 4 1949

19

S. J. LEWIS

Scout