

Map No. _____ Sec. 10 Twp. 26 R. 5Well No. 1 Page 2 Farm _____Yellow Pine Company _____

NORTH

WEST

EAST

SOUTH

Location _____

Rig Up 6/19

Drilling Remarks:

10/3-248010/11-2500

Drilling Remarks:

RECORD

Cased _____ in _____ Ft.

Sand _____

Gas _____

Oil _____

Total Depth _____

PRODUCTION

1st 24 hrs. Nat. _____

1st 24 hrs. after shot _____

Gas _____ Cu. Ft.

Dry Hole 2727

Abandoned _____

Map No. _____ Sec. 10 Twp. 26 R 5Well No. 1 Page unknown Farm _____
Company _____

NORTH

WEST

EAST

SOUTH

Location _____

Rig Up ☒

Drilling and remarks _____

RECORD

Cased _____ in. _____ Ft.

Sand _____

Gas _____

Oil _____

Total Depth _____

PRODUCTION

1st 24 hrs. Nat. _____

1st 24 hrs. after shot _____

Gas _____ Cu. Ft.

Dry Hole _____

Abandoned _____

Date

4/9, 1916 Per Andy Scout

Map No. _____ Sec. 10 Twp. 26 R. 5
 Well No. 1 Pange Farm _____
W. K. Brown Company _____

NORTH

WEST

EAST

SOUTH

Location _____
 Rig Up ☒ _____
 Drilling and remarks _____

RECORD

Cased _____ in. _____ Ft.
 Sand _____
 Gas _____
 Oil _____
 Total Depth _____

PRODUCTION

1st 24 hrs. Nat. _____
 1st 24 hrs. after shot _____
 Gas _____ Cu. Ft.
 Dry Hole _____
 Abandoned _____


Date

191

Scout

Map No. _____ Sec. 10 Twp. 26 R. 5
 Well No. 10 Page Farm _____
Yellow Pine oil Company

NORTH

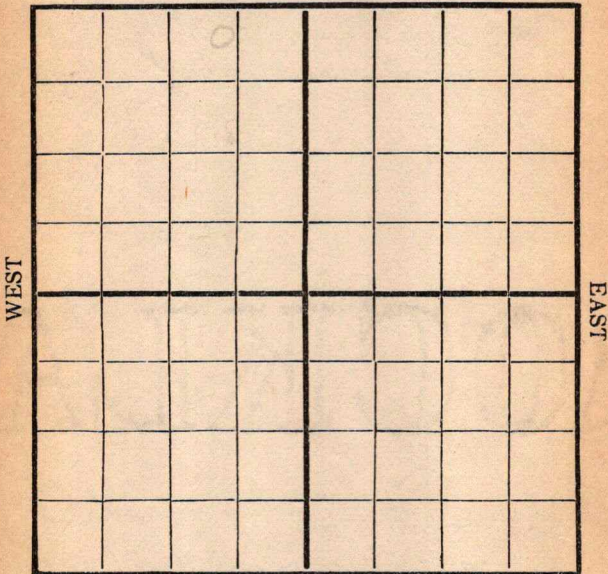

SOUTH

Location _____
 Rig Up _____
 Drilling and remarks _____

RECORD

Cased _____ in. _____ Ft.
 Sand _____
 Gas _____
 Oil _____
 Total Depth _____

PRODUCTION

1st 24 hrs. Nat. _____
 1st 24 hrs. after shot _____
 Gas _____ Cu. Ft.
 Dry Hole _____
 Abandoned _____

Date

7/6, 1916 6 Scout

Map No. _____ Sec. 10 Twp. 26 R. 5Well No. 1 Page Farm _____Yellow Pine Company _____

NORTH

WEST

EAST

SOUTH

Location _____

Rig Up _____

Drilling and remarks

150'

RECORD

Cased _____ in. _____ Ft.

Sand _____

Gas _____

Oil _____

Total Depth _____

PRODUCTION

1st 24 hrs. Nat. _____

1st 24 hrs. after shot _____

Gas _____ Cu. Ft.

Dry Hole _____


Abandoned _____

Date

7/13, 1916 L. M. S. J. Scout

Map No. _____ Sec. 10 Twp. 26 R. 5
 Well No. 1842 Farm _____
Yellow Pine Company _____

NORTH

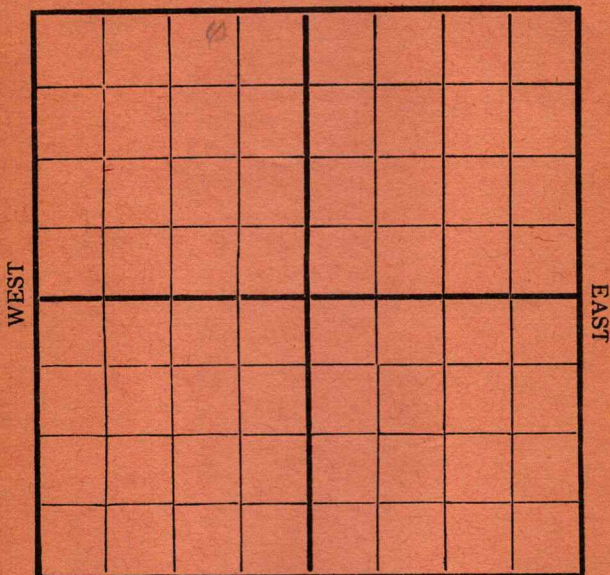

SOUTH

Location _____

Rig Up _____

Drilling and remarks

750'

RECORD

Cased _____ in. _____ Ft.

Sand _____

Gas _____

Oil _____

Total Depth _____

PRODUCTION

1st 24 hrs. Nat. _____

1st 24 hrs. after shot _____

Gas _____ Cu. Ft.

Dry Hole _____

Abandoned _____

Date

7/29, 1916 Scout Scout

Map No. _____ Sec. 10 Twp. 26 R. 5Well No. 1 Paylen FarmYellow Pine Company

NORTH

WEST

EAST

SOUTH

Location _____

Rig Up _____

Drilling and remarks

975

RECORD

Cased _____ in. _____ Ft.

Sand _____

Gas _____

Oil _____

Total Depth _____

PRODUCTION

1st 24 hrs. Nat. _____

1st 24 hrs. after shot _____

Gas _____ Cu. Ft.

Dry Hole _____

Abandoned _____

Date

8/31916L. L. Lipp

Scout

Map No. _____ Sec. 10 Twp. 26 R. 5

Well No. _____ Farm _____

Yellow Pine Company _____

NORTH

WEST

EAST

SOUTH

Location _____

Rig Up _____

Drilling and remarks

Lost tools
in hole - Had
to start rig
40 ft

RECORD

Cased _____ in. _____ Ft.

Sand _____

Gas _____

Oil _____

Total Depth _____

PRODUCTION

1st 24 hrs. Nat. _____

1st 24 hrs. after shot _____

Gas _____ Cu. Ft.

Dry Hole _____

Abandoned _____

Date


8/9, 191 6. A. Anderson Scout

Map No. _____ Sec. 10 Twp. 26 R. 5
 Well No. 1 Page Farm _____
Yellow Pine Company _____

NORTH

WEST

EAST

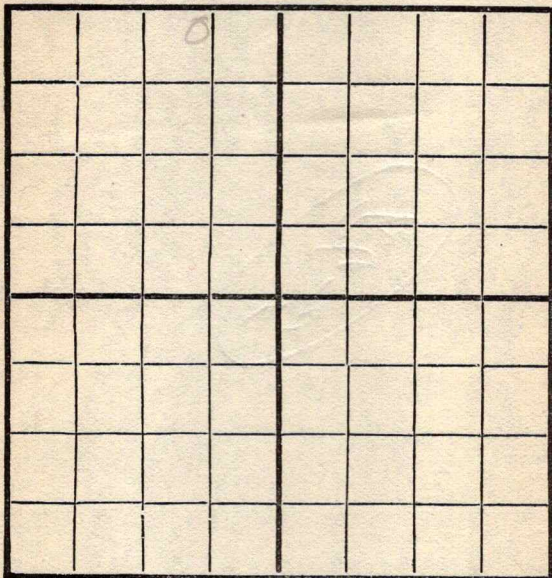

SOUTH

RECORD

Location _____
 Rig Up _____
 Drilling and remarks _____

Cased _____ in. _____ Ft.
 Sand _____
 Gas _____
 Oil _____
 Total Depth _____

PRODUCTION

1st 24 hrs. Nat. _____
 First 24 h.s. after shot _____
 Gas _____ Cu. Ft.
 Dry Hole _____
 Abandoned _____

Date 8/23, 1916 Reed Scout

Map No. _____ Sec. 10 Twp. 26 R. 5
 Well No. _____ Farm _____
Yellow Pine Company

NORTH

WEST

EAST

SOUTH

Location _____
 Rig Up _____
 Drilling and remarks

RECORD

Cased _____ in. _____ Ft.
 Sand _____
 Gas _____
 Oil _____
 Total Depth _____

PRODUCTION

1st 24 hrs. Nat. _____
 1st 24 hrs. after shot _____
 Gas _____ Cu. Ft.
 Dry Hole _____
 Abandoned _____

Date

191

Scout

AUG 29 1916

Record

Map No. _____ Sec. 10 Twp. 26 R. 5

Well No. _____ Farm _____

_____ Company _____

NORTH

WEST

EAST

SOUTH

Location _____

Rig Up _____

Drilling and remarks

1720

RECORD

Cased _____ in. _____ Ft.

Sand _____

Gas _____

Oil _____

Total Depth _____

PRODUCTION

1st 24 hrs. Nat. _____

1st 24 hrs. after shot _____

Gas _____ Cu. Ft.

Dry Hole _____

Abandoned _____

Date


9/13, 1916 S. A. ... Scout

Map No. _____ Sec. 10 Twp. 26 R. 5
Well No. 1 Page Farm _____
Yellow Pine Company _____

NORTH

WEST

EAST

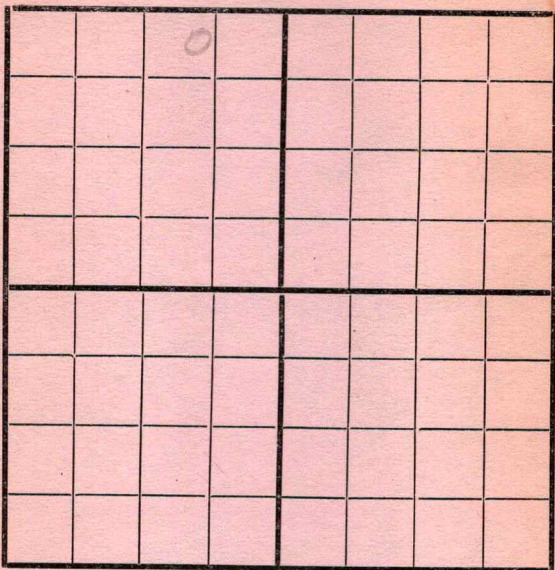

SOUTH

Location _____
Rig Up _____
Drilling and remarks _____

RECORD

Cased _____ in. _____ Ft.
Sand _____
Gas _____
Oil _____
Total Depth _____

PRODUCTION


1st 24 hrs. Nat. _____
1st 24 hrs. after shot _____
Gas _____ Cu. Ft.
Dry Hole _____
Abandoned _____

Date 9/5-6 191 6 Scout

Map No. _____ Sec. 10 Twp. 26 R. 5
Well No. 2260 Farm _____
Yellow Pine Company _____

NORTH

WEST

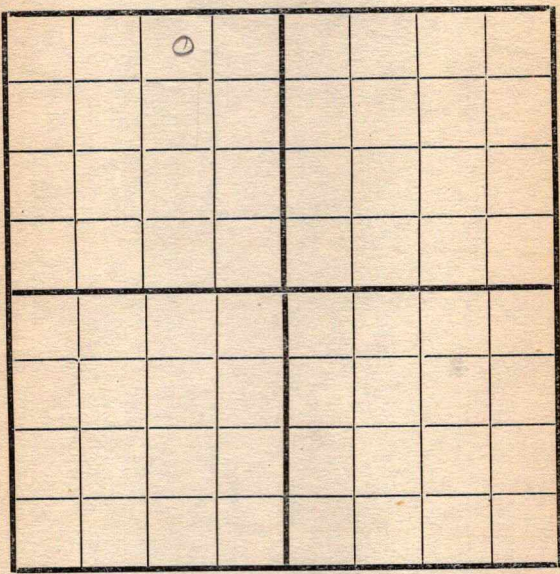

EAST

SOUTH

Location _____

Rig Up _____

Drilling and remarks

2260

RECORD

Cased _____ in. _____ Ft.

Sand _____

Gas _____

Oil _____

Total Depth _____

PRODUCTION

1st 24 hrs. Nat. _____

1st 24 hrs. after shot _____

Gas _____ Cu. Ft.

Dry Hole _____

Abandoned _____

Date


9/20 1916 Scout Scout _____

Map No. _____ Sec. 10 Twp. 26 R. 5
Well No. Page Farm _____
Yellow Pine Co. Company

NORTH

WEST

EAST

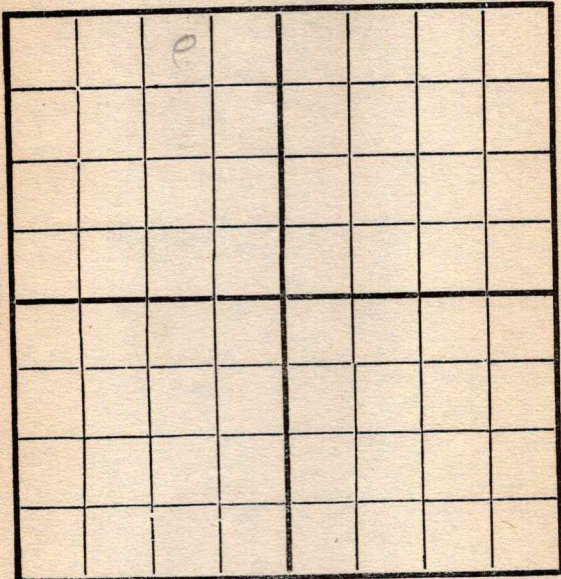

SOUTH

Location _____
Rig Up _____
Drilling and remarks

2300

RECORD

Cased _____ in. _____ Ft.
Sand _____
Gas _____
Oil _____
Total Depth _____

PRODUCTION

1st 24 hrs. Nat. _____
First 24 hrs. after shot _____
Gas _____ Cu. Ft.
Dry Hole _____
Abandoned _____

Date

9/26, 1916 Scout

Map No. _____ Sec. 10 Twp. 26 R. 5
 Well No. 1 Page Farm _____
Yellow Pine Oil Company

NORTH

WEST			0						EAST

SOUTH

Location _____
 Rig Up _____
 Drilling and remarks

2480

RECORD

Cased _____ in. _____ Ft.
 Sand _____
 Gas _____
 Oil _____
 Total Depth _____


PRODUCTION

1st 24 hrs. Nat. _____
 1st 24 hrs. after shot _____
 Gas _____ Cu. Ft.
 Dry Hole _____
 Abandoned _____

Date 10/3, 1916 Record Scout

Map No. _____ Sec. 10 Twp. 26 R. 5
Well No. Yellow Pine Farm _____
_____ Company _____

NORTH

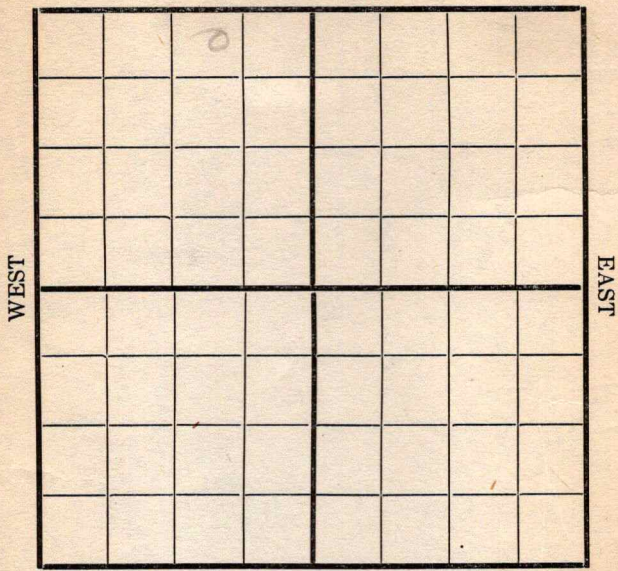

SOUTH

Location _____
Rig Up _____
Drilling and remarks _____

2500
Half full
of water

RECORD

Cased _____ in. _____ Ft.
Sand _____
Gas _____
Oil _____
Total Depth _____

PRODUCTION


1st 24 hrs. Nat. _____
1st 24 hrs. after shot _____
Gas _____ Cu. Ft.
Dry Hole _____
Abandoned _____

Date 10/11, 1916 ACCORD _____

Map No. _____ Sec. 10 Twp. 26 R. 5
 Well No. 1 Page Farm _____
Yellow Pine Company _____

NORTH

WEST

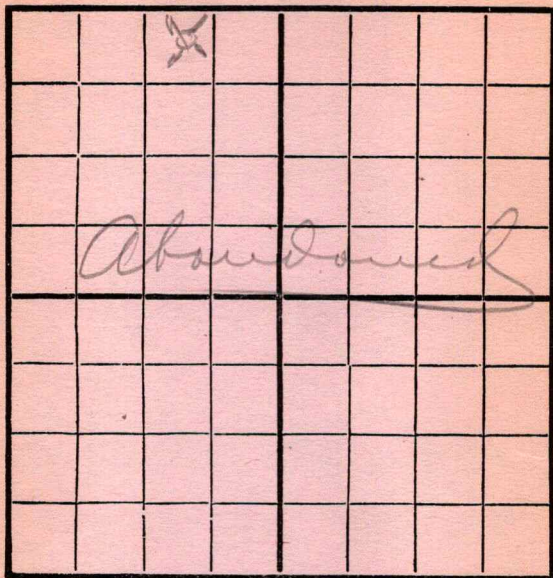

EAST

SOUTH

Location _____

Rig Up _____

Drilling and remarks _____

Dry at
2727

RECORD

Cased _____ in. _____ Ft.

Sand _____

Gas _____

Oil _____

Total Depth _____

PRODUCTION

1st 24 hrs. Nat. _____

First 24 hrs. after shot _____

Gas _____ Cu. Ft.

Dry Hole 2727

Abandoned _____


Date

10/8 6 P. Candy
 _____, 191____ Scout _____

Map No. _____ Sec. 20 Twp. 26 R. 5
 Well No. _____ Farm _____
 _____ Company _____

NORTH

WEST

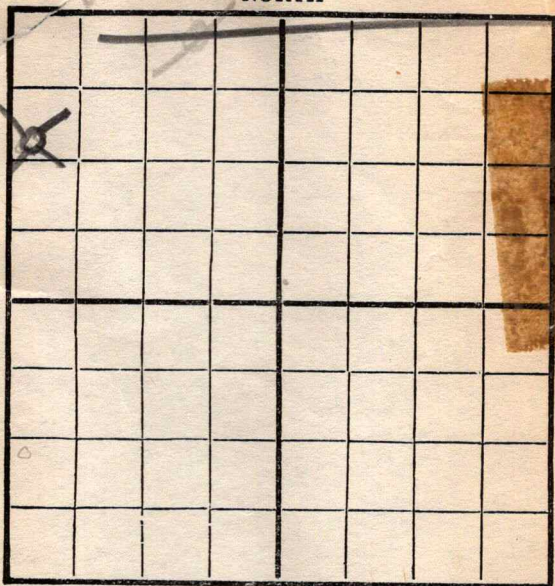

EAST

SOUTH

Location _____
 Rig Up _____
 Drilling and remarks _____

RECORD

Cased _____ in. _____ Ft.
 Sand _____
 Gas _____
 Oil _____
 Total Depth _____

PRODUCTION

1st 24 hrs. Nat. _____
 First 24 hrs. after shot _____
 Gas _____ Cu. Ft.
 Dry Hole _____
 Abandoned _____

Date

1/4, 1917 Carney Scout _____