

Map No. _____ Sec. 9 Twp. 26 R. 5Well No. 2 Page Pringle FarmYellow Pine Oil Co. Company

NORTH

(Page)

WEST

EAST

SOUTH

COMPLETED

Location _____

Rig Up _____

Drilling Remarks:

Drilling Remarks:

RECORD

PRODUCTION

Cased _____ in _____ Ft.

1st 24 hrs. Nat. _____

Sand _____

1st 24 hrs. after shot _____

Gas _____

Gas _____ Cu. Ft.

Oil _____

Dry Hole _____


Total Depth _____

Abandoned _____

Map No. _____ Sec. 9 Twp. 26 R. 5
 Well No. 2 Page Farm
Yellow Pine 044 Company

NORTH

WEST

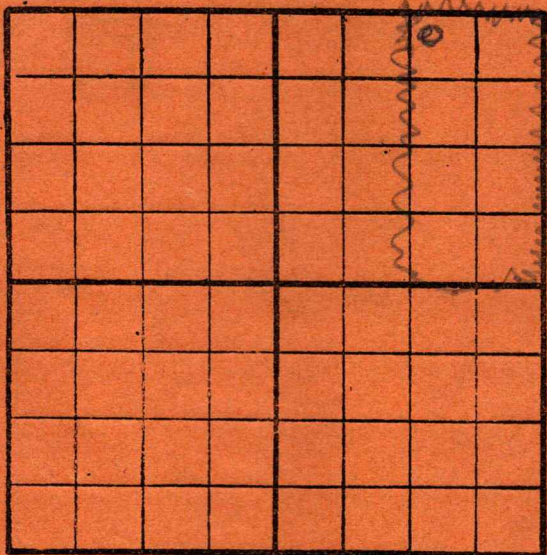

EAST

SOUTH

Location ✓
 Rig up ✓

Drilling and remarks:

FIRST REPORT

RECORD

Cased _____ in. _____ Ft.
 Sand _____
 Gas _____
 Oil _____
 Total Depth _____

PRODUCTION


1st. 24 hrs. Nat. _____
 1st. 24 hrs. after shot. _____
 Gas _____ Cu. Ft.
 Dry Hole _____
 Abandoned _____

Date

7/21, 1917 Cardiff Scout

Map No. _____ Sec. 9 Twp. 26 R. 5
 Well No. 2 Page Farm _____
Yellow Pine Company

NORTH

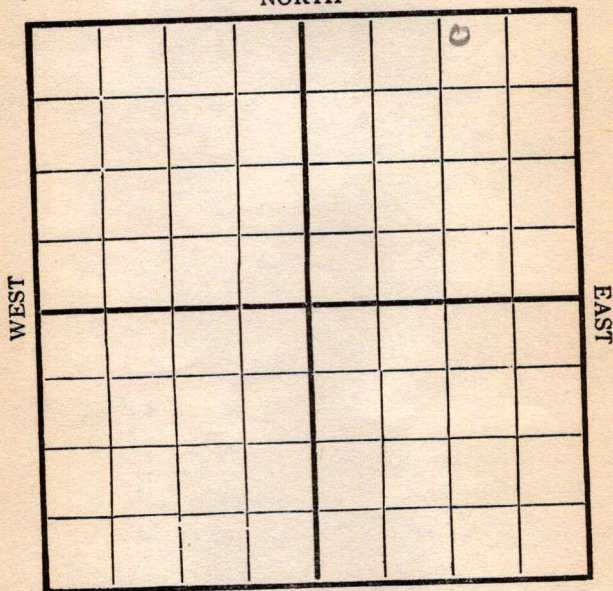

SOUTH

RECORD

Location ✓
 Rig Up ✓
 Drilling and remarks

Cased _____ in. _____ Ft.
 Sand _____
 Gas _____
 Oil _____
 Total Depth _____

PRODUCTION


1st 24 hrs. Nat. _____
 First 24 hrs. after shot _____
 Gas _____ Cu. Ft.
 Dry Hole _____
 Abandoned _____

Date

Feb 26 1912 Page Scout

Map No. _____ Sec. 9 Twp. 26 R. 5
 Well No. 2 Page Farm _____
Yellow Pine Company _____

NORTH

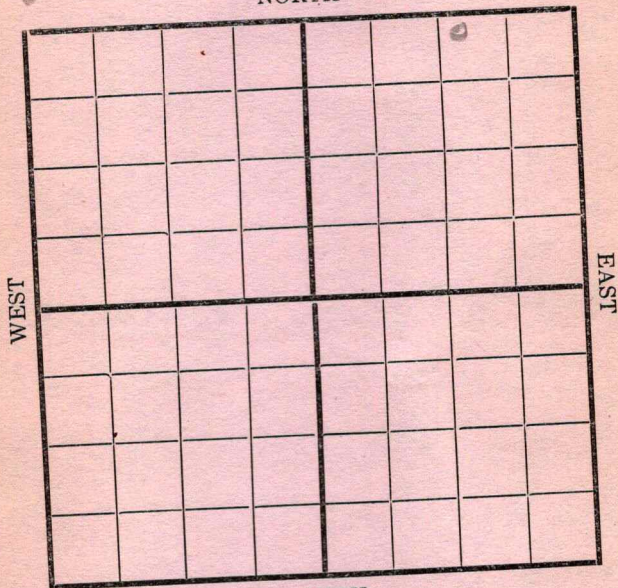

SOUTH

Location _____
 Rig Up _____
 Drilling and remarks _____

*Rigging
up*

RECORD

Cased _____ in. _____ Ft.
 Sand _____
 Gas _____
 Oil _____
 Total Depth _____

PRODUCTION

1st 24 hrs. Nat. _____
 1st 24 hrs. after shot _____
 Gas _____ Cu. Ft.
 Dry Hole _____
 Abandoned _____

Date

3/5, 1917. Candy Scout

Map No. _____ Sec. 9 Twp. 26 R. 5Well No. 2 Page Farm _____Yellow Pine Company _____

NORTH

WEST

EAST

SOUTH

Location _____

Rig up _____

Drilling and Remarks:

Rigged up

RECORD

Cased _____ in. _____ Ft.

Sand _____

Gas _____

Oil _____

Total Depth _____

PRODUCTION

1st 24 hrs. Nat. _____

1st 24 hrs. after shot _____

Gas _____ Cu. Ft.

Dry Hole _____

Abandoned _____

Date

3/12, 1917, End Scout

Map No. _____ Sec. 9 Twp. 26 R. 5Well No. 2 Page Farm _____Yellow Pine Company _____

NORTH

WEST

EAST

SOUTH

Location ✓Rig Up ✓

Drilling and remarks _____

RECORD

Cased _____ in. _____ Ft.

Sand _____

Gas _____

Oil _____

Total Depth _____

PRODUCTION

1st 24 hrs. Nat. _____

1st 24 hrs. after shot _____

Gas _____ Cu. Ft.

Dry Hole _____


Abandoned _____

Date

8/2 191 2 Carley Scout

Map No. _____ Sec. 9 Twp. 26 R. 5Well No. 2 Paye FarmYellow Pine Company

NORTH

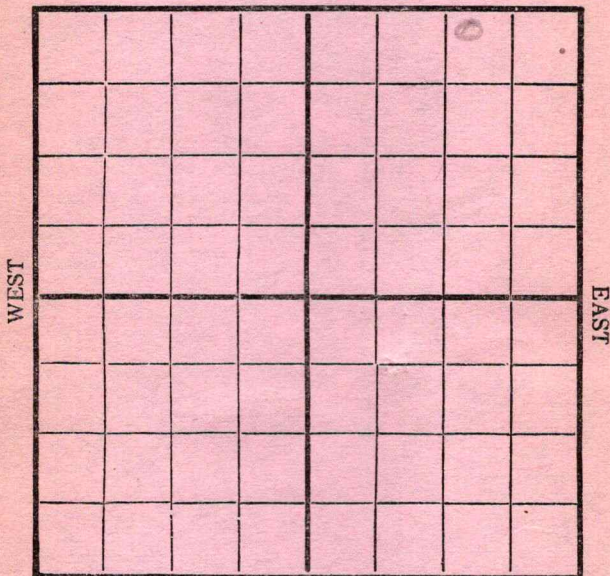

SOUTH


REMARKS:

Rigged up

Date

3/26, 1917 C. C. C. Scout

Map No. _____ Sec. 9 Twp. 26 R. 5
 Well No. 2 Page Farm _____
Yellow Pine Company _____
 NORTH

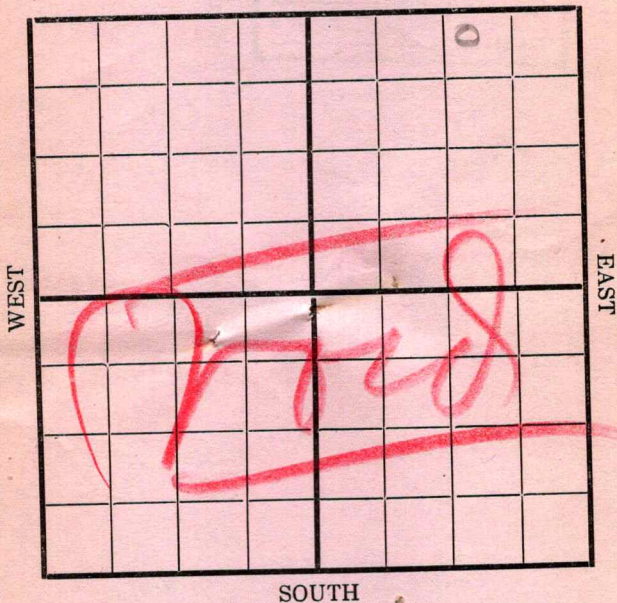

Location _____
 Rig Up _____
 Drilling and remarks _____

*Wrong
 name
 in form*

RECORD

Cased _____ in. _____ Ft.
 Sand _____
 Gas _____
 Oil _____
 Total Depth _____

PRODUCTION

1st 24 hrs. Nat. _____
 1st 24 hrs. after shot _____
 Gas _____ Cu. Ft.
 Dry Hole _____
 Abandoned _____


Date

4/15, 191 7 _____ Scout

Map No. _____ Sec. 9 Twp. 26 R. 5
Well No. 2 Principle Farm _____
Yellow Pine Company _____

NORTH

WEST

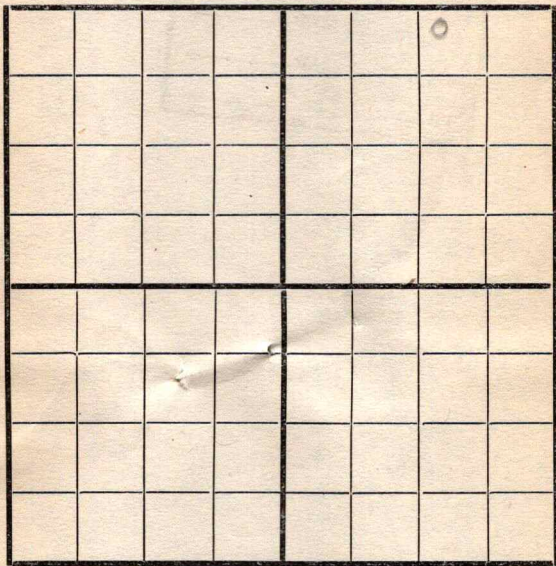

EAST

SOUTH

Location _____

Rig Up _____

Drilling and remarks

Rigged up

RECORD

Cased _____ in. _____ Ft.

Sand _____

Gas _____

Oil _____

Total Depth _____

PRODUCTION

1st 24 hrs. Nat. _____

1st 24 hrs. after shot _____

Gas _____ Cu. Ft.

Dry Hole _____

Abandoned _____

Date

4/5, 191 *7* *Carbide* Scout

Map No. _____ Sec. 9 Twp. 26 R. 5
 Well No. 2 Pringle Farm _____
Yellow Pine Company

NORTH

WEST

EAST

SOUTH

Location _____

Rig Up _____

Drilling and remarks

Rigged up

RECORD

Cased _____ in. _____ Ft.

Sand _____

Gas _____

Oil _____

Total Depth _____

PRODUCTION

1st 24 hrs. Nat. _____

1st 24 hrs. after shot _____

Gas _____ Cu. Ft.

Dry Hole _____


Abandoned _____

Date

4/11, 1917 *Carley* Scout

Map No. _____ Sec. 9 Twp. 26 R. 5
 Well No. 2 Pringle Farm _____
Yellow Pine Company _____

NORTH

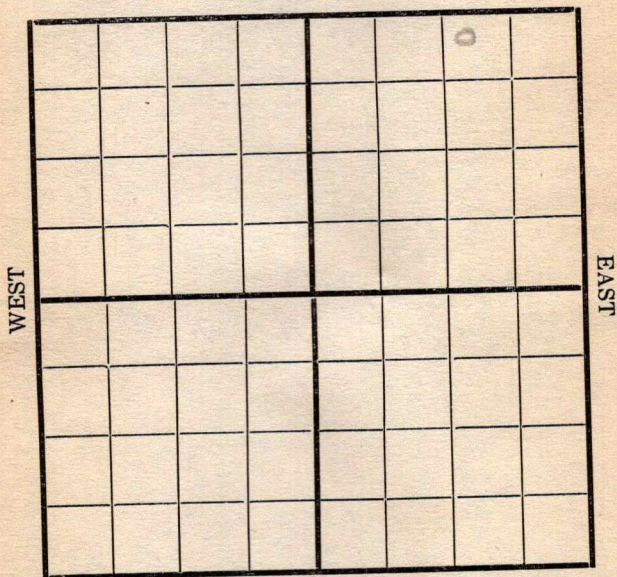

SOUTH

Location _____

Rig Up ☒ _____

Drilling and remarks _____

RECORD

Cased _____ in. _____ Ft.

Sand _____

Gas _____

Oil _____

Total Depth _____

PRODUCTION

1st 24 hrs. Nat. _____

1st 24 hrs. after shot _____

Gas _____ Cu. Ft.

Dry Hole _____


Abandoned _____

Date

4/9, 1917 Carney Scout

Map No. _____ Sec. 9 Twp. 26 R. 5
Well No. 2 Pringle Farm
Yellow Pine Company

NORTH

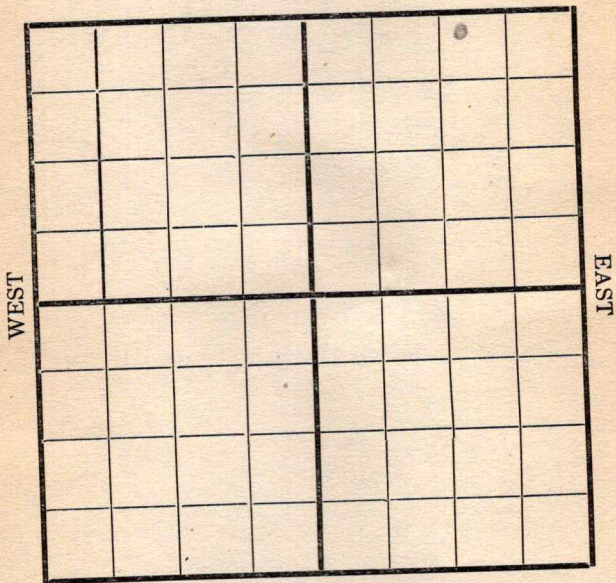

SOUTH

Location _____
Rig Up _____
Drilling and remarks _____

RECORD

Cased _____ in. _____ Ft.
Sand _____
Gas _____
Oil _____
Total Depth _____

PRODUCTION

1st 24 hrs. Nat. _____
1st 24 hrs. after shot _____
Gas _____ Cu. Ft.
Dry Hole _____
Abandoned _____

Date

4/26 191 7 Conley Scout

Map No. _____ Sec. 9 Twp. 26 R. 5Well No. 2 Page _____ Farm _____Yellow Pine Company

NORTH

WEST

EAST

SOUTH

Location _____

Rig up _____

Drilling and remarks:

Rig.

RECORD

Cased _____ in. _____ Ft.

Sand _____

Gas _____

Oil _____

Total Depth _____

PRODUCTION

1st 24 hrs. Nat. _____

1st 24 hrs. after shot _____

Gas _____ Cu. Ft.

Dry Hole _____

Abandoned _____

Date

5/5, 1917, Brocker Scout

Map No. _____ Sec. 9 Twp 26 R. 5Well No. 2 Pingrey Farm
Yellow Pine Company
NORTH

						0	

SOUTH

Location _____

Rig up _____

Drilling and remarks:

Rig

RECORD

Cased _____ in. _____ Ft.

Sand _____

Gas _____

Oil _____

Total Depth _____

PRODUCTION

1st 24 hrs. Nat. _____

1st 24 hrs. after shot _____

Gas _____ Cu. Ft.


Dry Hole _____

Abandoned _____

Date

5/12, 1917, Crocker Scout

Map No. _____ Sec. 9 Twp. 26 R. 3
Well No. 2 Pingrey Far _____
Yellow Pine Company
NORTH

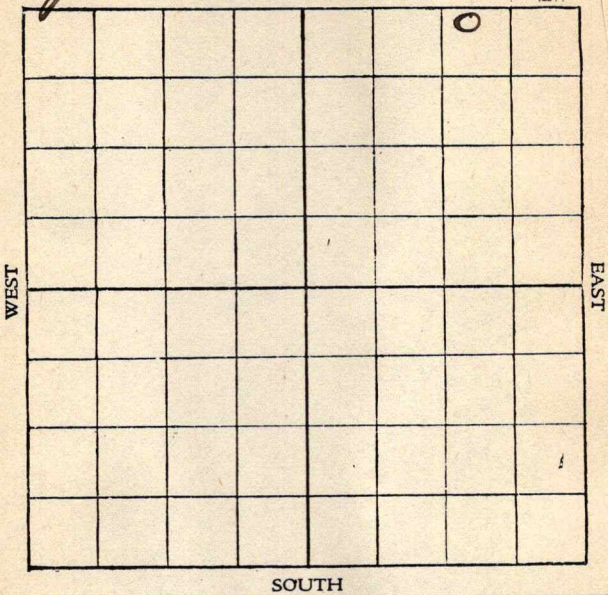

Location _____

Rig up _____

Drilling and remarks:

Pingrey

RECORD

Cased _____ in. _____ Ft.

Sand _____

Gas _____

Oil _____

Total Depth _____

PRODUCTION

1st 24 hrs. Nat. _____

1st 24 hrs. after shot _____

Gas _____ Cu. Ft.

Dry Hole _____

Abandoned _____


Date

5/19, 1917, Crocker Scout

Map No. _____ Sec. 9 Twp. 26 R. 5

Well No. 2 Pingrey Farm _____
Yellow Pine Company _____

NORTH

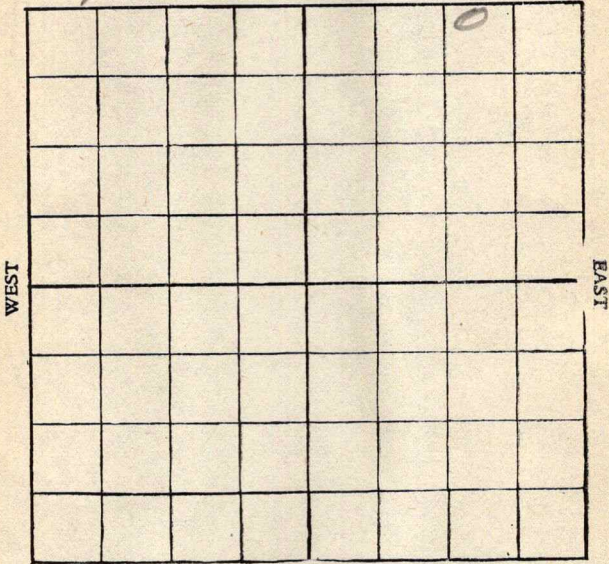

SOUTH

Location _____
Rig up _____
Drilling and remarks:

Rig

RECORD

Cased _____ in. _____ Ft.
Sand _____
Gas _____
Oil _____
Total Depth _____

PRODUCTION

1st 24 hrs. Nat. _____
1st 24 hrs. after shot _____
Gas _____ Cu. Ft.
Dry Hole _____
Abandoned _____

Date 7/26 1917, Crocker Scout

Map No. _____ Sec. 9 Twp. 26 R. 5
 Well No. 2 Ringrey Farm _____
Yellow Pine Company _____
 NORTH

WEST									EAST
SOUTH									

Location _____
 Rig Up _____
 Drilling and remarks _____

Rig

RECORD

Cased _____ in. _____ Ft.
 Sand _____
 Gas _____
 Oil _____
 Total Depth _____

PRODUCTION

1st 24 hrs. Nat. _____
 1st 24 hrs. after shot _____
 Gas _____ Cu. Ft.
 Dry Hole _____
 Abandoned _____

Date _____

6/2 191 7 Crocker Scout

Map No. _____ Sec. 9 Twp. 26 R. 5

Well No. 2 Pingrey Farm _____

Yellow Pine Company _____

NORTH

						<u>0</u>	

WEST

EAST

SOUTH

Location _____

Rig up _____

Drilling and remarks:

Rig.

RECORD

Cased _____ in. _____ Ft.

Sand _____

Gas _____

Oil _____

Total Depth _____

PRODUCTION

1st 24 hrs. Nat. _____

1st 24 hrs. after shot _____

Gas _____ Cu. Ft.

Dry Hole _____

Abandoned _____

Date


JUN 9 - 1917, 191. _____

C. J. Crocker Scout

Map No. _____ Sec. 9 Twp. 26 R. 5Well No. 2 Pingrey Farm _____Yellow Pine Company _____

NORTH

WEST

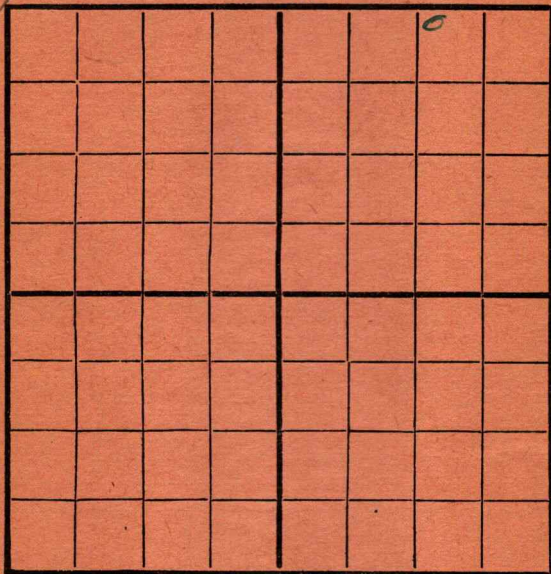

EAST

SOUTH

Location _____

Rig Up _____

Drilling and remarks _____

RECORD

Cased _____ in. _____ Ft.

Sand _____

Gas _____

Oil _____

Total Depth _____

PRODUCTION

1st 24 hrs. Nat. _____

1st 24 hrs. after shot _____

Gas _____ Cu. Ft.

Dry Hole _____


Abandoned _____

Date

JUN 16 1917 191 _____ Scout

Map No. _____ Sec. 9 Twp. 26 R. 3

Well No. 2 Piney Farm
Yellow Pine Company

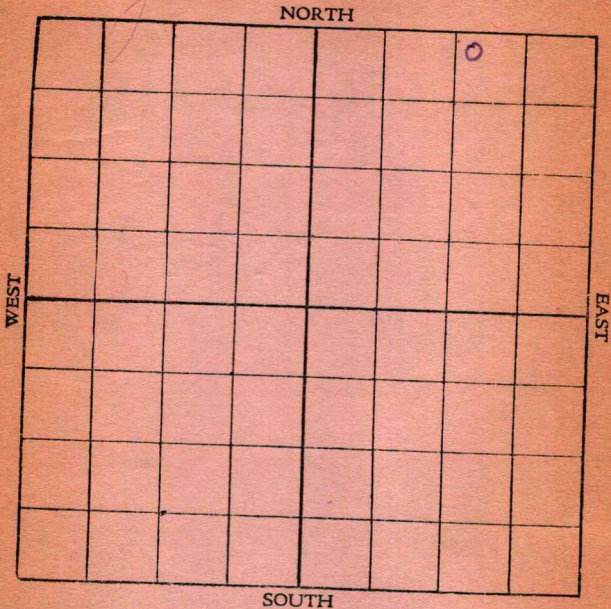

Location _____

Rig up _____

Drilling and remarks:

Rig

RECORD

Cased _____ in. _____ Ft.

Sand _____

Gas _____

Oil _____

Total Depth _____

PRODUCTION

1st 24 hrs. Nat. _____

1st 24 hrs. after shot _____

Gas _____ Cu. Ft.

Dry Hole _____

Abandoned _____

Date

JUN 22 1917

G. T. Crocker

, 191

Scout

Map No. _____ Sec. 9 Twp. 26 R. 5Well No. 2 Pingrey Farm _____Yellow Pine Company _____

NORTH

						0	

SOUTH

Location _____

Rig up ☒ _____

Drilling and remarks:

RECORD

Cased _____ in. _____ Ft.

Sand _____

Gas _____

Oil _____

Total Depth _____

PRODUCTION

1st 24 hrs. Nat. _____

1st 24 hrs. after shot _____

Gas _____ Cu. Ft.

Dry Hole _____

Abandoned _____

Date JUN 30 1917

, 191

C. J. Crocker Scout

Map No. _____ Sec. 9 Twp. 26 R. 5

Well No. 2 Pingrey Farm
Yellow Pine Company

NORTH

						0	

WEST

EAST

SOUTH

Location _____

Rig up ☒

Drilling and remarks:

RECORD

Cased _____ in. _____ Ft.

Sand _____

Gas _____

Oil _____

Total Depth _____

PRODUCTION

1st 24 hrs. Nat. _____

1st 24 hrs. after shot _____

Gas _____ Cu. Ft.

Dry Hole _____

Abandoned _____

Date JUL 7 1917

, 191

Scout

Map No. _____ Sec. 9 Twp. 26 R. 5Well No. 2 Pingrey Farm _____Yellow Pine Company _____

NORTH

WEST

EAST

SOUTH

Location _____

Rig up _____

Drilling and remarks:

RECORD

Cased _____ in. _____ Ft.

Sand _____

Gas _____

Oil _____

Total Depth _____

PRODUCTION

1st 24 hrs. Nat. _____

1st 24 hrs. after shot _____

Gas _____ Cu. Ft.

Dry Hole _____

Abandoned _____

Date

JUL 14 1917

, 191


E. T. Crocker

Scout

Map No. _____ Sec. 9 Twp. 26 R. 5Well No. 2 Pinegrey Farm _____
Yellow Pine Company _____

NORTH

WEST

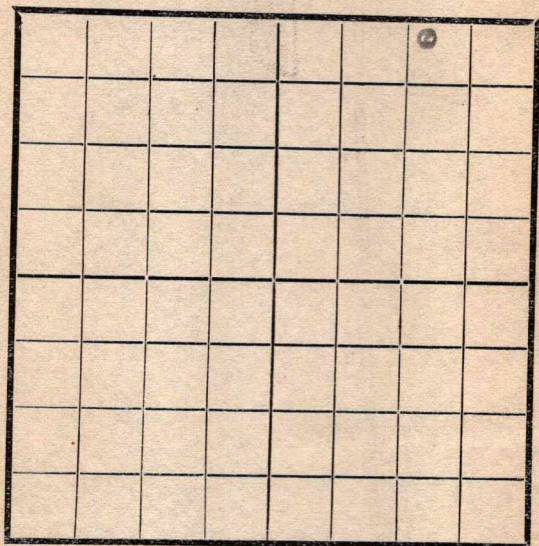

EAST

SOUTH

Location _____

Rig Up _____

Drilling and remarks

1125'

RECORD

Cased _____ in. _____ Ft.

Sand _____

Gas _____

Oil _____

Total Depth _____

PRODUCTION

1st 24 hrs. Nat. _____

1st 24 hrs. after shot _____

Gas _____ Cu. Ft.

Dry Hole _____

Abandoned _____


Date

8/9, 1917 Conley Scout

Map No. _____ Sec. 9 Twp. 26 R. 5
 Well No. 2. Pringle Fa
Yellow Pine Compa

NORTH

WEST

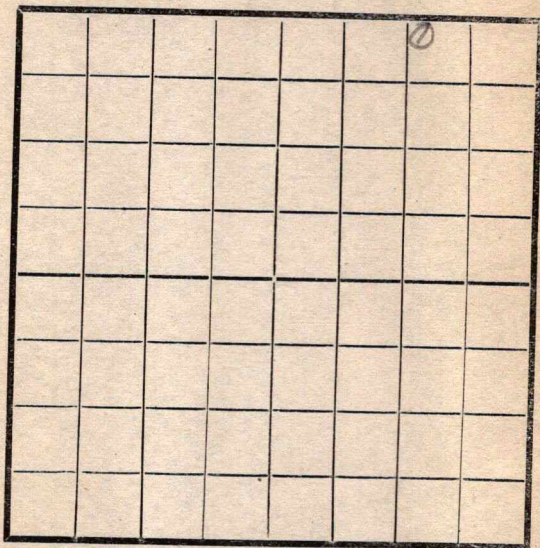

EAST

SOUTH

Location _____

Rig Up _____

Drilling and remarks

S. W. 1925.

RECORD

Cased _____ in. _____ Ft.

Sand _____

Gas _____

Oil _____

Total Depth _____

PRODUCTION

1st 24 hrs. Nat. _____

1st 24 hrs. after shot _____

Gas _____ Cu. Ft.

Dry Hole _____

Abandoned _____

Date


_____, 191____ Scout

Map No. _____ Sec. 7 Twp. 26 R. 5

Well No. 2 Pingrey Farm _____

Yellow Pine Company _____

NORTH

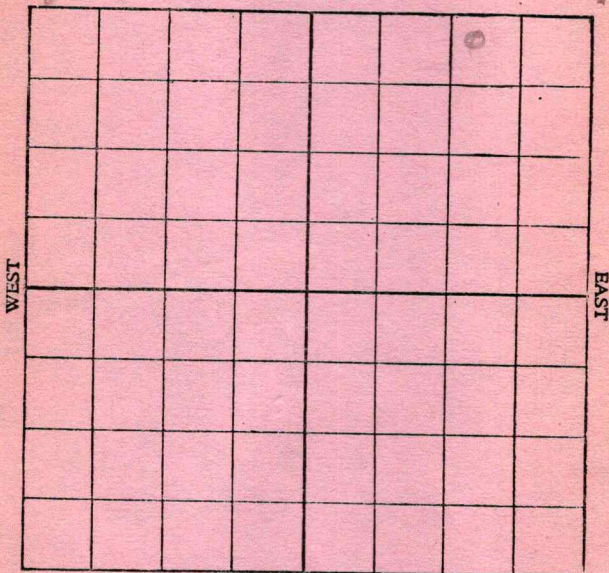

SOUTH

Location _____

Rig up _____

Drilling and remarks:

shot down
2300

RECORD

Cased _____ in. _____ Ft.

Sand _____

Gas _____

Oil _____

Total Depth _____

PRODUCTION

1st 24 hrs. Nat. _____

1st 24 hrs. after shot _____

Gas _____ Cu. Ft.

Dry Hole _____

Abandoned _____


Date

10/9, 1912, 2, 2, 2 Scout

Map No. _____ Sec. 9 Twp. 26 R. 5Well No. 2 Ringress Farm _____
Yellow Pine Company

NORTH

WEST

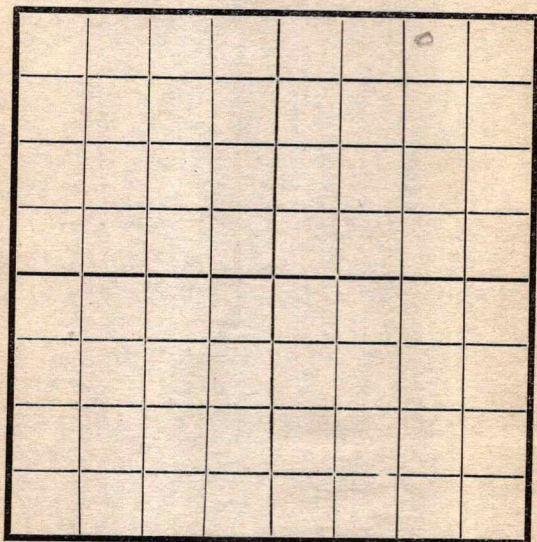

EAST

SOUTH

Location _____

Rig Up _____

Drilling and remarks

2609'

RECORD

Cased _____ in. _____ Ft.

Sand 2546-2570) Dry

Gas _____

Oil _____

Total Depth _____

PRODUCTION

1st 24 hrs. Nat. _____

1st 24 hrs. after shot _____

Gas _____ Cu. Ft.

Dry Hole _____

Abandoned _____

Date

10/17, 1917 Candey Scout


21004

Map No. K14 Sec. 9 Twp. 26 R. 5

Well No. 2 Primary Farm
Yellow Pine Company

NORTH

WEST

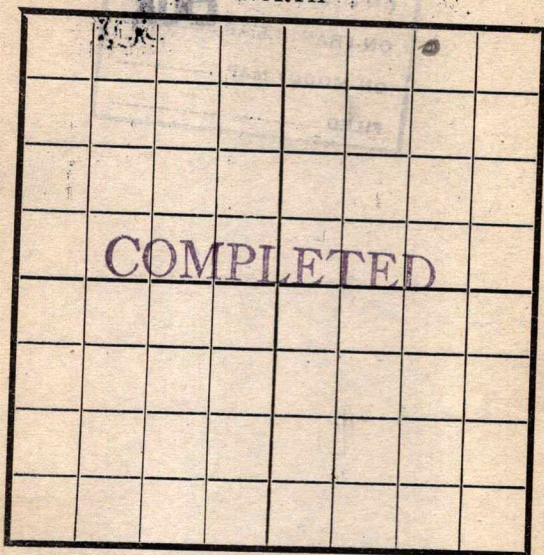

EAST

SOUTH

Location -----

Rig Up -----

Drilling and remarks

*Est at
50 Bbls*

RECORD

Cased ----- in. ----- Ft.

Sand 2546-2609

Gas -----

Oil -----

Total Depth -----

PRODUCTION

1st 24 hrs. Nat. -----

1st 24 hrs. after shot -----

Gas ----- Cu. Ft.

Dry Hole -----

Abandoned -----

Date

10/24 191 7 Candiff Scout