


Section 16
~~15~~ Township 26 Range 5-E
Well No. #2 Baker
Company Thrifty Drlg Carl Hines

NORTH

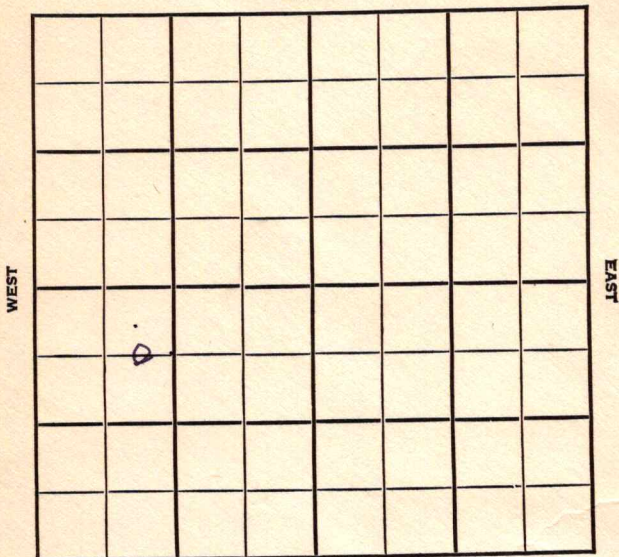

SOUTH

O.W.W.O. KANSAS

Butler

Sec. 15 Twp. 26 R. 5E

Well No. #2 Baker Farm

~~Thrifty Drlg.~~ Carl Hines Company


Miscellaneous

660' Ft. from N. Line

_____ Ft. from S. Line

_____ Ft. from E. Line

990' Ft. from W. Line

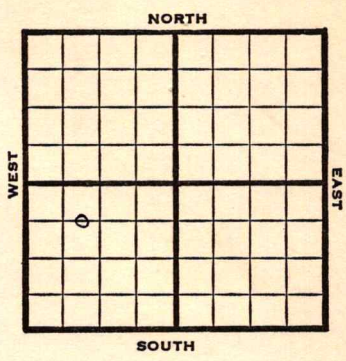

C E L NW SW

1948		REPORT
Eli 1336'		
7/14	Location	
7/21	"	
7/28	"	
8/4	"	
8/11	8"@ 79' Arbuckle 2391-95' TD 2395' 5"@ 2391'	
8/18	"	
8/25	"	
9/1	"	
9/8	"	
9/14	"	
9/21	"	
9/29	77' of 4" liner	
10/6	"	
10/13	"	
10/19	"	
10/27	TD 2395' Arb. 2391' 5"@ 2391' Pump 20 oil Pot 38° Gr. Comp	

COMPLETED

OVER

1953
3/25

O.W.W.O.

Lans. 1600' Arb. 2391'

OTD 2395' 5" @ 2391 Sq perf.

4/1

Oil well TD 2395 Lans. 1600'
Arb. 2391' OTD 2395 5" @ 2391
Sq. hole in pipe instead of perf.
Comp. in same zone

COMPLETED

Map No. _____ Sec. 15 Twp. 26 R. 5E

Well No. 2 Baker

Thrifty Drlg. Company

FIRST REPORT

Contractor

C E L N W S W

SECTION PLAT

660 Ft. from N. Line

_____ Ft. from S. Line

_____ Ft. from E. Line

990 Ft. from W. Line

o			

Butler County

Location X

Rig up _____

Drilling and Remarks:

RECORD

Cased _____ in., _____ ft.

Sand _____

Gas _____

Oil _____

Total Depth _____

PRODUCTION

1st 24 hrs. Nat. _____

1st 24 hrs. after shot _____

Gas _____ Cu. Ft.

Dry Hole _____

Abandoned _____

Date

JUL 14 1948

19

S. J. LEWIS

Scout

Butler County Kansas State

Map No. 14 Sec. 16 Twp. 26 R. 5E


Well No. 2 Baker

Thrifty Drlg. Company

CORRECTION Contractor

C E L NW SW

SECTION PLAT

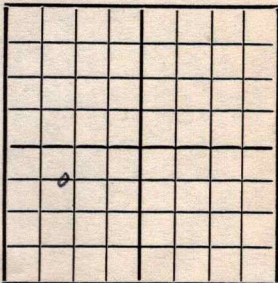

660 Ft. from N. Line

 Ft. from S. Line

 Ft. from E. Line

990 Ft. from W. Line

Miscellaneous

Remarks:

Reported 15-26-5E

Date

JUL 28 1948

Scout

S. J. LEWIS

Map No. 14 Sec. 16 Twp. 26 R. 5E

Well No. 2 Baker

Thrifty Drlg. Company

COMPLETE Contractor

C E L NW SW


E. 1336.
SECTION PLAT

660 Ft. from N. Line

_____ Ft. from S. Line

_____ Ft. from E. Line

990 Ft. from W. Line

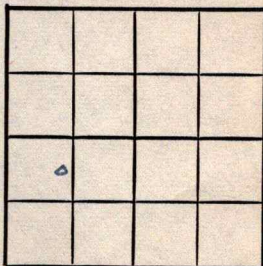

Butler County

Location _____

Rig up _____

Drilling and Remarks:

Ar X 2391

5" @ 2391

Prod 20 oil

88° by

RECORD

Cased _____ in., _____ ft.

Sand _____

Gas _____

Oil ☒

Total Depth 2395

PRODUCTION

1st 24 hrs. Nat. _____

1st 24 hrs. after shot _____

Gas _____ Cu. Ft.

Dry Hole _____

Abandoned _____

Date

OCT 27 1948

19

S. J. LEWIS

Scout

O.W.W.O.

County **Butler** State **Kansas**
Sec. **16** (Blk.) **26** (Sur.) **5E** Map No.

Operator **Carl Hines**

Well No. **2** Farm **Baker**

Elev. **1336** Location **C E L NW SW**

660 Ft. From **N** Line **SW**

990 Ft. From **W** Line **Quarter**

1st. Report **MAR 25 1953**

Completion

Remarks

O.W.W.O.

Spudding Date

Drig. Data

Lans. 1600 Arb. 2391 OTD 2395

5" @ 2391 sq perf.

O.W.W.O.

J. G. McGEHEE

J. G. McGEHEE