


Map No. _____ Sec. 16 Twp. 26 R. 5
Well No. 2 Baker Farm
Primer Co & G Company

N

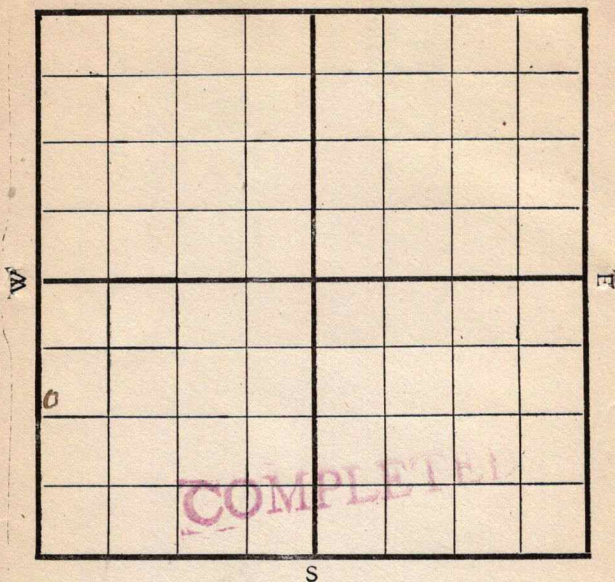

Location -----

Drilling Remarks:

Rig Up -----

Drilling Remarks:

RECORD

Cased ----- in.-----ft.

Sand -----

Gas _____

Oil _____

Total Depth-----

PRODUCTION

1st 24 hrs. Nat.-----

1st 24 hrs. after shot-----

Gas ----- cu. ft.


Dry Hole -----

Abandoned -----

Map No. 12 Sec. 16 Twp. 26 R. 5

Well No. 2 Baker Farm
Primer O & G Company

1120 Ft. from N. Line
____ Ft. from S. Line
____ Ft. from E. Line
200 Ft. from W. Line

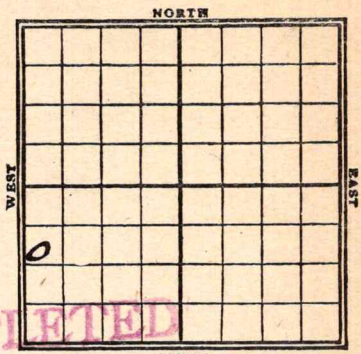

Date
6/6
8/10

REPORT
Rig up.
140 bbls. 2402-40

FIRST REPORT

Map No. 21004 K14 Sec. 16 Twp. 26 R. 5
 Well No. 2 Baker
Grainger Oil Company
 Contractor

SECTION PLAT

1120 Ft. from N. Line

_____ Ft. from S. Line

_____ Ft. from E. Line

200 Ft. from W. Line

Location _____

Rig up ☒

Drilling and Remarks:

RECORD

Cased _____ in., _____ ft.

Sand _____

Gas _____

Oil _____

Total Depth _____

PRODUCTION

1st 24 hrs. Nat. _____

1st 24 hrs. after shot _____

Gas _____ Cu. Ft.

Dry Hole _____

Abandoned _____

Date

6/16 19120

Pyle Scout

L-1004 K 14 Kansas
State _____ County _____
Sec. 16 Twp. 26 N-S; Rge. 5 E-W
Well No. 2 Baker Farm
Prairie Company

NORTH

COMPLETED

WEST

EAST

SOUTH

1120 N 200 W
Location _____ Cased _____ in. _____ ft.
Rig up _____ Mach. _____ Productive Horizons
From _____ To _____
Drilling at _____ 2402 - 40
Fishing at _____
U. R. to _____
S. D. at _____
Natural production 140 Bbls. per 24 hours
Pumping _____ Gas _____ Cu. ft. per 24 hours
Gauge press. _____ lbs. Total depth _____
Were samples collected _____
Remarks:

Pyle