Range: 4 W
Township: 23 S
Section: 12

RENO.
County

J. H. TETEN. No. 2.
Farm

TRANSWESTERN OIL CO.
Company

Sec.

		o	

Twp.

6	5	4	3	2	1
7	8	9	10	11	X
18	17	16	15	14	13
19	20	21	22	23	24
30	29	28	27	26	25
31	32	33	34	35	36

SWc NE

Elev. 1492 T.D. 3430'

Date Drilled 1-14-38

Correlation by
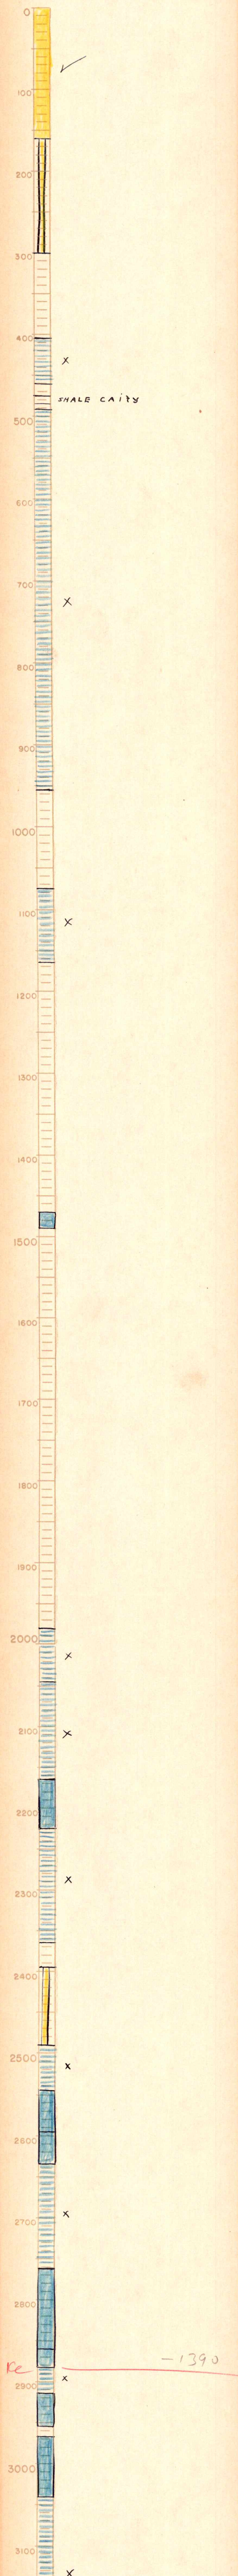
PROD. POZ. 1651 B.