

CompuCell (C) 1990 Company

NORTH

WEST

EAST

SOUTH

Location _____

Drilling Remarks

Rig Up _____

Drilling Remarks

RECORD

Cased _____ in. _____ ft.

Sand _____

Gas _____

Oil _____

Total Depth_____

PRODUCTION

1st 24 hrs. Nat. _____

1st 24 hrs. after shot_____


Gas_____cu. ft._____

Dry Hole_____

Abandoned _____

Greenwood
 Map No. KANSAS Sec. 9 Twp. 25 R. 13
 Well No. 7- Hoggatt Farm
Empire Oil Co. Company

NORTH

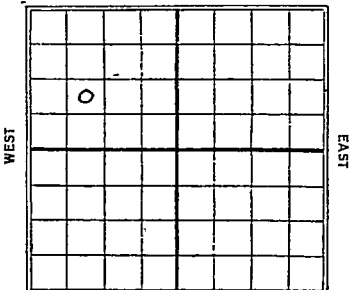

Ft. from N. Line

1070 Ft. from S. Line

Ft. from E. Line

1070 Ft. from W. Line

SOUTH

Date

REPORT

12/30	Machine
1/30	
1/8	Spdg.
1/15	Shut down
1/22	SD 140'
1/29	
2/4	
2/11	Spdg. 145'
2/19	Spdg. 800'
2/26	Top Sand 1453'
	Run 6"
3/5	Sand 1457-70'
	T.D. 1473
	40 bbls oil
	Comp.

Islewood

Map No. **KANSAS** Sec. **9** Twp. **25** R. **13^E**
 Well No. **7** **Haggatt**
Empire Drilling Co Company
 Contractor

FIRST REPORTS

Ft. from N. Line

1070 Ft. from S. Line

Ft. from E. Line

1070 Ft. from W. Line

SECTION PLAT

0			

Location **22**Rig up **Machine**

Drilling and Remarks:

RECORD

Cased.....in.,ft.

Sand.....

Gas.....

Oil.....

Total Depth.....

PRODUCTION

1st 24 hrs. Nat.....

1st 24 hrs. after shot.....

Gas.....Cu. Ft.

Dry Hole.....

Abandoned.....

Date

DEC 30 1929

192

CHAS. L. SHERWOOD

Scout

Greenwood

17 KANSAS Map No. Sec. 9 Twp. 25 R. 13

Well No. 7 Haggatt

Empire Oil Co. Company

Contractor

COMPLETE

SECTION PLAT

.....Ft. from N. Line

1070 Ft. from S. Line

.....Ft. from E. Line

1070 Ft. from W. Line

0			

Location.....

Rig up.....

Drilling and Remarks:

40 Bl.

RECORD

Cased.....in.,ft.

Sand 1457-1470

Gas.....

Oil.....

Total Depth 1473

PRODUCTION

1st 24 hrs. Nat.....

1st 24 hrs. after shot.....

Gas.....Cu. Ft.

Dry Hole.....

Abandoned.....

Date

MAR 5 1930 CHAS. L. SHERWOOD Scout