

NORTH

WEST

EAST

SOUTH

Drilling Remarks

Drilling Remarks

Cased_____in. _____ft.

Sand _____

Gas -----

Oil _____

Total Depth_____

1st 24 hrs. Nat. _____

1st 24 hrs. after shot_____

Gas _____ cu. ft.

Dry Hole_____

Abandoned _____

Map No. _____ Sec. 9 Twp. 25 R. 13
 Well No. 1 - Palston Farm _____
Bisango et al Company _____


NORTH

_____ Ft. from N. Line

250 Ft. from S. Line250 Ft. from E. Line

_____ Ft. from W. Line

WEST

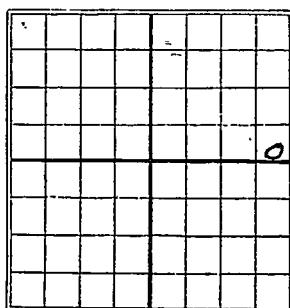

EAST

SOUTH

1927

Date

REPORT

8/3 Location8/10 Drilg 5608/18 " 750'8/24 Sand 1445-85 dry
Top line 1570 - Drilg 1600-9/1 T.D. 1620 - P.B. to 1472
shot 60 gts - swabbing
all water with small
showing of oil -9/7 Sand 1445-1485

Top line 1570

T.D. 1620 P.B. to
1472 60 gts/5 bbls
Show and H.P.W.

Chas L Sherwood
KANSAS
 Map No. _____ Sec. *9* Twp. *25* R. *13*
 Well No. *1 Halston*
Disagno at 92 _____ Company _____
 _____ Contractor _____

FIRST REPORTS

_____ Ft. from N. Line
250 _____ Ft. from S. Line
250 _____ Ft. from E. Line
 _____ Ft. from W. Line

SECTION PLAT

			o

Location ☒ _____
 Rig up _____
 Drilling and Remarks:

RECORD

Cased _____ in., _____ ft.
 Sand _____
 Gas _____
 Oil _____
 Total Depth _____

PRODUCTION

1st 24 hrs. Nat. _____
 1st 24 hrs. after shot _____
 Gas _____ Cu. Ft.
 Dry Hole _____
 Abandoned _____

Date

AUG 3 1927

CHAS. L. SHERWOOD

192

Scout

no map **KANSAS** *Shawnee*
 Map No. _____ Sec. *9* Twp. *25* R. *13*
 Well No. *1 Kalston*
Bisuzgo et al _____ Company
 _____ Contractor

COMPLETED

SECTION PLAT

_____ Ft. from N. Line
250 _____ Ft. from S. Line
250 _____ Ft. from E. Line
 _____ Ft. from W. Line

			0

ABANDONED

Location _____

Rig up _____

Drilling and Remarks:

Song 1445-1485
Top line 1570
TD 1620 1 Bl
1472' 64y. 5 Bl
Show 2 Hw

RECORD

Cased _____ in., _____ ft.
 Sand _____
 Gas _____
 Oil _____
 Total Depth *1620*

PRODUCTION

1st 24 hrs. Nat. _____
 1st 24 hrs. after shot _____
 Gas _____ Cu. Ft.
 Dry Hole ☒
 Abandoned ☒

Date

SEP 7 - 1927

CHAS. L. SHERWOOD

192

Scout