

-----Caldwell----- Company

WEST

EAST

SOUTH

Rig Up -----

Drilling Remarks:

PRODUCTION

1st 24 hrs. Nat.-----

1st 24 hrs. after shot_-----

Gas----- cu. ft

Dry Hole -----

Abandoned -----

Butler

KANSAS

Sec. 24 Twp. 26 R. 5E

Well No. #1 #1 H. Holem Farm

Caldwell

G. D. Smitherman Company

Contractor


Ft. from N. Line

330' Ft. from S. Line

330' Ft. from E. Line

Ft. from W. Line

SE SE NE

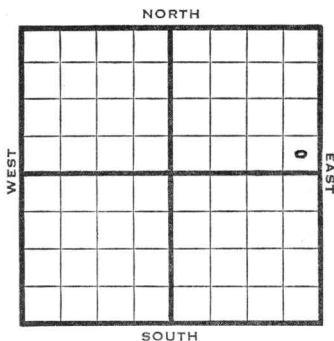

1950

?

REPORT

8/23

5" @ 2676'

O.W.W.O.

Bart 2676-2688 TD

P/21 BOPD

8/30

10 3/4" @ 90

Bart 2676-2688

5" @ 2676

TD 2688

Comp 21 bopd

Completed

COMPLETED


1004 K14
Map No. _____ Sec. 24 Twp. 26 R. 5Well No. 2 HalymCaldwell _____ Company

_____ Contractor

NORTH

WEST

EAST

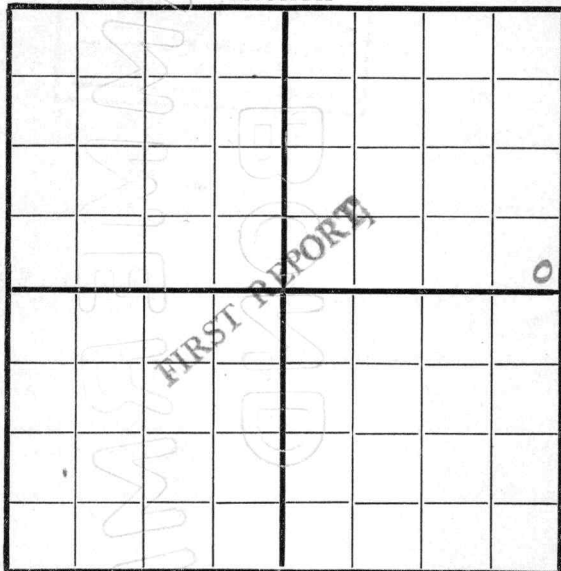

SOUTH

Location _____

Rig up _____

Drilling and Remarks:

RECORD

Cased _____ in., _____ ft.

Sand _____

Gas _____

Oil _____

Total Depth _____

PRODUCTION

1st 24 hrs. Nat. _____

1st 24 hrs. after shot _____

Gas _____ Cu. Ft.

Dry Hole _____

Abandoned _____

Date

8/6 1918 J. L. Scout Scout

Map No. _____ Sec. 24 Twp. 26 R. 5Well No. 2 HolmCaldwell


Company _____

Contractor _____

NORTH

WEST

EAST

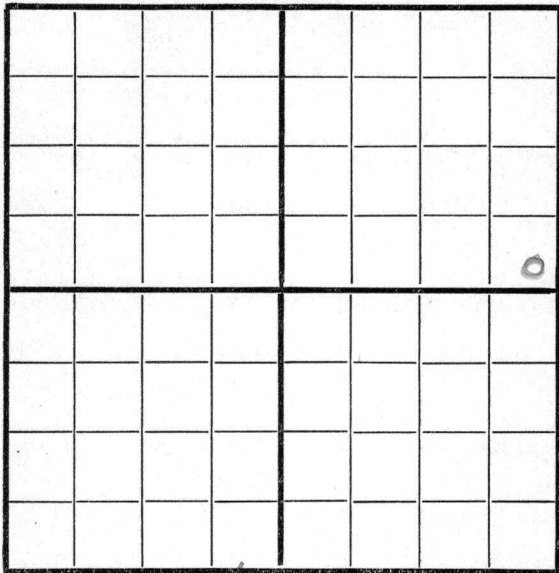

SOUTH

250 E 8

Location _____

Rig up ☒

Drilling and Remarks:

RECORD

Cased _____ in., _____ ft.

Sand _____

Gas _____

Oil _____

Total Depth _____

PRODUCTION

1st 24 hrs. Nat. _____

1st 24 hrs. after shot _____

Gas _____ Cu. Ft.


Dry Hole _____

Abandoned _____

Date

7/13191Scout

Map No. _____ Sec. 24 Twp. 26 R. 5
Well No. 2 Holmes
Caldwell Company _____
Contractor _____

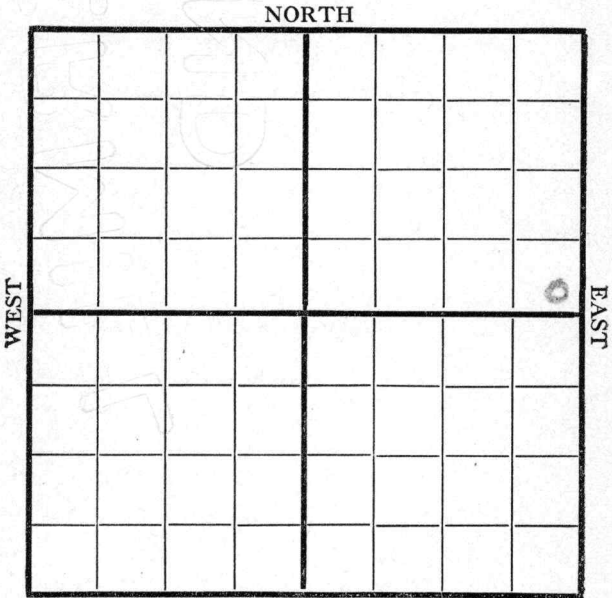

250' SSE

Location _____

Rig up ☒ _____

Drilling and Remarks:

RECORD

Cased _____ in., _____ ft.

Sand _____

Gas _____

Oil _____

Total Depth _____

PRODUCTION

1st 24 hrs. Nat. _____

1st 24 hrs. after shot _____

Gas _____ Cu. Ft.

Dry Hole _____

Abandoned _____


Date 8/22 1918 Ryle Scout

Map No. K 14 Sec. 24 Twp. 26^S R. 5^EWell No. 2 HolmesJ. P. Q. Caldwell Company

Contractor

NORTH

WEST

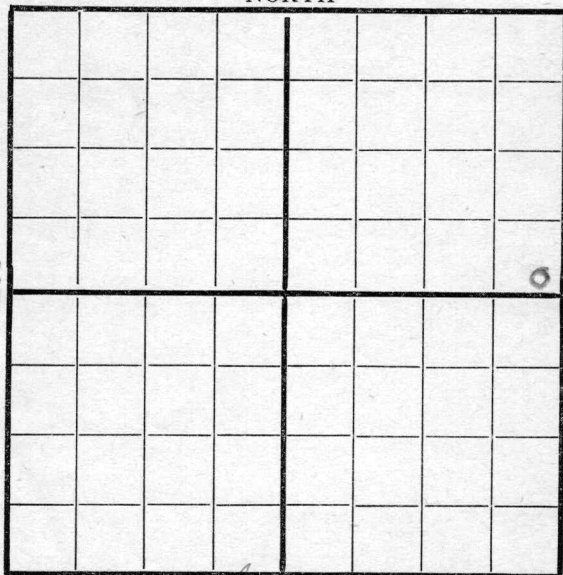

EAST

SOUTH

Location

250 N
250 W

Rig up

Drilling and Remarks:

RECORD

Cased _____ in., _____ ft.

Sand _____

Gas _____

Oil _____

Total Depth _____

PRODUCTION

1st 24 hrs. Nat. _____

1st 24 hrs. after shot _____

Gas _____ Cu. Ft.

Dry Hole _____

Abandoned _____

Date

7
29

191

8

Pyle

Scout


Map No. K14 Sec. 24 Twp. 26 R. 5Well No. 2 Hole
J. G. G. Caldwell Company

Contractor

NORTH

WEST

EAST

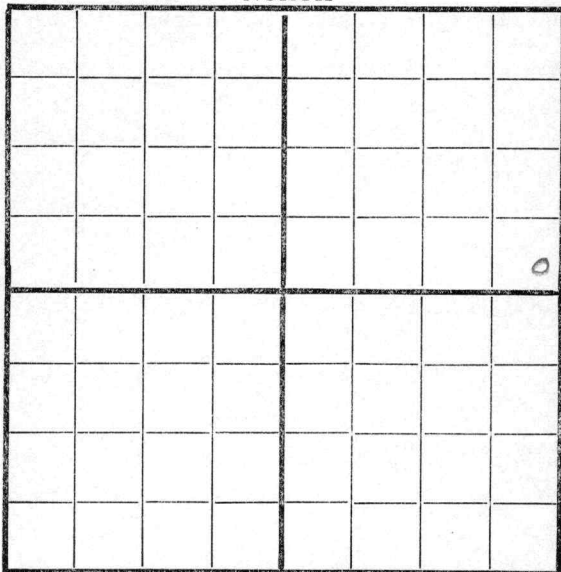

SOUTH

Location _____

Rig up _____

Drilling and Remarks:

250 S 8 ESpudding

RECORD

Cased _____ in., _____ ft.

Sand _____

Gas _____

Oil _____

Total Depth _____

PRODUCTION

1st 24 hrs. Nat. _____

1st 24 hrs. after shot _____

Gas _____ Cu. Ft.

Dry Hole _____

Abandoned _____

Date

9/3

191

8Pyle

Scout


Map No. 1514 Sec. 24 Twp. 26 R. 5Well No. 2 HolmesJ. B. Caldwell Company

Contractor

NORTH

WEST

EAST

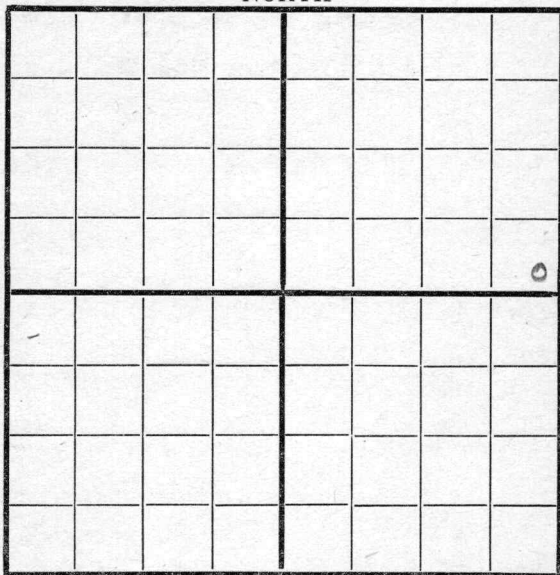

SOUTH

Location 250 } 01E

Rig up _____

Drilling and Remarks:

400'

RECORD

Cased _____ in., _____ ft.

Sand _____

Gas _____

Oil _____

Total Depth _____

PRODUCTION

1st 24 hrs. Nat. _____

1st 24 hrs. after shot _____

Gas _____ Cu. Ft.

Dry Hole _____

Abandoned _____


Date

9/11 1918Pyle

Scout

Map No. K14 Sec. 24 Twp. 26 R. 5Well No. 2 Holm
J. P. G. Caldwell Company

Contractor

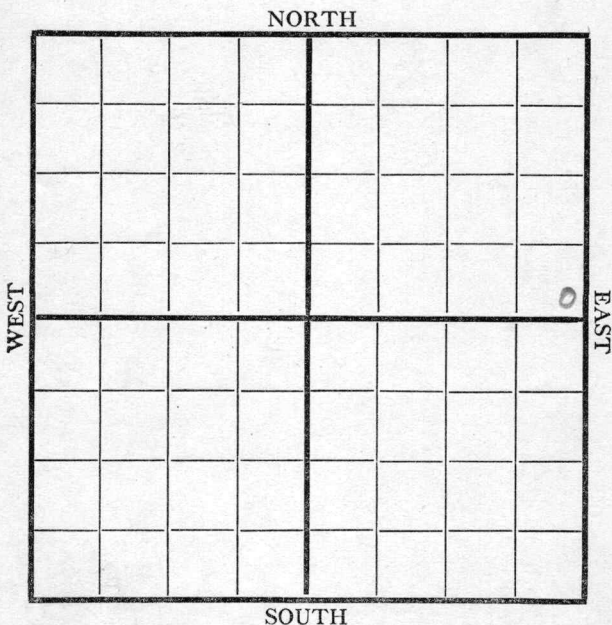Location 250' S-E

Rig up _____

Drilling and Remarks:

1500'

RECORD

Cased _____ in., _____ ft.

Sand _____

Gas _____

Oil _____

Total Depth _____

PRODUCTION

1st 24 hrs. Nat. _____

1st 24 hrs. after shot _____

Gas _____ Cu. Ft.

Dry Hole _____

Abandoned _____

Date

9/251918Pyie


Scout

Map No. K 14 Sec. 24 Twp. 26 R. 5Well No. 2 Holm
J. P. G. Caldwell Company
Contractor

NORTH

WEST

EAST

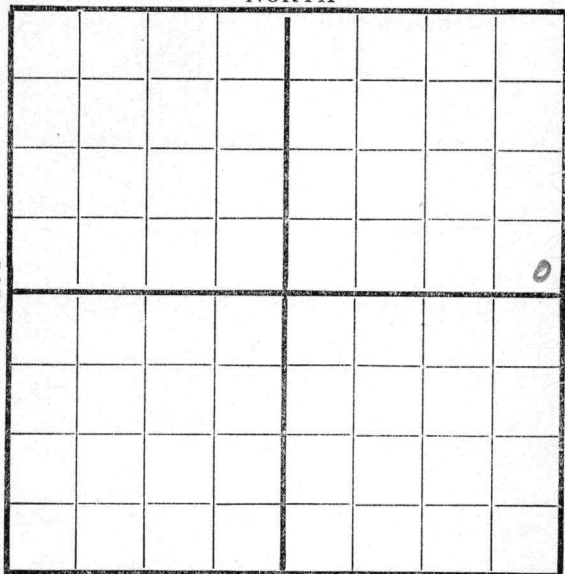

SOUTH

Location 250' S-E

Rig up _____

Drilling and Remarks:

2400'

RECORD

Cased _____ in., _____ ft.

Sand _____

Gas _____

Oil _____

Total Depth _____

PRODUCTION

1st 24 hrs. Nat. _____

1st 24 hrs. after shot _____

Gas _____ Cu. Ft.

Dry Hole _____

Abandoned _____

Date

10/2
 1918

Pyle

Scout

Map No. N 14 Sec. 24 Twp. 26 R. 5

Well No. 2 Holmes
J. P. G. Caldwell Company
 Contractor

NORTH							
WEST							
SOUTH							

Location 250' S-E

Rig up

Drilling and Remarks:

2500'

RECORD

Cased _____ in., _____ ft.

Sand _____

Gas _____

Oil _____

Total Depth _____

PRODUCTION

1st 24 hrs. Nat. _____

1st 24 hrs. after shot _____

Gas _____ Cu. Ft.

Dry Hole _____

Abandoned _____

Date

10/8 1918 Pyle Scout

Map No. K14 Sec. 24 Twp. 26 R. 5
Well No. 2 Holm
J. J. G. Caldwell Company
Contractor

NORTH

WEST

EAST

SOUTH

Location 250 S. E

Rig up_____

Drilling and Remarks:

2660

RECORD

Cased _____ in., _____ ft.

Sand_____

Gas

Oil

Total Depth.....

PRODUCTION

1st 24 hrs. Nat. _____

1st 24 hrs. after shot-----

Gas.....Cu. Ft.

Dry Hole.....

Abandoned.....


Date _____

10/17 1918

Pyle

Scout

Map No. K14 Sec. 24 Twp. 26 R. 5
 Well No. 2 Holm
J. P. G. Caldwell Company
 Contractor

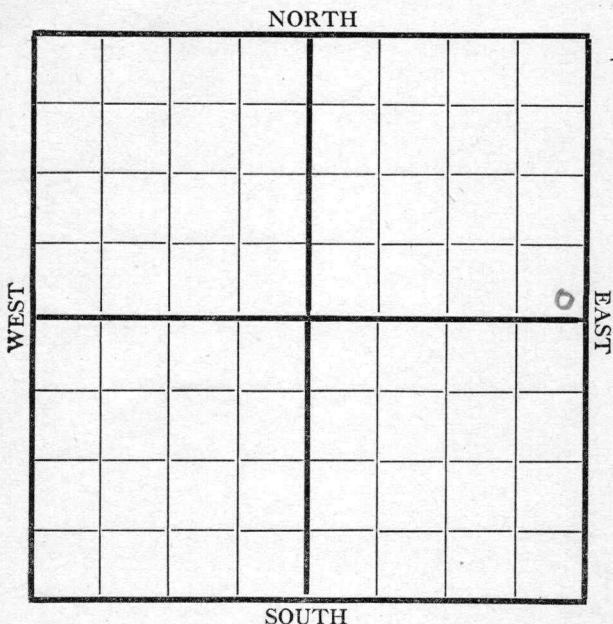

Location 250 S-E

Rig up _____

Drilling and Remarks:

No Refurb

RECORD

Cased _____ in., _____ ft.

Sand _____

Gas _____

Oil _____

Total Depth _____

PRODUCTION

1st 24 hrs. Nat. _____

1st 24 hrs. after shot _____

Gas _____ Cu. Ft.

Dry Hole _____

Abandoned _____

Date

10/1/24 191

Pyle

Scout


Map No. K14 Sec. 24 Twp. 24 R. 5Well No. 2 HolmJ. P. Q. Caldwell Company

Contractor

NORTH

WEST

EAST

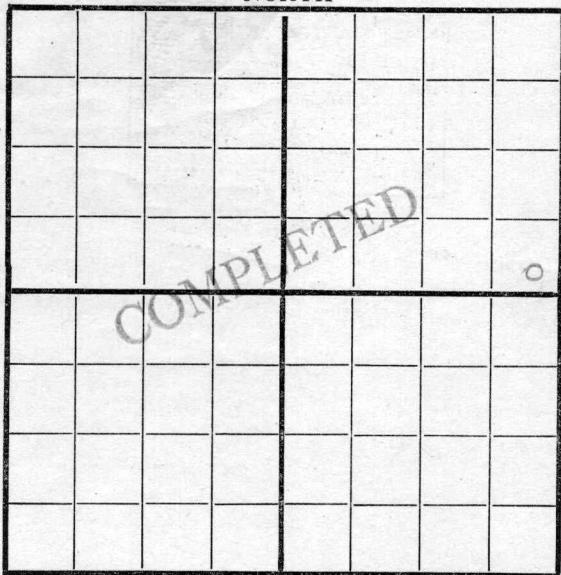

SOUTH

Location 250 S-E

Rig up

Drilling and Remarks:

RECORD

Cased _____ in., _____ ft.

Sand 2674 - 2681

Gas _____

Oil _____

Total Depth _____

PRODUCTION

1st 24 hrs: Nat. 100 bbls

1st 24 hrs. after shot _____

Gas _____ Cu. Ft.

Dry Hole _____

Abandoned _____

Date

11/5 191 8 C. J. L. Scout

O.W.W.O.

County Butler State KansasSec. 24 (Blk. Twp.) 26 (Sur. Rge.) 5E Map No.Operator G. D. SmithermanWell No. 1 Farm H. HolenElev. _____ Location SE SE NE old well old

330 Ft. From S Line NE330 Ft. From E Line Quarter1st. Report AUG 23 1950

Completion _____

Remarks _____


Spudding Date _____

Drlg. Data _____

5" @ 2676 Bart. 2676-2688 TD P/ 21 bopd

O W W O

J. E. TYRA

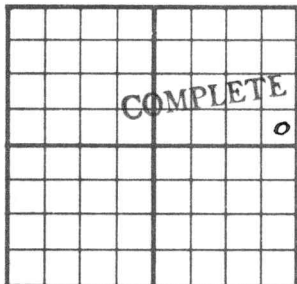County Butler State KansasSec. 24 (Blk.) 26 (Sur.) 5E Map No.Operator G. D. SmithermanWell No. 1 Farm H. HolemElev. _____ Location SE SE NE old wells330 Ft. From S Line NE330 Ft. From E Line Quarter

1st. Report _____

Completion AUG 30 '950

Remarks _____

Miscellaneous

Spudding Date _____

Drlg. Data Oil well TD 268810 3/4" @ 90 Bart. 2676-2688 5" @ 2676TD 2688 Comp. 21 bopd

J. E. TYRA