


Map No. _____ Sec. 16 Twp. 26 R. 5
 Well No. 5 Kiser (Kaiser) Farm
Empire Company
 NORTH

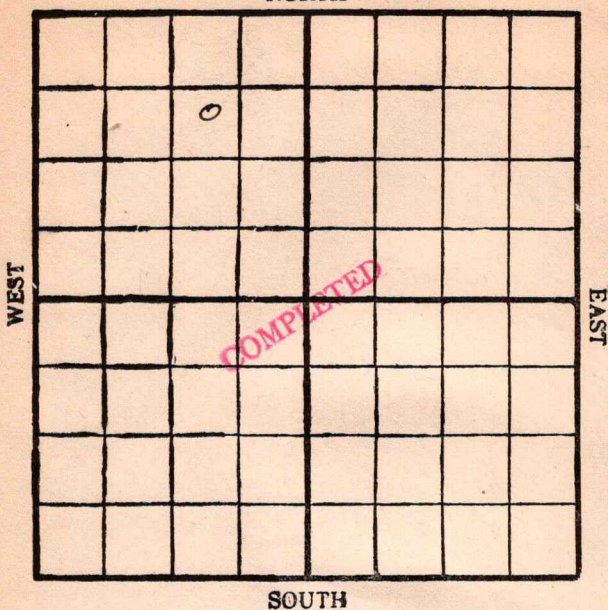

Location _____

Rig Up _____

Drilling Remarks:

Drilling Remarks:

RECORD

PRODUCTION

Cased _____ in. _____ ft.

1st 24 hrs. Nat. _____

Sand _____

1st 24 hrs. after shot _____

Gas _____

Gas _____ cu. ft.

Oil _____

Dry Hole _____

Total Depth _____

Abandoned _____

Map No. K 14 Sec. 16 Twp. 26 R. 5Well No. 5 KiserEmpire

Company

Contractor

NORTH

WEST

EAST

FIRST REPORT

SOUTH

990' N-E

Location _____

Rig up. ☒

Drilling and Remarks:

RECORD

Cased _____ in., _____ ft.

Sand _____

Gas _____

Oil _____

Total Depth _____

PRODUCTION

1st 24 hrs. Nat. _____

1st 24 hrs. after shot _____

Gas _____ Cu. Ft.

Dry Hole _____

Abandoned _____

Date

2/24191 9Oyle

Scout

Map No. K14 Sec. 16 Twp. 26 R. 5Well No. 5 KiserEmpire


Company

Contractor

NORTH

WEST

EAST

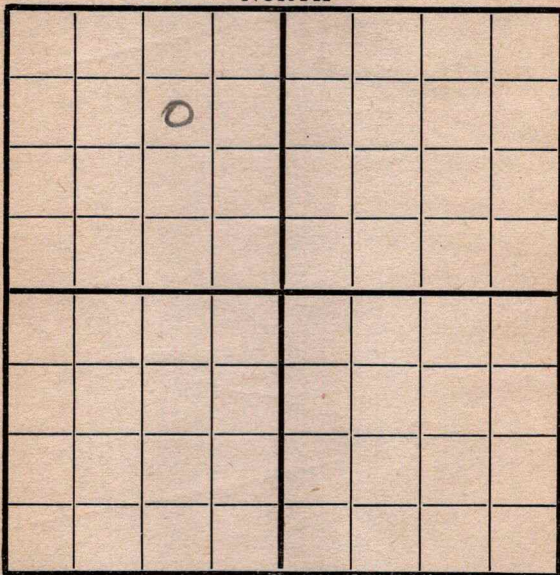

SOUTH

990 N-E

Location _____

Rig up ☒ _____

Drilling and Remarks:

RECORD

Cased _____ in., _____ ft.

Sand _____

Gas _____

Oil _____

Total Depth _____

PRODUCTION

1st 24 hrs. Nat. _____

1st 24 hrs. after shot _____

Gas _____ Cu. Ft.

Dry Hole _____

Abandoned _____

Date

3/8 1919

Pyle

Scout

Map No. K14 Sec. 16 Twp. 26 R. 5Well No. 5 KiserEmpire Company

Contractor

NORTH

WEST

EAST

COMPLETED

SOUTH

Location _____

Rig up _____

Drilling and Remarks:

50 bbls8 hours

RECORD

Cased _____ in., _____ ft.

Sand 2360-2470

Gas _____

Oil _____

Total Depth _____

PRODUCTION

1st 24 hrs. Nat. _____

1st 24 hrs. after shot _____

Gas _____ Cu. Ft.

Dry Hole _____

Abandoned _____

Date

5/9 1919Cyle Scout