

WEST

EAST

SOUTH

Rig Up.....

Drilling Remarks

RECORD

PRODUCTION

1st 24 hrs. Nat.....

1st 24 hrs. after shot.....

Gas. cu. ft.

Dry Hole.....

Abandoned.....

Greenwood

Map No. **KANSAS** Sec. *9* Twp. *25* R. *13*

Well No. *2* *Wattson* Farm

Bisagno et al Company


_____ Ft. from N. Line

250 Ft. from S. Line

_____ Ft. from E. Line

250 Ft. from W. Line

1929

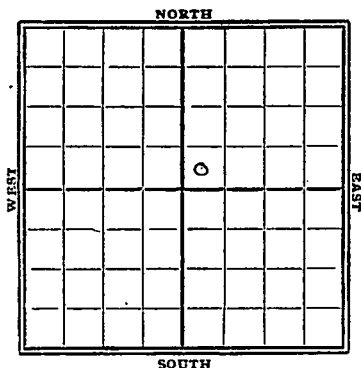

Date

REPORT

7/2 Location

7/10

7/17

7/24

7/31

Top sand 1520'
Only 1540'
150' oil in hole

8/7

sand 1520-35'

T.D. 1545'
shot 16 gts
20 bbls oil
Comp.

17 **KANSAS** Sec. 9 Twp. 75 R. 13
 Well No. 2 Ralston
 Bisagno & al Company
 Contractor

FIRST REPORTS

____ Ft. from N. Line

750 Ft. from S. Line

____ Ft. from E. Line

750 Ft. from W. Line

SECTION PLAT

		0	

Location ✓

Rig up _____

Drilling and Remarks:

RECORD

Cased _____ in., _____ ft.

Sand _____

Gas _____

Oil _____

Total Depth _____

PRODUCTION

1st 24 hrs. Nat. _____

1st 24 hrs. after shot _____

Gas _____ Cu. Ft.

Dry Hole _____

Abandoned _____

Date

7/21929

CHAS. L. SHERWOOD

Scout

G. Murray

Map No. KANSAS Sec. 9 Twp. 75 R. 13
 Well No. 172 Ralston
Bisagno et al Company
 Contractor

COMPLETE

SECTION PLAT

		0	

Ft. from N. Line

750 Ft. from S. Line

Ft. from E. Line

750 Ft. from W. Line

Location _____

Rig up _____

Drilling and Remarks:

16 / 20 Bl.

RECORD

Cased _____ in., _____ ft.

Sand 1520-35

Gas _____

Oil _____

Total Depth 1545

PRODUCTION

1st 24 hrs. Nat. _____

1st 24 hrs. after shot _____

Gas _____ Cu. Ft.

Dry Hole _____

Abandoned _____

Date

AUG 7

1929

CHAS. L. SHERWOOD

19

Scout