


KANSAS

Greenwood

Section 31 Township 25 Range 11-E

Well No. #8 Smith "D"

Company R E Smith

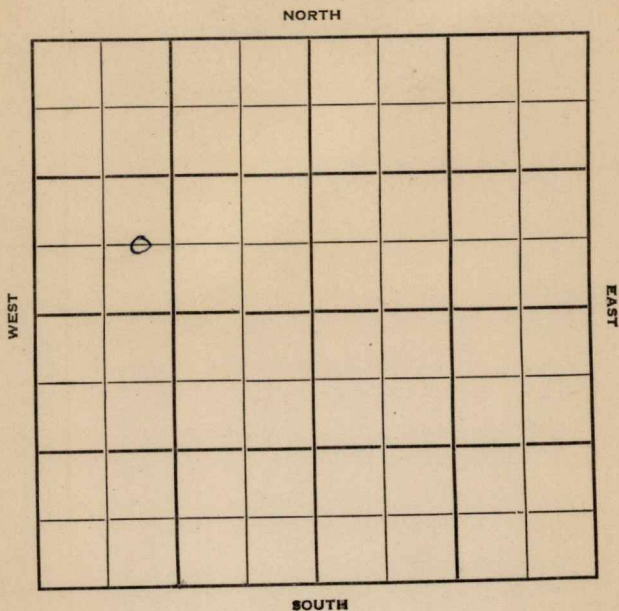

Greenwood

KANSAS

Sec. 31 Twp. 25 R. 11E ✓

Well No. #8 Smith "D" Farm

R. E. Smith Company

Contractor


         Ft. from N. Line

660' Ft. from S. Line

         Ft. from E. Line

990' Ft. from W. Line

C E L SW NW

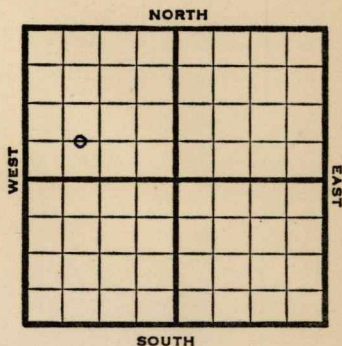

| 1950 | ? | REPORT                                                                                      |
|------|---|---------------------------------------------------------------------------------------------|
| 7/5  |   | Spud 6-29-50<br>8" @ 21<br>Drlg. 1715'                                                      |
| 7/12 |   | 8" @ 21<br>Miss 1960<br>5" @ 1977<br>750 acid<br>Comp 15 bopd<br>Completed<br><br>COMPLETED |
|      |   | Chat 1967-78                                                                                |

Map No. \_\_\_\_\_ Sec. 31 Twp. 25 R. 11E

Well No. 8 Smith "D"

R. E. Smith Company

Contractor

C E L SW NW

SECTION PLAT


\_\_\_\_\_ Ft. from N. Line

660 Ft. from S. Line

\_\_\_\_\_ Ft. from E. Line

990 Ft. from W. Line

Greenwood County

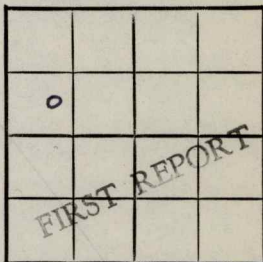

Location \_\_\_\_\_

Rig up \_\_\_\_\_

Drilling and Remarks:

Spud 6-29-50

8" @ 21

drlg. 1715

RECORD

Cased \_\_\_\_\_ in., \_\_\_\_\_ ft.

Sand \_\_\_\_\_

Gas \_\_\_\_\_

Oil \_\_\_\_\_

Total Depth \_\_\_\_\_

PRODUCTION

1st 24 hrs. Nat. \_\_\_\_\_

1st 24 hrs. after shot \_\_\_\_\_

Gas \_\_\_\_\_ Cu. Ft.

Dry Hole \_\_\_\_\_

Abandoned \_\_\_\_\_

Date

JUL 5 1950 19

J. E. TYRA Scout

Kansas

Map No. \_\_\_\_\_ Sec. 31 Twp. 25 R. 11EWell No. 8 Smith "D"

\_\_\_\_\_ R. E. Smith \_\_\_\_\_ Company

\_\_\_\_\_ Contractor


C E L SW NW

## SECTION PLAT

\_\_\_\_\_ Ft. from N. Line

660 Ft. from S. Line

\_\_\_\_\_ Ft. from E. Line

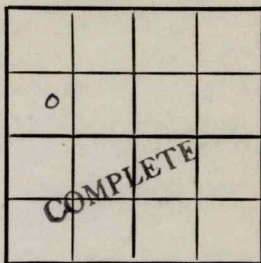990 Ft. from W. Line

Greenwood County

Location \_\_\_\_\_

Rig up \_\_\_\_\_

Drilling and Remarks:

8" @ 21

Miss. 1960

Chat 1967-78

5" @ 1977

750 acid

Comp. 15 bopd

## RECORD

Cased \_\_\_\_\_ in., \_\_\_\_\_ ft.

Sand \_\_\_\_\_

Gas \_\_\_\_\_

Oil \_\_\_\_\_

Total Depth 1978

## PRODUCTION

1st 24 hrs. Nat. \_\_\_\_\_

1st 24 hrs. after shot \_\_\_\_\_

Gas \_\_\_\_\_ Cu. Ft.

Dry Hole \_\_\_\_\_

Abandoned \_\_\_\_\_

Date

JUL 12 1950 19 J. E. TYRA Scout