


Map No. _____ Sec. 16 Twp. 26 R. 5
 Well No. 9 Kaiser Farm
Empire Company

NORTH

WEST

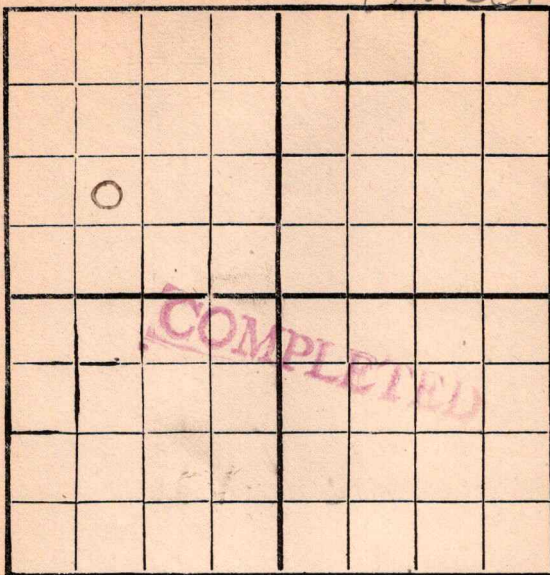

EAST

SOUTH

Location _____

Rig Up _____

Drilling Remarks:

Drilling Remarks:

RECORD

PRODUCTION

Cased _____ in. _____ ft.

1st 24 hrs. Nat. _____

Sand _____

1st 24 hrs. after shot _____

Gas _____

Gas _____ cu. ft.

Oil _____

Dry Hole _____

Total Depth _____

Abandoned _____

Map No. _____ Sec. 16 Twp. 26 R. 5Well No. 9. Tixer Farm _____Empire Gas Co Company _____


Contractor _____

NW. Quarter

_____ Ft. from N. Line

990 Ft. from S. Line

_____ Ft. from E. Line

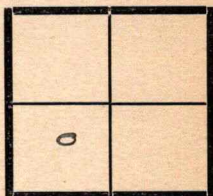990 Ft. from W. LineDate 7/11/11 REPORT10711 Riz.175 2410' - 52' 35 Bbl.

COMPLETED

Map No. _____ Sec. 16 Twp. 26 R. 5Well No. 9 Kiser


Company _____

Contractor _____

NORTH

WEST

EAST

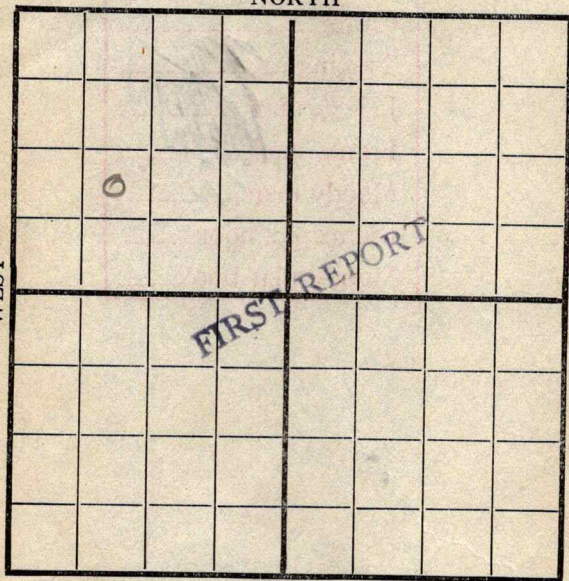

SOUTH

990 S.W.

Location _____

Rig up ☒

Drilling and Remarks:

RECORD

Cased _____ in., _____ ft.

Sand _____

Gas _____

Oil _____

Total Depth _____

PRODUCTION

1st 24 hrs. Nat. _____

1st 24 hrs. after shot _____

Gas _____ Cu. Ft.

Dry Hole _____

Abandoned _____

Date

7 191 9Pyle Scout

Map No. K14 Sec. 16 Twp. 26 R. 5Well No. 9 KiserEmpire Company

Contractor

SECTION PLAT

Ft. from N. Line

990 Ft. from S. Line

Ft. from E. Line

990 Ft. from W. Line

Location

Rig up

Drilling and Remarks:

RECORD

Cased _____ in. _____ ft.

Sand 2410 - 2452

Gas _____

Oil _____

Total Depth _____

PRODUCTION

1st 24 hrs. Nat. 35 bbl

1st 24 hrs. after shot _____

Gas _____ Cu. Ft.

Dry Hole _____

Abandoned _____

Date

12/5 191 9

Pyle

Scout