

Map No. K14 Sec. 24 Twp. 26 R. 5Well No. 3 HolmesJ. S. G. Caldwell Company

Contractor

NORTH

WEST

EAST

SOUTH

Location 250-SRig up ✓ 1070-E

Drilling and Remarks:

✓

RECORD

Cased _____ in., _____ ft.

Sand _____

Gas _____

Oil _____

Total Depth _____

PRODUCTION

1st 24 hrs. Nat. _____

1st 24 hrs. after shot _____

Gas _____ Cu. Ft.

Dry Hole _____

Abandoned _____

Date

9/20

191

8C. G. L.

Scout


Map No. 1514 Sec. 24 Twp. 26 R. 5Well No. 3 HaleJ. O. Caldwell Company

Contractor

NORTH

WEST

EAST

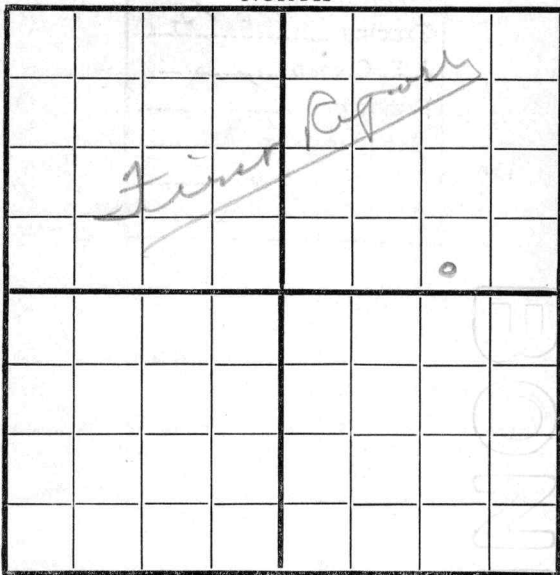

SOUTH

Location 250-S1010-E

Rig up

Drilling and Remarks:

300'

RECORD

Cased _____ in., _____ ft.

Sand _____

Gas _____

Oil _____

Total Depth _____

PRODUCTION

1st 24 hrs. Nat. _____

1st 24 hrs. after shot _____

Gas _____ Cu. Ft.

Dry Hole _____

Abandoned _____

Date

9/1918

Pyle

Scout

25


Map No. K14 Sec. 24 Twp. 26 R. 5Well No. 3 HaleJ. O. G. Caldwell Company

Contractor

NORTH

WEST

EAST

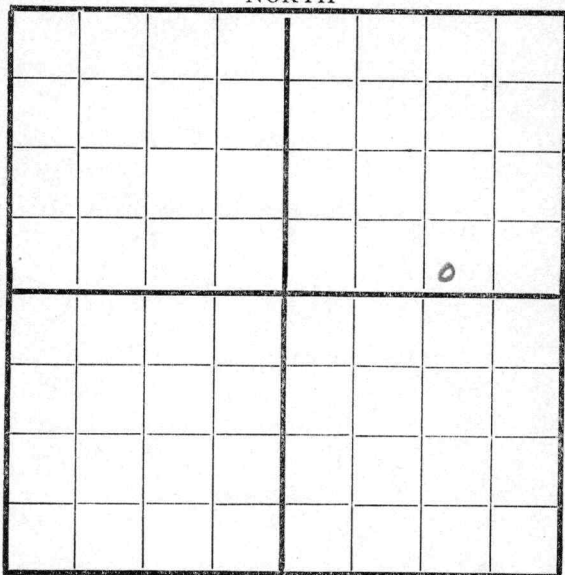

SOUTH

Location 250' S1070' E

Rig up

Drilling and Remarks:

900'

RECORD

Cased _____ in., _____ ft.

Sand _____

Gas _____

Oil _____

Total Depth _____

PRODUCTION

1st 24 hrs. Nat. _____

1st 24 hrs. after shot _____

Gas _____ Cu. Ft.

Dry Hole _____

Abandoned _____

Date

10/21918Pyle

Scout

Map No. 1514 Sec. 24 Twp. 26 R. 5Well No. 3 HolmesJ. O. G. Caldwell Company

Contractor

NORTH

WEST

EAST

SOUTH

Location 250' S1070' E

Rig up _____

Drilling and Remarks:

1420'

RECORD

Cased _____ in., _____ ft.

Sand _____

Gas _____

Oil _____

Total Depth _____

PRODUCTION

1st 24 hrs. Nat. _____

1st 24 hrs. after shot _____

Gas _____ Cu. Ft.

Dry Hole _____

Abandoned _____

Date

10/8

191

8Pyle


Scout

Map No. 814 Sec. 24 Twp. 26 R. 5Well No. 3 Holm
J. F. G. Caldwell Company

Contractor

NORTH

WEST

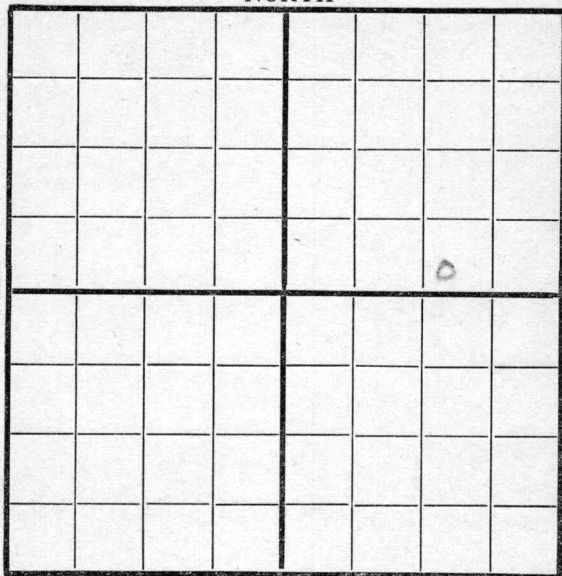

EAST

SOUTH

Location 250-S
1070-E

Rig up

Drilling and Remarks:

1500'

RECORD

Cased _____ in., _____ ft.

Sand _____

Gas _____

Oil _____

Total Depth _____

PRODUCTION

1st 24 hrs. Nat. _____

1st 24 hrs. after shot _____

Gas _____ Cu. Ft.

Dry Hole _____

Abandoned _____

Date

10/17

191

8

Pyle

Scout


Map No. 514 Sec. 24 Twp. 26 R. 5Well No. 3 Holm
J. P. Q. Caldwell Company

Contractor

NORTH

WEST

EAST

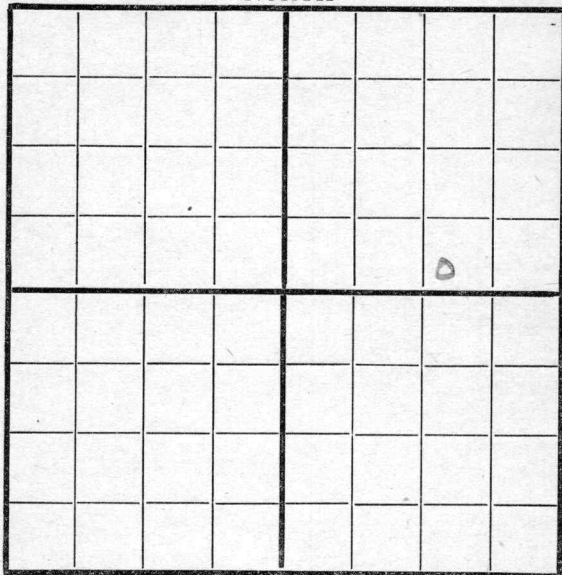

SOUTH

Location 250-S
1070-E

Rig up _____

Drilling and Remarks:

2300

RECORD

Cased _____ in., _____ ft.

Sand _____

Gas _____

Oil _____

Total Depth _____

PRODUCTION

1st 24 hrs. Nat. _____

1st 24 hrs. after shot _____

Gas _____ Cu. Ft.

Dry Hole _____

Abandoned _____

Date

10/
me191 8

Pyle

Scout

Map No. 874 Sec. 24 Twp. 26 R. 5

Well No. 3-Holcom

Company

Contractor

NORTH

WEST

EAST

SOUTH

Location 250-8

Rig up.....

Drilling and Remarks:

2500'

RECORD

Cased-----in., -----ft.

Sand_____

Gas _____

Oil_____

Total Depth_____

PRODUCTION

1st 24 hrs. Nat. _____

1st 24 hrs. after shot-----

Gas.....Cu. Ft.

Dry Hole.....

Abandoned.....

Date _____

191

8

Pyle

Scout

WEST

EAST

SOUTH

Location 230-S

Rig up.....

Drilling and Remarks:

D. 10 @
2500'

RECORD

Cased _____ in., _____ ft.

Sand_____

Gas _____

Oil _____

Total Depth_____

PRODUCTION

1st 24 hrs. Nat. _____

1st 24 hrs. after shot-----

Gas.....Cu. Ft.

Dry Hole.....

Abandoned.....

Date _____

Pyle

Scout


Map No. K 14 Sec. 24 Twp. 26 R. 5Well No. 3 Hole
J. F. G. Caldwell Company

Contractor

NORTH

WEST

EAST

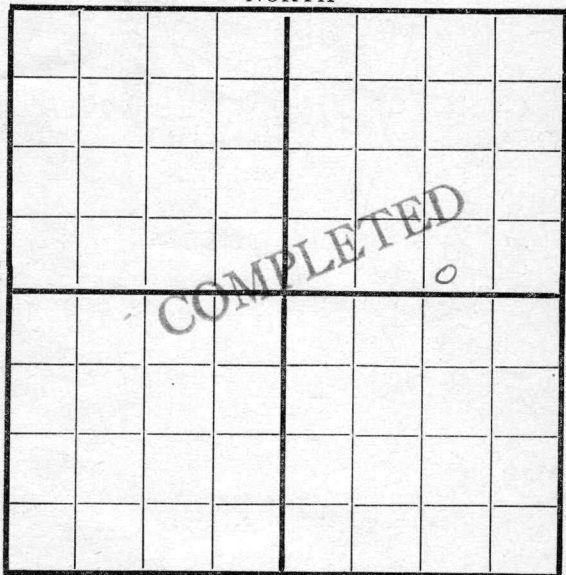

250-S SOUTH

1070 E

Location _____

Rig up _____

Drilling and Remarks:

Shot 10 gts

RECORD

Cased _____ in., _____ ft.

Sand 2685-2692

Gas _____

Oil _____

Total Depth _____

PRODUCTION

1st 24 hrs. Nat. _____

1st 24 hrs. after shot 6.5 bbls

Gas _____ Cu. Ft.

Dry Hole _____

Abandoned _____

Date

11/18

191

8D. G. L.

Scout

Map No. K14 Sec. 24 Twp. 26 R. 5Well No. 3 Holen
Caldwell


Company

Contractor

NORTH

WEST

EAST

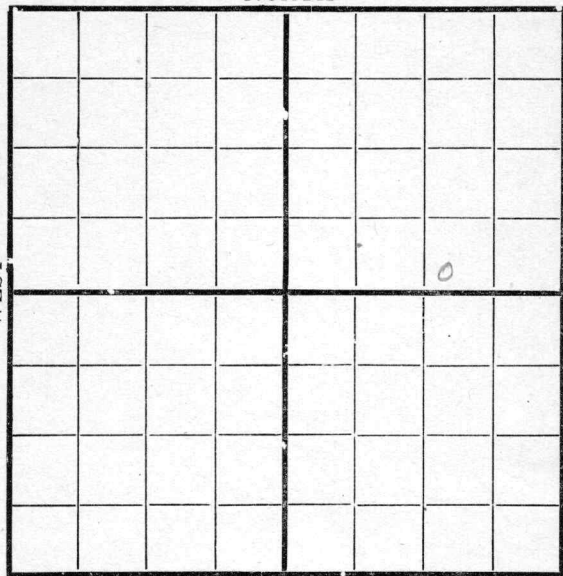

250-5

SOUTH

1070-E

Location

Rig up

Drilling and Remarks:

D. 10 @
2500'

RECORD

Cased _____ in., _____ ft.

Sand _____

Gas _____

Oil _____

Total Depth _____

PRODUCTION

1st 24 hrs. Nat. _____

1st 24 hrs. after shot _____

Gas _____ Cu. Ft.

Dry Hole _____

Abandoned _____

Date

11/21

1918


Oyler

Scout

Map No. K14 Sec. 24 Twp. 26 R. 5Well No. 3 HolmanCaldwell Company

Contractor

NORTH

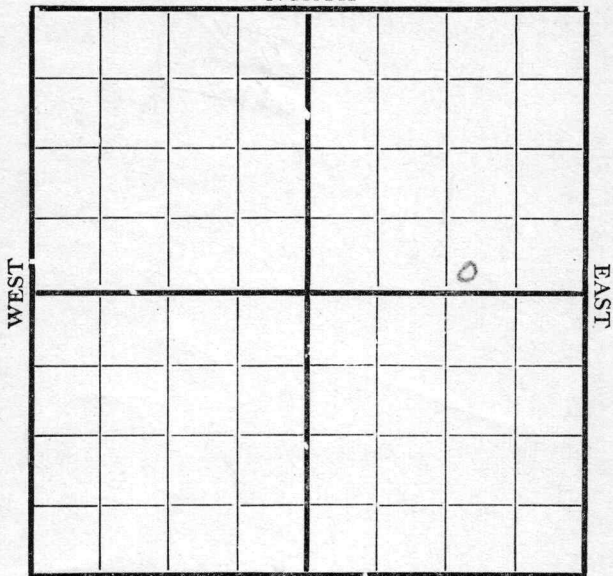

SOUTH

250-S1070-E

Location _____

Rig up _____

Drilling and Remarks:

small well

RECORD

Cased _____ in., _____ ft.

Sand 2685-2692

Gas _____

Oil _____

Total Depth _____

PRODUCTION

1st 24 hrs. Nat. _____

1st 24 hrs. after shot _____

Gas _____ Cu. Ft.

Dry Hole _____

Abandoned _____

Date

11/1918Pyle

Scout

29


Map No. K14 Sec. 24 Twp. 26 R. 5Well No. 3 HaleCaldwell Company

Contractor

NORTH

WEST

EAST

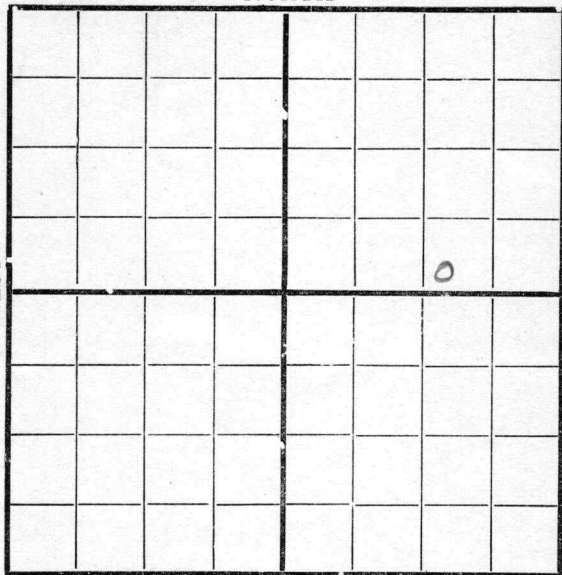

SOUTH

250-S1070-E

Location _____

Rig up _____

Drilling and Remarks:

200' oil in hole
will shoot

RECORD

Cased _____ in., _____ ft.

Sand 2685-2692

Gas _____

Oil _____

Total Depth _____

PRODUCTION

1st 24 hrs. Nat. _____

1st 24 hrs. after shot _____

Gas _____ Cu. Ft.

Dry Hole _____

Abandoned _____

Date

12/5 1918 Pyle Scout

Map No. K14 Sec. 24 Twp. 26 R. 5Well No. 3 HolmesCaldwell


Company

Contractor

NORTH

WEST

EAST

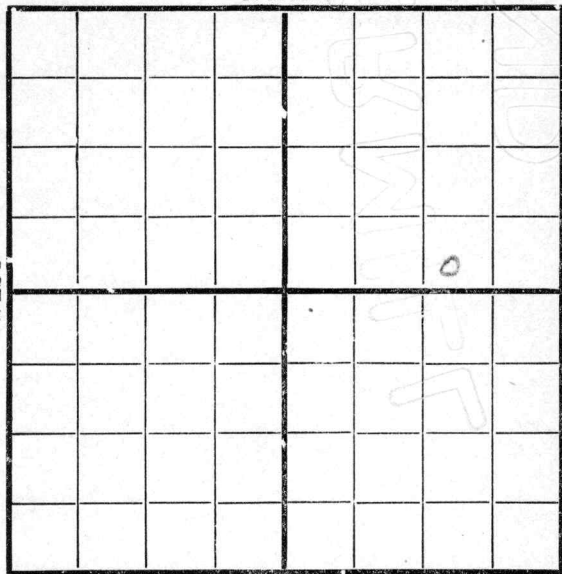250-S

SOUTH

1070 E

Location _____

Rig up _____

Drilling and Remarks:

*Shot 10 gts
filled up
2100 ft oil*

RECORD

Cased _____ in., _____ ft.

Sand 2685 - 2692

Gas _____

Oil _____

Total Depth _____

PRODUCTION

1st 24 hrs. Nat. _____

1st 24 hrs. after shot _____

Gas _____ Cu. Ft.

Dry Hole _____

Abandoned _____

Date

12/
12

1918

H. B.

Scout