


Map No. _____ Sec. 24 Twp. 26 R. 5
 Well No. 4 Holeman Farm
Caldwell Company

NORTH

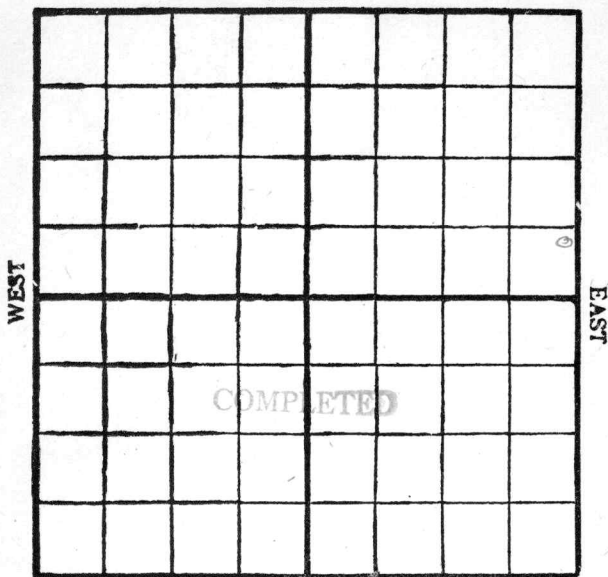

SOUTH

Location _____

Rig Up _____

Drilling Remarks:

Drilling Remarks:

RECORD

Cased _____ in. _____ ft.

Sand _____

Gas _____

Oil _____

Total Depth _____

PRODUCTION

1st 24 hrs. Nat. _____

1st 24 hrs. after shot _____

Gas _____ cu. ft.

Dry Hole _____

Abandoned _____


Map No. K14 Sec. 24 Twp. 26 R. 5Well No. H HolmesCaldwell Company

Contractor

NORTH

WEST

EAST

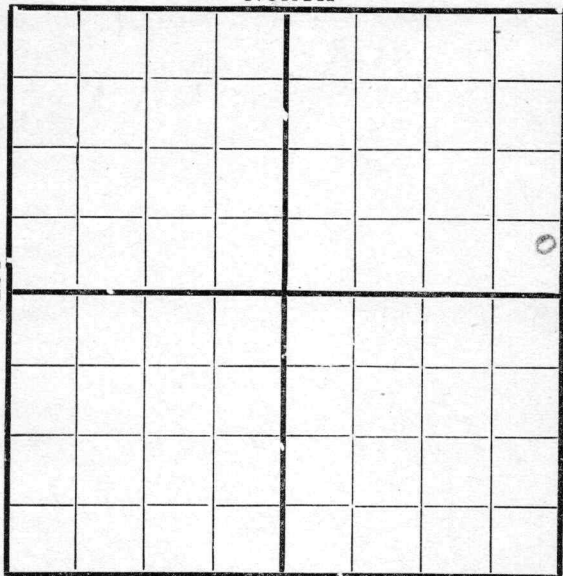

SOUTH

600-S250-E

Location _____

Rig up _____

Drilling and Remarks:

Rigging up

RECORD

Cased _____ in., _____ ft.

Sand _____

Gas _____

Oil _____

Total Depth _____

PRODUCTION

1st 24 hrs. Nat. _____

1st 24 hrs. after shot _____

Gas _____ Cu. Ft.

Dry Hole _____

Abandoned _____

Date

Pyle191

Scout

Map No. R14 Sec. 24 Twp. 26 R. 5

Well No. H. Holm

J. P. G. Caldwell Company

Contractor

NORTH

WEST

EAST

SOUTH

Location 250 S-E

Rig up. ✓

Drilling and Remarks:

RECORD

Cased-----in., -----ft.

Sand _____

Gas

Oil _____

Total Depth_____

PRODUCTION

1st 24 hrs. Nat. -----

1st 24 hrs. after shot-----

Gas.....Cu. Ft.

Dry Hole

Abandoned.....

Date _____

11/ 8 Gyle Scout

Tracing *PKM*

J. S. C. map

Frantz map

Moody map *ACM*

Frantz plat book

Moody plat book

Don show # 274 on
same location. Please
give correct location
for both wells.

RECORD

Crack

Band

Gas

Oil

Total Depth

PRODUCTION

Water

Oil

Gas

Dr. Hole

Abandoned


Location

Reg. No.

Drilling and Remarks

Date

Map No. K14 Sec. 24 Twp. 26 R. 5
 Well No. 4 Holen
Caldwell Company
 Contractor

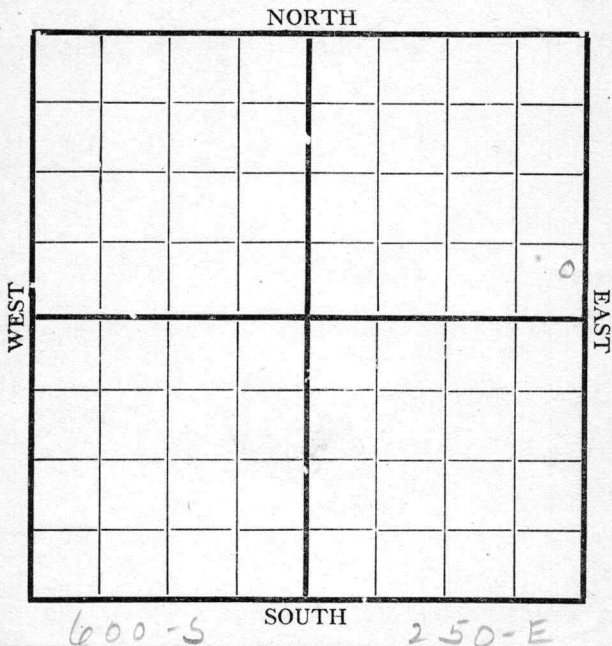

Location _____
 Rig up _____
 Drilling and Remarks:

Rigging up

RECORD


Cased _____ in., _____ ft.
 Sand _____
 Gas _____
 Oil _____
 Total Depth _____

PRODUCTION

1st 24 hrs. Nat. _____
 1st 24 hrs. after shot _____
 Gas _____ Cu. Ft.
 Dry Hole _____
 Abandoned _____

Date 11/8 1918 Oyle Scout
21

Map No. K14 Sec. 24 Twp. 26 R. 5
Well No. H Holm
Caldwell Company
Contractor

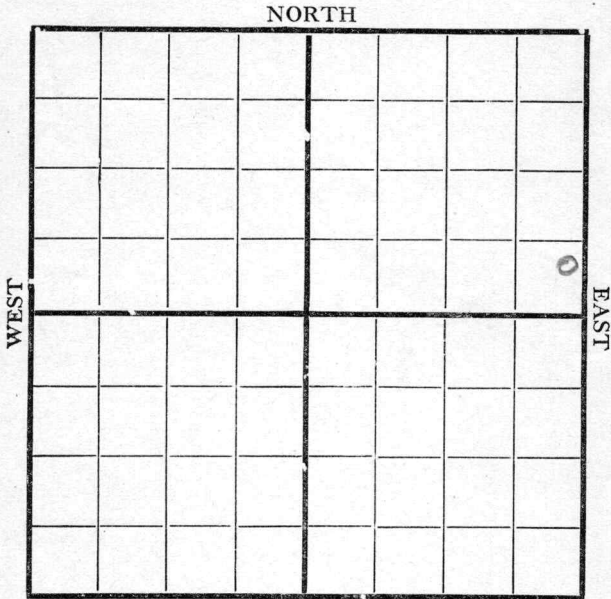

600-S 250-E

Location _____
Rig up _____
Drilling and Remarks:

Spudding

RECORD

Cased _____ in., _____ ft.
Sand _____
Gas _____
Oil _____
Total Depth _____

PRODUCTION

1st 24 hrs. Nat. _____
1st 24 hrs. after shot _____
Gas _____ Cu. Ft.
Dry Hole _____
Abandoned _____


Date 12/5 1918 Cyle Scout

Map No. K14 Sec. 24 Twp. 26 R. 5Well No. 4 HolmanCompany Caldwell

Contractor _____

NORTH

WEST

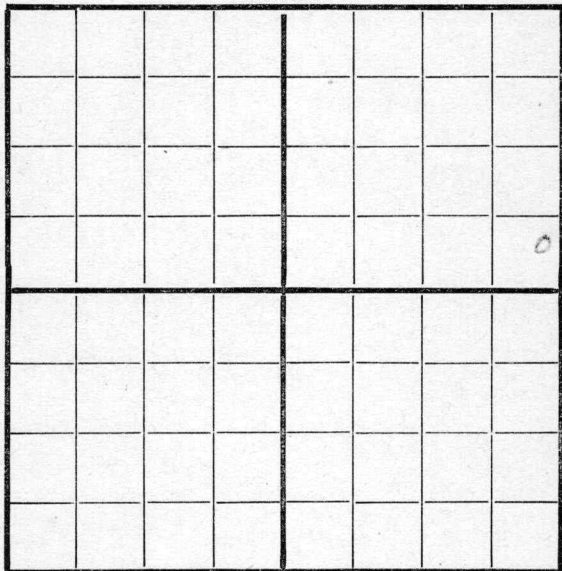

EAST

SOUTH

600-S250-E

Location _____

Rig up _____

Drilling and Remarks:

640'

RECORD

Cased _____ in., _____ ft.

Sand _____

Gas _____

Oil _____

Total Depth _____

PRODUCTION

1st 24 hrs. Nat. _____

1st 24 hrs. after shot _____

Gas _____ Cu. Ft.

Dry Hole _____

Abandoned _____

Date

12/121918H. B.

Scout


Map No. K14 Sec. 24 Twp. 26 R. 5

Well No. 4 Holen
Caldwell

Company

Contractor

NORTH

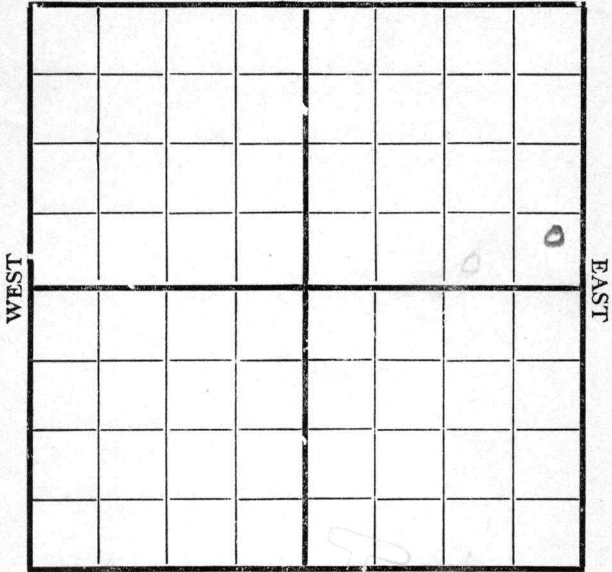

600-S

SOUTH

250 E

Location

Rig up

Drilling and Remarks:

1650'

RECORD

Cased _____ in., _____ ft.

Sand _____

Gas _____

Oil _____

Total Depth _____

PRODUCTION

1st 24 hrs. Nat. _____

1st 24 hrs. after shot _____

Gas _____ Cu. Ft.

Dry Hole _____

Abandoned _____

Date

12/18

1918

Pyle

Scout


Map No. K14 Sec. 24 Twp. 26 R. 5Well No. 4 HolmesEldredge Company

Contractor

NORTH

WEST

EAST

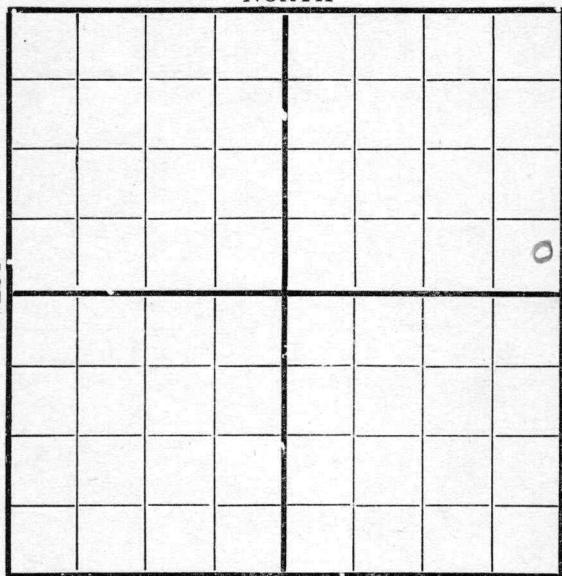

600-S

SOUTH

250 E

Location _____

Rig up _____

Drilling and Remarks:

RECORD

Cased _____ in., _____ ft.

Sand _____

Gas _____

Oil _____

Total Depth _____

PRODUCTION

1st 24 hrs. Nat. _____

1st 24 hrs. after shot _____

Gas _____ Cu. Ft.

Dry Hole _____

Abandoned _____

Date

12/27

191


Pyle

Scout

Map No. K14 Sec. 24 Twp. 26 R. 5Well No. 4 HolmesEndwell Company

Contractor

NORTH

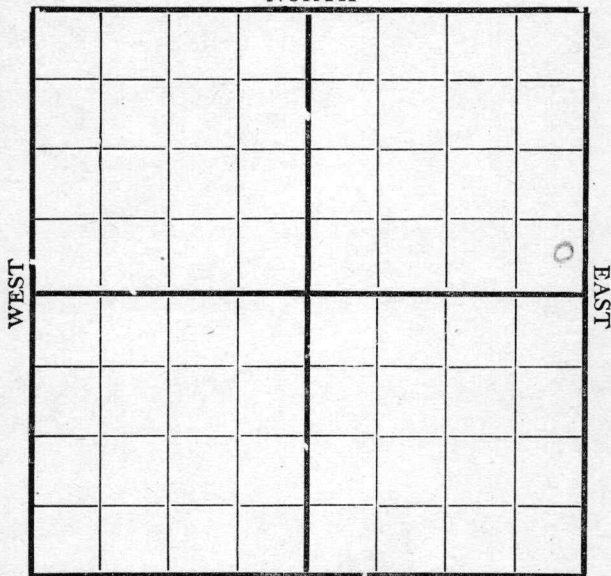

SOUTH

600-S250 E

Location _____

Rig up _____

Drilling and Remarks:

D. D @
1650'

RECORD

Cased _____ in., _____ ft.

Sand _____

Gas _____

Oil _____

Total Depth _____

PRODUCTION

1st 24 hrs. Nat. _____

1st 24 hrs. after shot _____

Gas _____ Cu. Ft.

Dry Hole _____

Abandoned _____

Date

Jan 16 1919Pyle


Scout

Map No. K14 Sec. 24 Twp. 26 R. 5Well No. 4 HolmanCaldwell Company

Contractor

NORTH

WEST

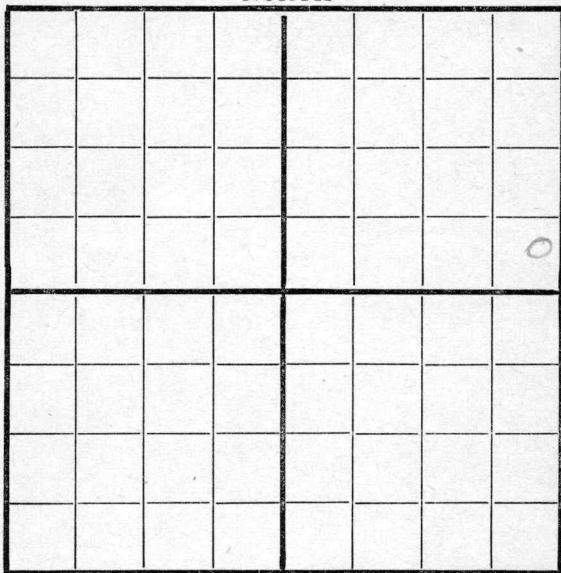

EAST

250 E

SOUTH

600 S

Location _____

Rig up _____

Drilling and Remarks:

V. 10 @,
1650

RECORD

Cased _____ in., _____ ft.

Sand _____

Gas _____

Oil _____

Total Depth _____

PRODUCTION

1st 24 hrs. Nat. _____

1st 24 hrs. after shot _____

Gas _____ Cu. Ft.

Dry Hole _____

Abandoned _____

Date

Jan 22 1919

Pyle

Scout

Map No. K14 Sec. 24 Twp. 26 R. 5Well No. H. Holcom
Caldwell

Company

Contractor

NORTH

WEST

EAST

COMPLETED

SOUTH

600 S

250 E

Location

Rig up

Drilling and Remarks:

RECORD

Cased _____ in., _____ ft.

Sand 2686 - 2703

Gas _____

Oil _____

Total Depth _____

PRODUCTION

1st 24 hrs. Nat. 50 bbls

1st 24 hrs. after shot _____

Gas _____ Cu. Ft.

Dry Hole _____

Abandoned _____

Date

3/14

1919

Oyler Scout