STATE	COMPANY Continental
Kansas	
COUNTY Newton	FARM W.F. Winters WELL NO. 1
BLOCK	SURVEY
SEC. 30	
T. 23 R. 17W	TOTAL DEPTH 4717
	SE-SE-NW
	COMMENCED
	COMPLETED
	REMARKS
ALTITUDE 2117	
PRODUCTION D+A	

CASING RECORD

16" 265	OP ½ hr
Lans 3843	Rec 70' mud
Arb 4686	
TD 4717	
DST 4356-84	

SHOT QUARTS BETWEEN
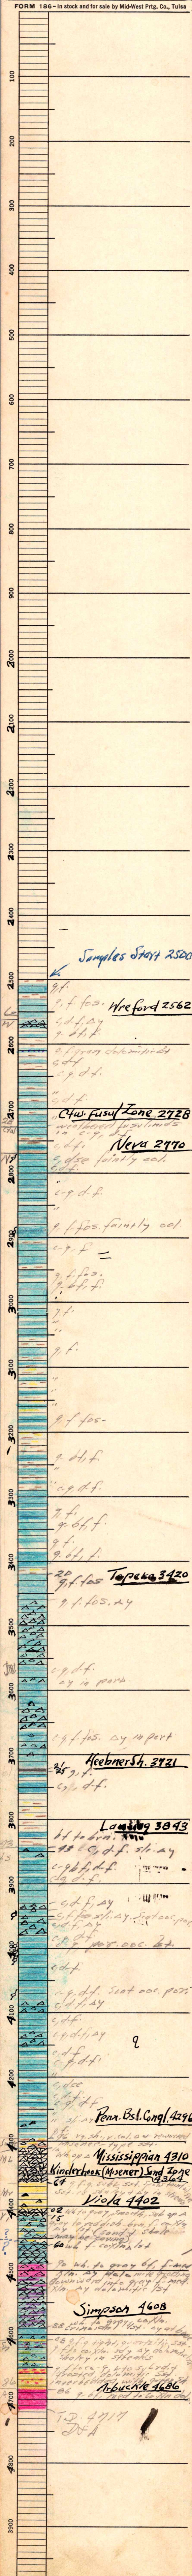
FORM 186 - In stock and for sale by Mid-West Prtg. Co., Tulsa