


Map No.----- Sec. 24 Twp. 26 R. 5
Well No. 5 Holem.-----Farm
Caldwell Oil-----Company

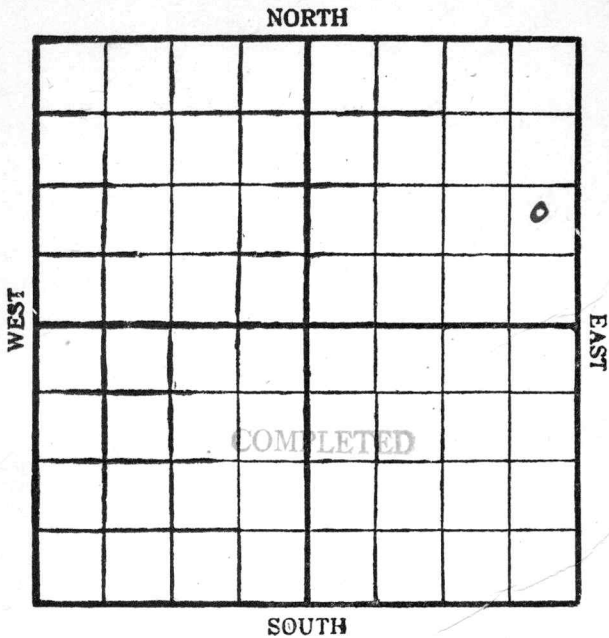

Location -----

Rig Up -----

Drilling Remarks:

Drilling Remarks:

RECORD

PRODUCTION

Cased ----- in. ----- ft.

Sand -----

Gas -----

Oil -----

Total Depth -----

1st 24 hrs. Nat. -----

1st 24 hrs. after shot -----

Gas ----- cu. ft.

Dry Hole -----

Abandoned -----

Map No. K14 Sec. 24 Twp. 26 R. 5Well No. 5 HolmCaldwell


Company

Contractor

NORTH

WEST

EAST

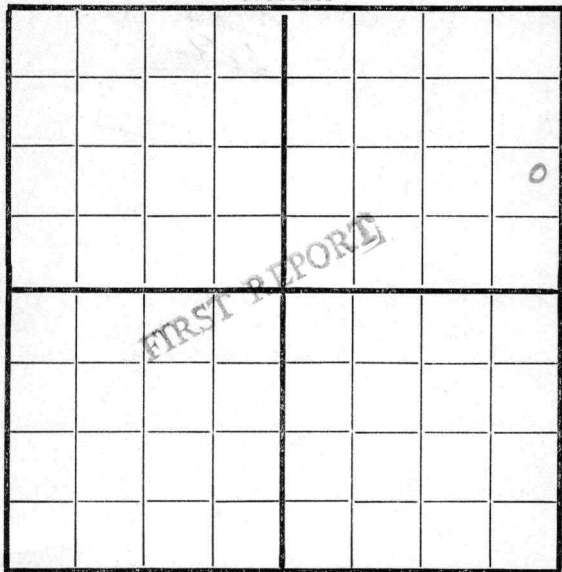

SOUTH

1070-S250-E

Location _____

Rig up _____

Drilling and Remarks:

Timbers

RECORD

Cased _____ in., _____ ft.

Sand _____

Gas _____

Oil _____

Total Depth _____

PRODUCTION

1st 24 hrs. Nat. _____

1st 24 hrs. after shot _____

Gas _____ Cu. Ft.

Dry Hole _____

Abandoned _____

Date

11/30 1918 Cyle Scout

Map No. K14 Sec. 24 Twp. 26 R. 5
 Well No. 5 Holcom
Caldwell Company
 Contractor

NORTH							
WEST							
SOUTH							
EAST							

<u>1070-S</u> Location _____ Rig up ☒ Drilling and Remarks:	<u>250-E</u> RECORD Cased _____ in., _____ ft. Sand _____ Gas _____ Oil _____ Total Depth _____ PRODUCTION 1st 24 hrs. Nat. _____ 1st 24 hrs. after shot _____ Gas _____ Cu. Ft. Dry Hole _____ Abandoned _____
---	--

Date 12/5 1918 Cycle Scout


Map No. K14 Sec. 24 Twp. 26 R. 5Well No. 5 HolenCaldwell Company

Contractor

NORTH

WEST

EAST

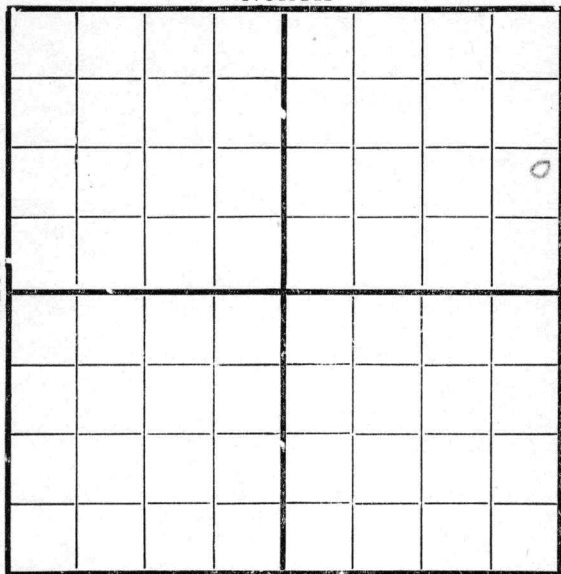

SOUTH

1070 S250 E

Location _____

Rig up ☒ _____

Drilling and Remarks:

RECORD

Cased _____ in., _____ ft.

Sand _____

Gas _____

Oil _____

Total Depth _____

PRODUCTION

1st 24 hrs. Nat. _____

1st 24 hrs. after shot _____

Gas _____ Cu. Ft.

Dry Hole _____

Abandoned _____

Date

12/121918H. B.

Scout

Map No. K14 Sec. 24 Twp. 26 R. 5Well No. 5 HolenCaldwell


Company

Contractor

NORTH

WEST

EAST

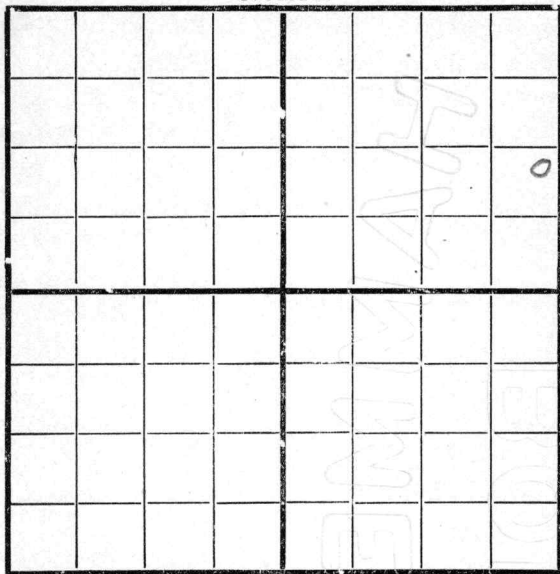

SOUTH

1070 S250 E

Location

Rig up ☒

Drilling and Remarks:

RECORD

Cased _____ in., _____ ft.

Sand _____

Gas _____

Oil _____

Total Depth _____

PRODUCTION

1st 24 hrs. Nat. _____

1st 24 hrs. after shot _____

Gas _____ Cu. Ft.

Dry Hole _____

Abandoned _____

Date

12/10

191


8Pyle

Scout

Map No. K.14 Sec. 24 Twp. 26 R. 5Well No. 5 HolmCaldwell Company

Contractor

NORTH

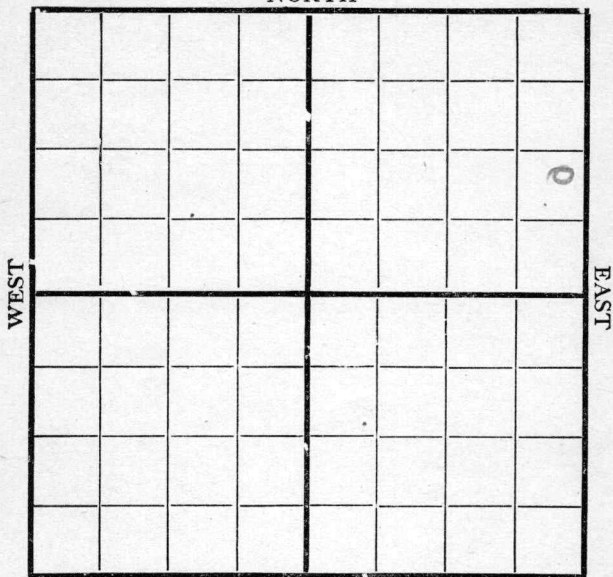

SOUTH

1070 S 250-E

Location _____

Rig up _____

Drilling and Remarks:

D. D @
700'

RECORD

Cased _____ in., _____ ft.

Sand _____

Gas _____

Oil _____

Total Depth _____

PRODUCTION

1st 24 hrs. Nat. _____

1st 24 hrs. after shot _____

Gas _____ Cu. Ft.

Dry Hole _____

Abandoned _____

Date

12/27 1918Pyle

Scout


Map No. K14 Sec. 24 Twp. 26 R. 5Well No. 5 Holmes
Caldwell Company

Contractor

NORTH

WEST

EAST

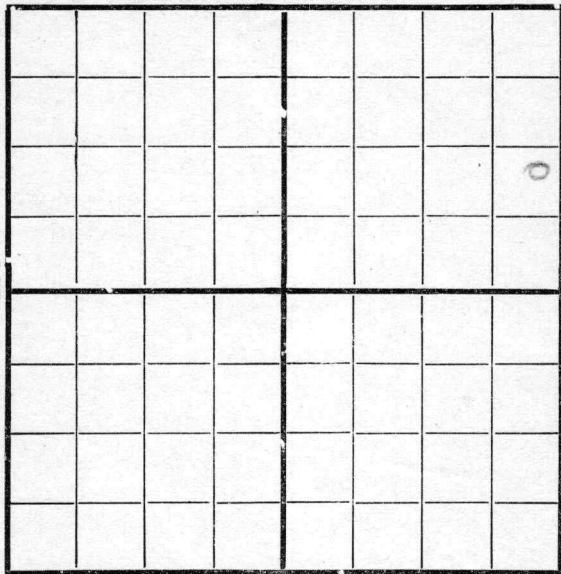

SOUTH

Location _____

Rig up _____

Drilling and Remarks:

D. D. E
700'

RECORD

Cased _____ in., _____ ft.

Sand _____

Gas _____

Oil _____

Total Depth _____

PRODUCTION

1st 24 hrs. Nat. _____

1st 24 hrs. after shot _____

Gas _____ Cu. Ft.

Dry Hole _____

Abandoned _____

Date

191

Pyle


Scout

Map No. 1514 Sec. 24 Twp. 26 R. 5Well No. 5 HolmesCaldwell Company

Contractor

NORTH

WEST

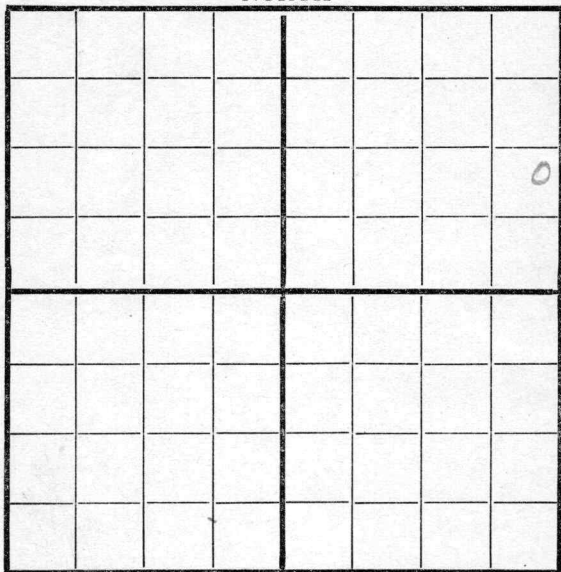

EAST

SOUTH

1070 S250 E

Location _____

Rig up _____

Drilling and Remarks:

S. D. @
700'

RECORD

Cased _____ in., _____ ft.

Sand _____

Gas _____

Oil _____

Total Depth _____

PRODUCTION

1st 24 hrs. Nat. _____

1st 24 hrs. after shot _____

Gas _____ Cu. Ft.

Dry Hole _____

Abandoned _____

Date

Jan 22 1919

Pyle

Scout


Map No. K14 Sec. 24 Twp. 26 R. 5Well No. 5 Holm
Caldwell Company

Contractor

NORTH

WEST

EAST

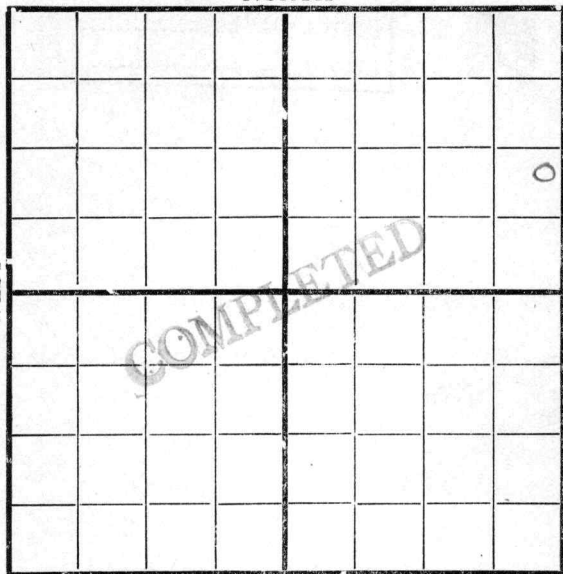

SOUTH

1070 S250 E

Location _____

Rig up _____

Drilling and Remarks:

RECORD

Cased _____ in., _____ ft.

Sand 2698-2711

Gas _____

Oil _____

Total Depth _____

PRODUCTION

1st 24 hrs. Nat. 30 bbls

1st 24 hrs. after shot _____

Gas _____ Cu. Ft.

Dry Hole _____

Abandoned _____

Date

3/14191 9Oy h

Scout