3-57

STATE Kansas	COMPANY Hawker-Davis
COUNTY Pawnee	FARM Williams — WELL NO. 1
BLOCK	SURVEY
SEC. 6	TOTAL DEPTH 4540
T. 23 R. 18W	Sw-Sw-NE
	COMMENCED
	COMPLETED
ALTITUDE 2174	REMARKS Electrolog
PRODUCTION D,&A	

CASING RECORD

DST 4360-95/30", 40'm, BHP 0#
DST 4379-4415(1hr), 115'm, BHP 1160#
DST 4434-50(1hr), 590' mdy sw, BHP 1340#

SHOT | QUARTS | BETWEEN

FORM 186 - In stock and for sale by Ross-Martin Co., Tulsa

Elect. on order

Anhydrite 1270'

Samples start @ 3500'

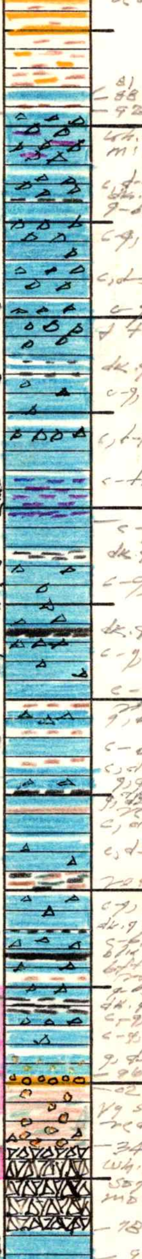

g, dt, fos
c-g, dt, fos. sy lst
dk g to blk sh
g, dt, sy
lt g, lithographic lst
lt g, dt, sy
dk g to blk sh
g, d-f
g, soft por fos. sy lst
por & finely sy soc. in streaks
Hbnr Sh 3781
81 blk sh
86 g, dt
90 rd g sh
wh, dt.
12 rd g, micac. sh, with inter-bedded, g, f.g. sub-micac sst
81 bf to brn dt
88 rd g sh
92
Ls 3892
wh to c, dt, gran, sy lst. dolomitic in part
c, dt, sy
blk sh
g-dt, d-f fos
c-g, dt, fos. sy streaks occ por
c, dt, sy
c-g, d-f, sy. streaks occ por & trace oil stn
dk g. sh. with streak g, dse lst
c-g, dt, sli sy, and por at top
c, d-f. ool & sy at top
c-tan, f. gran, por. occ. dolo. lst
c-g, d-f
dk g to blk sh
c-g, d-f, sy. streaks occ por
dk g. to blk sh
c-g, d-f, sli sy. streaks occ por
c-g, dse.
rd g sh
g, dt, sy
c-dt, d-f, sort ool por
c, dse
g, dse sy
dk g to blk sh.
rd g sh.
c, dse
c, dse sli sy
red, green & dk g sh
c-g, dse. sli sy
dk g. sh.
c-ft, dt, sy, fairly ool. lst
blk sh.
brn to c, dt, fos. sli sy
g, dt, sy
dk g to blk sh
PBC 4396
c-g, dse sy
c-g, dse sli sy
g, dse, sdy lst.
96 g, f to very coarse & tough red shaley friable sst
02 vg sdy clay & sh with trace red-jasperoid
Miss 4434
34 wh, op to sub op fos. residue) & soft chalky & tripolitic for most part
"Gilmore City" 4478
78 wh. dse to c. xln (crinoidal) lst
Khk Sh & Sst 4494
94 green & rusty brn sh.
98 wh, f.g., glauc sst to sub-gl sst
05 wh, dse sdy co. ool. lst.
20 green & rusty brn sdy sh.

Total Depth 4530' in Khk Sh