


Section 24 Township 26 Range 5E

Well No. #2 V. Holem

Company G. D. Smitherman

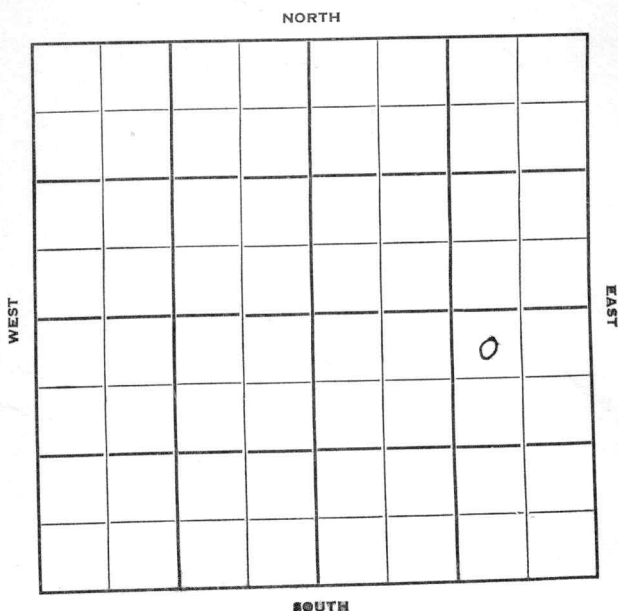

KANSAS

Butler

Sec. 24 Twp. 26 R. 5-E

Well No. #2 V. Holem Farm

G. D. Smitherman Company

Martin & Cash Contractor

Miscellaneous


330 Ft. from N. Line

_____ Ft. from S. Line

990 Ft. from E. Line

_____ Ft. from W. Line

NW NE SE

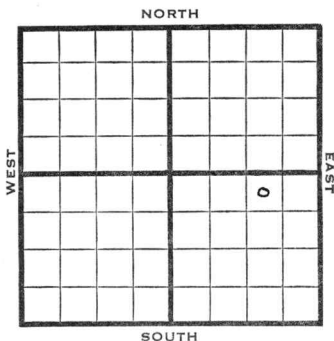

1950

Elev 1355

REPORT

8/30 Pits

10/11 Spud 9-3-50

8" @ 75

Bart 2701

TD 2798

D&A

ABANDONED

County **Butler** State **Kansas**

Sec. **24** (Blk. **26** (Sur. **5E** Map No.

Operator G. D. Smitherman

Well No. 2 Farm V. Holen

Elev.	Location	WW	NE	SE
-------	----------	----	----	----

330 Ft. From N Line SE

990 Ft. From E Line Quarter

1st. Report AUG 30 1950

Completion

Remarks

Spudding Date _____

Drig. Data	Miscellaneous

Pits


J. E. TYRA

County Butler State Kansas
 Sec. 24 (Blk.) 26 (Sur.) 5E Map No.

Operator G. D. Smitherman

Well No. 2 Farm V. Holem

Elev. 1355 Location NW NE SE

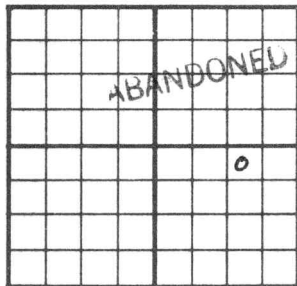

330 Ft. From N Line SE

990 Ft. From E Line Quarter

1st. Report

Completion OCT 11 1950

Remarks Miscellaneous

Martin & Cash - Contr.

Spudding Date 9-3-50

Drlg. Data D & A TD 2798

8" @ 75 Bart. 2701 TD 2798

D & A

J. E. TYRA