

KANSAS

Greenwood ✓

Section 31 Township 25 Range 11EWell No. 1 ShellCompany Benny Inv.
Fester & Finney

O. W. D. D

Misc.

NORTH

WEST								EAST

SOUTH

Greenwood

Sec. 31 **KANSAS** Twp. 25 R. 11E ✓

Well No. #1 Shell Farm

~~Easter & Finney~~ *Berry Inv.* Company

Miscellaneous


 Ft. from N. Line

330' Ft. from S. Line

990' Ft. from E. Line

 Ft. from W. Line

SW SE SE

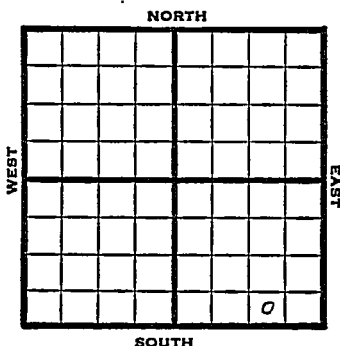

1949 Elev. - REPORT

1/21	Spud SD
1/19	"
1/26	"
2/2	"
2/9	"
2/16	"
2/23	10" @ 10' Drlg. 1800'
3/2	Miss 1966' TD 1967' 4" @ 1967'
3/8	TD 1975' 2000 acid
3/16	"
3/23	"
3/30	Miss 1966' 4" @ 1967' 2000 acid Pump 10 oil Pot. Gr. 380 TD 1975'

COMPLETED

OVER

1950

O. W. D. D.

3/15

10" @ 10'

Miss 1966'

4" @ 1967'

OTD 1975'

Drlg. 1977'

TD 2075'

10" @ 10'

Miss 1966'

4" @ 1967'

Old TD 1975'

D&A

Aband.

4/5

ABANDONED

Kansas


Map No. _____ Sec. 31 Twp. 25 R. 11EWell No. 1 Shell

Fester & Finney Company

FIRST REPORT Contractor

SW SE SE

SECTION PLAT

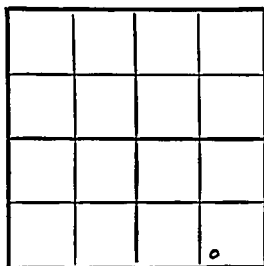

_____ Ft. from N. Line

330 Ft. from S. Line990 Ft. from E. Line

_____ Ft. from W. Line

Greenwood County

RECORD

Location _____

Cased _____ in., _____ ft.

Rig up _____

Sand _____

Drilling and Remarks:

Gas _____

Oil _____

spud SD

Total Depth _____

PRODUCTION

1st 24 hrs. Nat. _____

1st 24 hrs. after shot _____

Gas _____ Cu. Ft.

Dry Hole _____

Abandoned _____

Date

JAN 12 1949 19

S. J. LEWIS

Scout

Map No. _____ Sec. 31 Twp. 25 R. 11EWell No. 1 ShellBerry Inv. **O. W. D. D.** Company

Contractor _____

SW SE SE

Correct to name

SECTION PLAT

_____ Ft. from N. Line

330 Ft. from S. Line990 Ft. from E. Line

_____ Ft. from W. Line



Greenwood County

Location _____

Rig up _____

Drilling and Remarks:

10" @ 10'Miss. 19664" @ 1967OTD 1975drlg. 1977

RECORD

Cased _____ in., _____ ft.

Sand _____

Gas _____

Oil _____

Total Depth _____

PRODUCTION

1st 24 hrs. Nat. _____

1st 24 hrs. after shot _____

Gas _____ Cu. Ft.

Dry Hole _____

Abandoned _____

Date

MAR 15 1956 19J. E. TYRA Scout

Kansas

Map No. 16 Sec. 31 Twp. 25 R. 11EWell No. 1 ShellFester & Finney

Company

COMPLETE

Contractor

SW SE SE

SECTION PLAT

 Ft. from N. Line330 Ft. from S. Line990 Ft. from E. Line Ft. from W. Line

Greenwood County

			6

Location Rig up

Drilling and Remarks:

Miss 1866
4' C 1967
2000 acid
Pump 10 oil
382 cu

RECORD

Cased in., 2027 ft.Sand Gas Oil Total Depth 1925

PRODUCTION

1st 24 hrs. Nat. 1st 24 hrs. after shot Gas Cu. Ft.Dry Hole Abandoned

Date

MAR 30 1949

19

S. J. LEWIS

Scout

Kansas

Map No. _____ Sec. 31 Twp. 25 R. 11EWell No. 1 Shell

_____ Berry Inv. _____ Company

_____ Contractor

SW SE SE

SECTION PLAT


_____ Ft. from N. Line

330 Ft. from S. Line990 Ft. from E. Line

_____ Ft. from W. Line

OWDD

Greenwood County

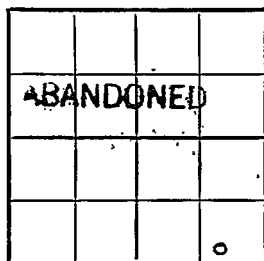

Location _____

Rig up _____

Drilling and Remarks:

10" @ 10'
 miss 1966
 4" @ 1967
 old T.D. 1975
 DVA

RECORD

Cased _____ in., _____ ft.

Sand _____

Gas _____

Oil _____

Total Depth 2075

PRODUCTION

1st 24 hrs. Nat. _____

1st 24 hrs. after shot _____

Gas _____ Cu. Ft.

Dry Hole _____

Abandoned _____

Date

J. E. TYRA

APR 5 1950

Scout