


Map No. _____ Sec. 29 Twp. 26 R. 5Well No. 1- Kinney FarmLeonard Ketal Company

NORTH

WEST

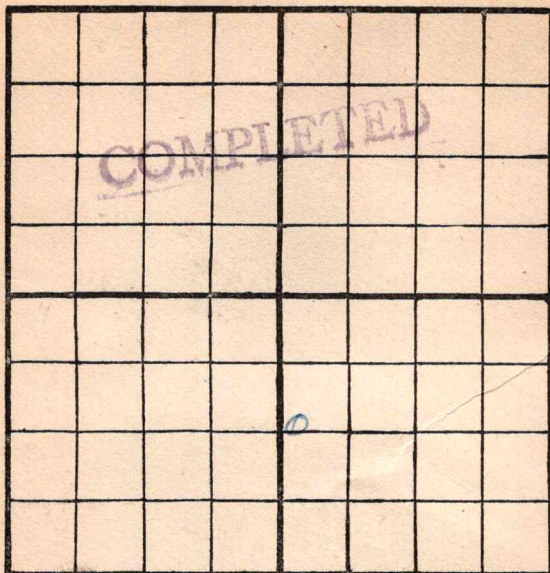

EAST

SOUTH

Location _____

Rig Up _____

Drilling Remarks:

Drilling Remarks:

RECORD

Cased _____ in. _____ ft.

Sand _____

Gas _____

Oil _____

Total Depth _____

PRODUCTION

1st 24 hrs. Nat. _____

1st 24 hrs. after shot _____

Gas _____ cu. ft

Dry Hole _____


Abandoned _____

Map No. _____ Sec. 29 Twp. 26 R. 5
 Well No. 1 Kinner Farm _____
Leeward 1st Company _____

NORTH

WEST

EAST

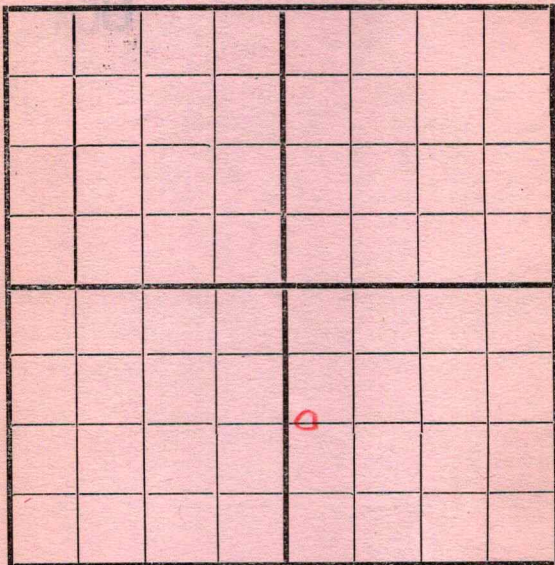

SOUTH

Location _____

Rig Up _____

Drilling and remarks _____

RECORD

Cased _____ in. _____ Ft.

Sand _____

Gas _____

Oil _____

Total Depth _____

FIRST REPORT

PRODUCTION

1st 24 hrs. Nat. _____

1st 24 hrs. after shot _____

Gas _____ Cu. Ft.

Dry Hole _____

Abandoned _____

Date

191


Scout

Map No. _____ Sec. 29 Twp. 26 R. 5
 Well No. 1 Kennedy Farm _____
Leonard Petal Company

NORTH

WEST

EAST

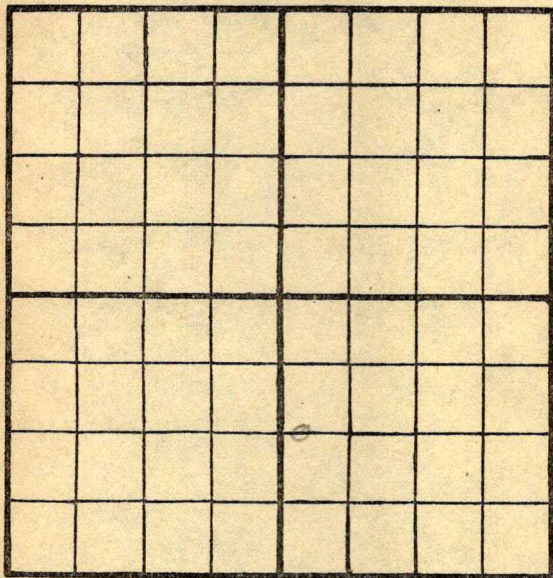

SOUTH

Location _____

Rig Up _____

Drilling and remarks

RECORD

Cased _____ in. _____ Ft.

Sand _____

Gas _____

Oil _____

Total Depth _____

PRODUCTION

1st 24 hrs. Nat. _____

1st 24 hrs. after shot _____

Gas _____ Cu. Ft.

Dry Hole _____

Abandoned _____


Date

9/19, 1917 Candiff Scout

Map No. _____ Sec. 29 Twp. 26 R. 5Well No. 1 Kennedy FarmLeonard & Co Company

NORTH

WEST

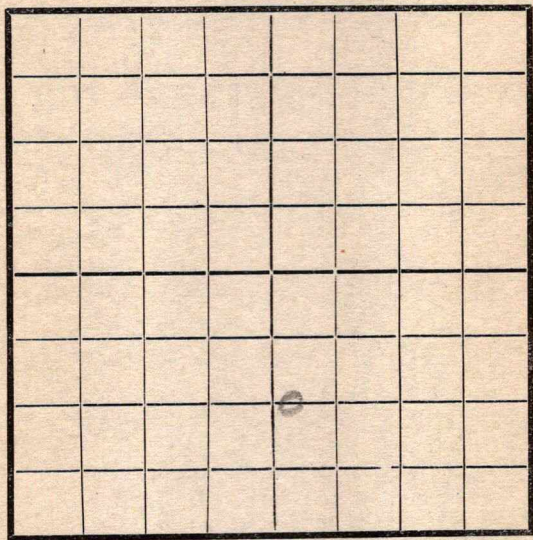

EAST

SOUTH

Location _____

Rig Up _____

Drilling and remarks

780

RECORD

Cased _____ in. _____ Ft.

Sand _____

Gas _____

Oil _____

Total Depth _____

PRODUCTION

1st 24 hrs. Nat. _____

1st 24 hrs. after shot _____

Gas _____ Cu. Ft.

Dry Hole _____


Abandoned _____

Date

10/9, 1917 Carley Scout

Map No. _____ Sec. 29 Twp. 26 R. 5Well No. 1 Perrygo Farm
Perrygo et al Company

NORTH

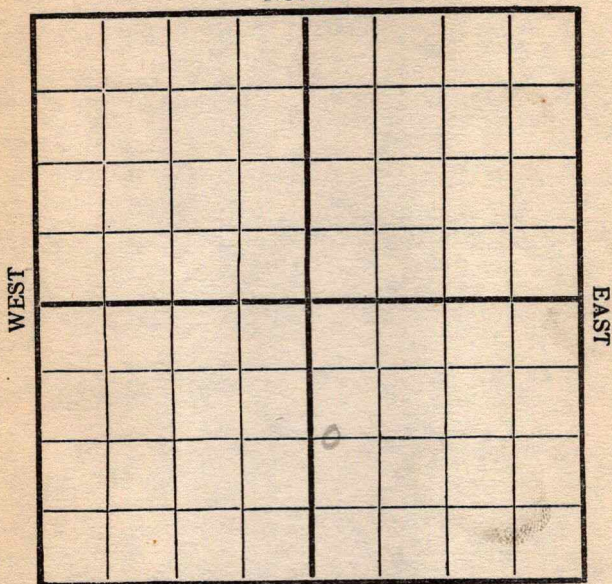

SOUTH

Location _____

Rig Up _____

Drilling and remarks

Shut Down
780

RECORD

Cased _____ in. _____ Ft.

Sand _____

Gas _____

Oil _____

Total Depth _____

PRODUCTION

1st 24 hrs. Nat. _____

1st 24 hrs. after shot _____

Gas _____ Cu. Ft.

Dry Hole _____

Abandoned _____

Date


10/17, 191*7*, *7 P.M.* Scout

Map No. _____ Sec. 29 Twp. 26 R. 5

Well No. Kennedy Farm _____
Leander Company _____

NORTH

WEST

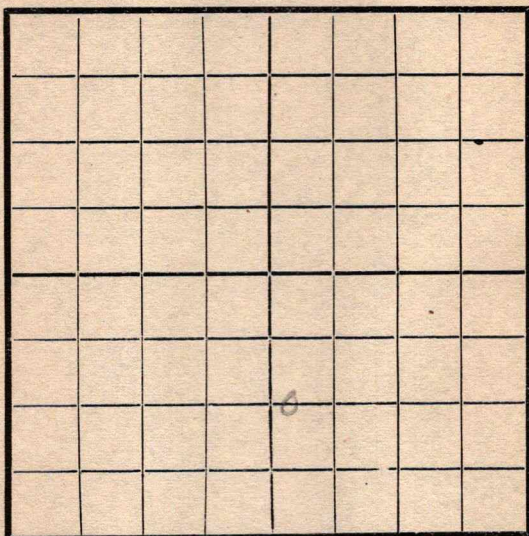

EAST

SOUTH

RECORD

Location _____

Cased _____ in _____ Ft.

Rig Up _____

Sand _____

Drilling and remarks

Gas _____

Oil _____

Total Depth _____

PRODUCTION

1st 24 hrs. Nat. _____

1st 24 hrs. after shot _____

Gas _____ Cu. Ft.

Dry Hole _____

Abandoned _____


Date

10/24, 1912 Candell Scout

Map No. _____ Sec. 29 Twp. 26 R. 5
 Well No. 1 Kennedy Farm _____
Leonard et al Company _____

NORTH

WEST

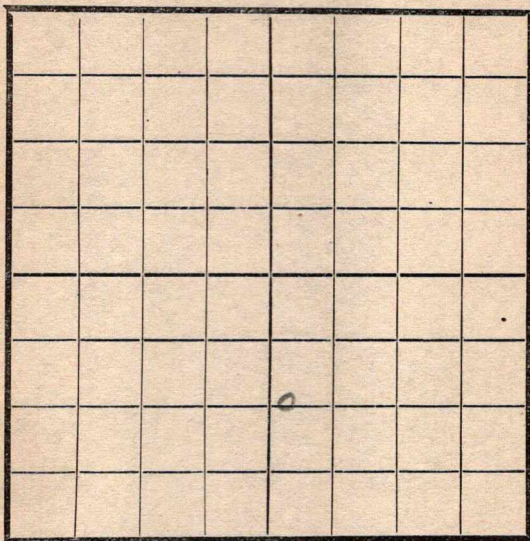

EAST

SOUTH

Location _____
 Rig Up _____
 Drilling and remarks _____

210 780'

RECORD

Cased _____ in. _____ Ft.
 Sand _____
 Gas _____
 Oil _____
 Total Depth _____

PRODUCTION

1st 24 hrs. Nat. _____
 1st 24 hrs. after shot _____
 Gas _____ Cu. Ft.
 Dry Hole _____
 Abandoned _____


Date

11/3, 1917 Oyle Scout

Map No. _____ Sec. 29 Twp. 26 R. 5Well No. 1 Kennedy FarmLeonard et al Company

NORTH

WEST

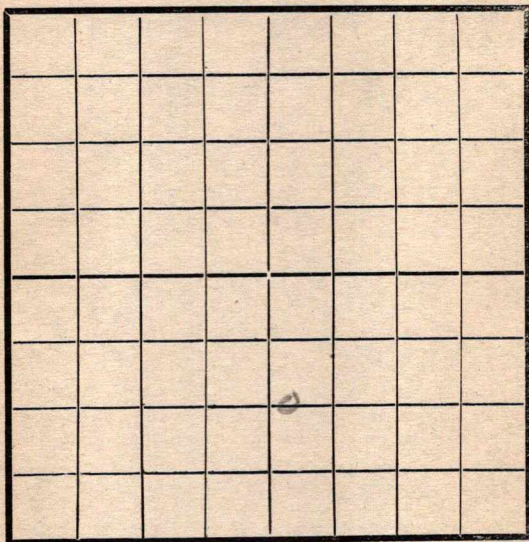

EAST

SOUTH

Location _____

Rig Up _____

Drilling and remarks

RECORD

Cased _____ in _____ Ft.

Sand _____

Gas _____

Oil _____

Total Depth _____

PRODUCTION

1st 24 hrs. Nat. _____

1st 24 hrs. after shot _____

Gas _____ Cu. Ft.

Dry Hole _____

Abandoned _____

Date


11/10, 1917 By Scout

Map No. _____ Sec. 29 Twp. 26 R. 5Well No. 1 Kennedy Farm _____Leonard et al Company _____

NORTH

WEST

EAST

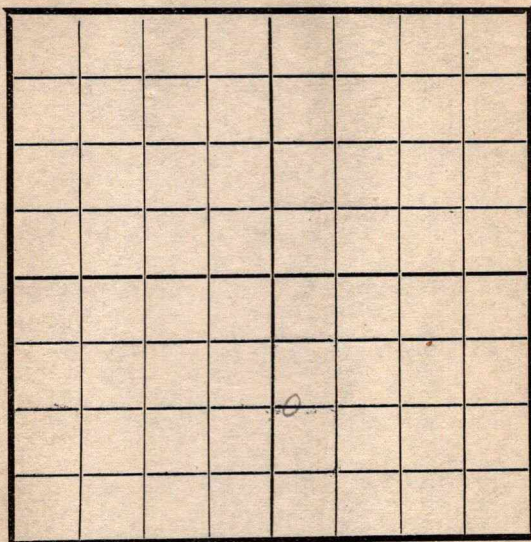

SOUTH

Location _____

Rig Up _____

Drilling and remarks

RECORD

Cased _____ in. _____ Ft.

Sand _____

Gas _____

Oil _____

Total Depth _____

PRODUCTION

1st 24 hrs. Nat. _____

1st 24 hrs. after shot _____

Gas _____ Cu. Ft.

Dry Hole _____

Abandoned _____


Date

11/14, 1917 Pyle Scout

Map No. _____ Sec. 29 Twp. 24 R. 5Well No. 1 Kennedy FarmLeonard et al Company

NORTH

WEST

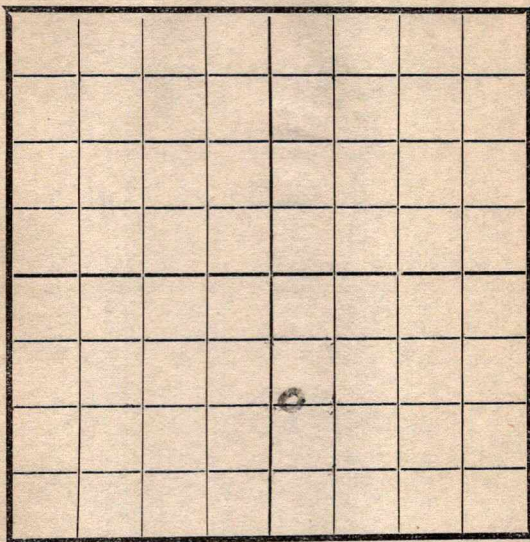

EAST

SOUTH

RECORD

Location _____

Cased _____ in _____ Ft.

Rig Up _____

Sand _____

Drilling and remarks

Gas _____

Oil _____

Total Depth _____

PRODUCTION

1st 24 hrs. Nat. _____

1st 24 hrs. after shot _____

Gas _____ Cu. Ft.

Dry Hole _____

Abandoned _____


Date

11/21, 1917 Pyle Scout

Map No. _____ Sec. 29 Twp. 26 R. 5Well No. 1 Kennedy FarmLeonard et al Company

NORTH

WEST

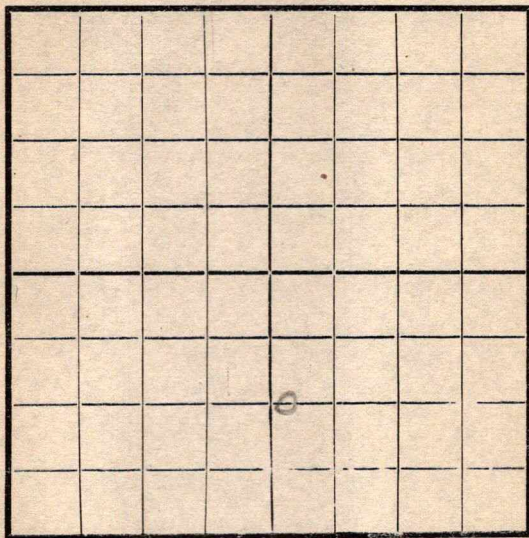

EAST

SOUTH

Location _____

Rig Up _____

Drilling and remarks

RECORD

Cased _____ in. _____ Ft.

Sand _____

Gas _____

Oil _____

Total Depth _____

PRODUCTION

1st 24 hrs. Nat. _____

1st 24 hrs. after shot _____

Gas _____ Cu. Ft.

Dry Hole _____

Abandoned _____


Date

11/28, 1917 Pyle Scout

Map No. _____ Sec. 29 Twp. 26 R. 5Well No. 1 Kennedy FarmLeonard et al Company

NORTH

WEST

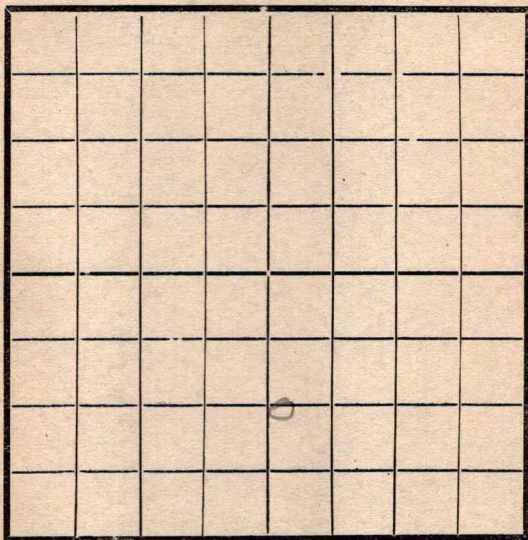

EAST

SOUTH

RECORD

Location _____

Cased _____ in. _____ Ft.

Rig Up _____

Sand _____

Drilling and remarks

Gas _____

Oil _____

Total Depth _____

PRODUCTION

1st 24 hrs. Nat. _____

1st 24 hrs. after shot _____

Gas _____ Cu. Ft.

Dry Hole _____

Abandoned _____


Date

12/5, 1917Pyle Scout

Map No. _____ Sec. 29 Twp. 26 R. 5Well No. 1 Kennedy Farm
Leonard et al Company

NORTH

WEST

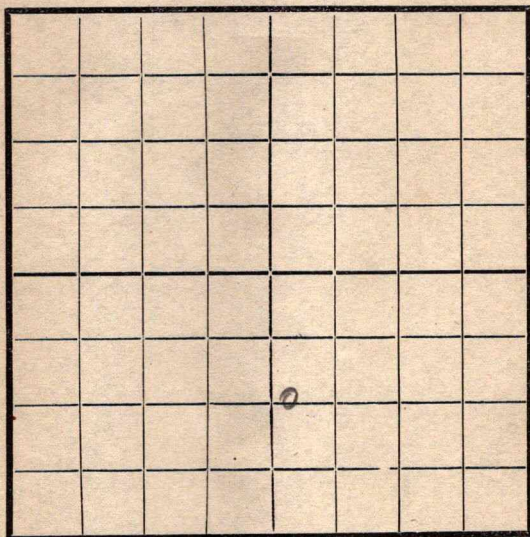

EAST

SOUTH

RECORD

Location _____

Cased _____ in. _____ Ft.

Rig Up _____

Sand _____

Drilling and remarks

Gas _____

Oil _____

Total Depth _____

PRODUCTION

1st 24 hrs. Nat. _____

1st 24 hrs. after shot _____

Gas _____ Cu. Ft.

Dry Hole _____

Abandoned _____

Date

12/22, 1917 Pyle Scout

Map No. _____ Sec. 29 Twp. 26 R. 5Well No. 1 Kennedy FarmLeonard et al Company

NORTH

WEST

EAST

SOUTH

RECORD

Location _____

Cased _____ in. _____ Ft.

Rig Up _____

Sand _____

Drilling and remarks

Gas _____

Oil _____

Total Depth _____

PRODUCTION

1st 24 hrs. Nat. _____

1st 24 hrs. after shot _____

Gas _____ Cu. Ft.

Dry Hole _____

Abandoned _____

Date


12/27 1917 Pyle Scout

Map No. 41009 K14 Sec. 29 Twp 26 R. 5

Well No. 1 Kinney Farm
Leonard Company

NORTH

WEST

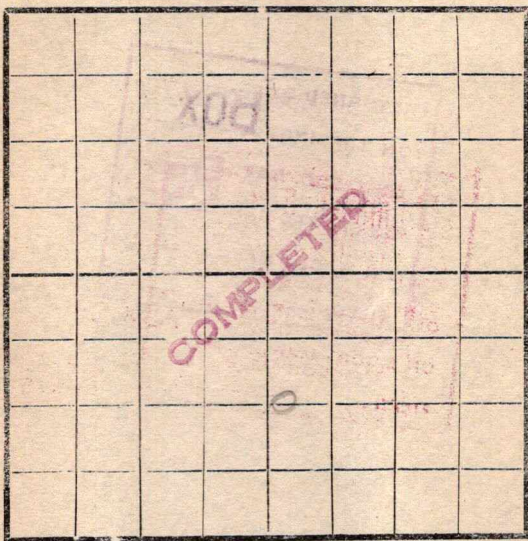

EAST

SOUTH

RECORD

Location -----

Cased ----- in. ----- Ft.

Rig Up -----

Sand 2707-2719

Drilling and remarks -----

Gas -----

Oil 300 bbls

Total Depth -----

PRODUCTION

1st 24 hrs. Nat. -----

1st 24 hrs. after shot -----

Gas ----- Cu. Ft.

Dry Hole -----

Abandoned -----

Date

1/4, 1918 Pyle Scout