


Map No. _____ Sec. 25 Twp. 26 R. 5
 Well No. 3 ~~X~~ Sluss Farm _____
Inland Oil & Co. Company _____

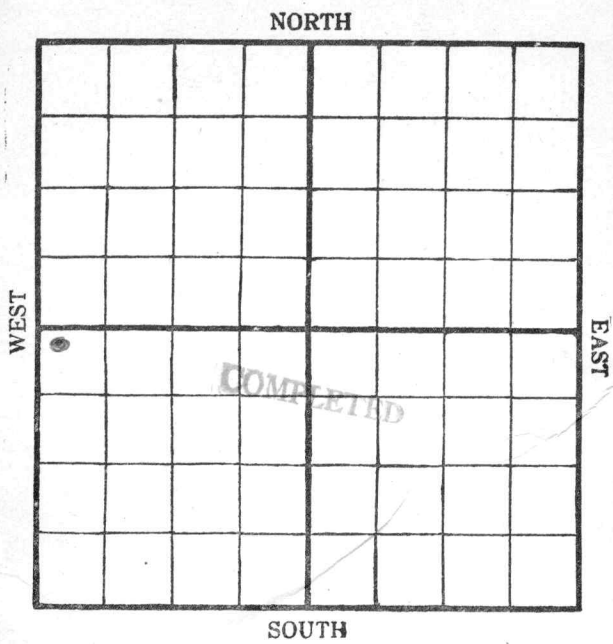

Location 250' N + W

Rig Up _____

Drilling Remarks:

Drilling Remarks:

Shot 10 gts.

RECORD

PRODUCTION

Cased _____ in. _____ ft.

1st 24 hrs. Nat. _____

Sand 2698' - 2760'

1st 24 hrs. after shot 60 bbls.

Gas _____

Gas _____ cu. ft.

Oil _____

Dry Hole _____

Total Depth _____

Abandoned _____


Map No. K14 Sec. 25 Twp. 26 R. 5Well No. 4 SlussInland Oil et al Company

Contractor

NORTH

WEST

EAST

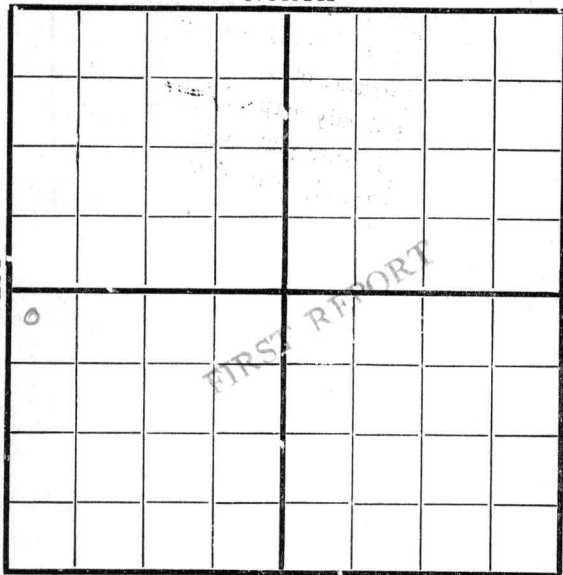

SOUTH

Location 250 N42Rig up ☒

Drilling and Remarks:

✓

RECORD

Cased _____ in., _____ ft.

Sand _____

Gas _____

Oil _____

Total Depth _____

PRODUCTION

1st 24 hrs. Nat. _____

1st 24 hrs. after shot _____

Gas _____ Cu. Ft.

Dry Hole _____

Abandoned _____

Date

9/19

1918

Cyle

Scout

Map No. K14 Sec. 25 Twp. 26 R. 5

Well No. 3 Shuss

Inland Oil et al Company

Contractor

NORTH							
WEST							
SOUTH							

Location 250-N
250-W

Rig up ✓

Drilling and Remarks:

Change the number of this well to No 3.

RECORD

Cased _____ in., _____ ft.

Sand _____

Gas _____

Oil _____

Total Depth _____

PRODUCTION

1st 24 hrs. Nat. _____

1st 24 hrs. after shot _____

Gas _____ Cu. Ft.

Dry Hole _____

Abandoned _____

Date

9/25 1918 **Pyle** Scout

Well No. 3 Shuss
Inland Oil and Company

Contractor

NORTH

WEST

EAST

SOUTH

Location 250 N-W

Rig up-----

Drilling and Remarks:

400'

RECORD

Cased-----in., -----ft.

Sand_____

Gas _____

Oil_____

Total Depth_____

PRODUCTION

1st 24 hrs. Nat. -----

1st 24 hrs. after shot_____

Gas.....Cu. Ft.

Dry Hole.....

Abandoned_____

Date _____

10/2

191

Pyle

Scout


Map No. K14 Sec. 25 Twp. 26 R. 5Well No. 3 ShussInland Oil & Gas Company

Contractor

NORTH

WEST

EAST

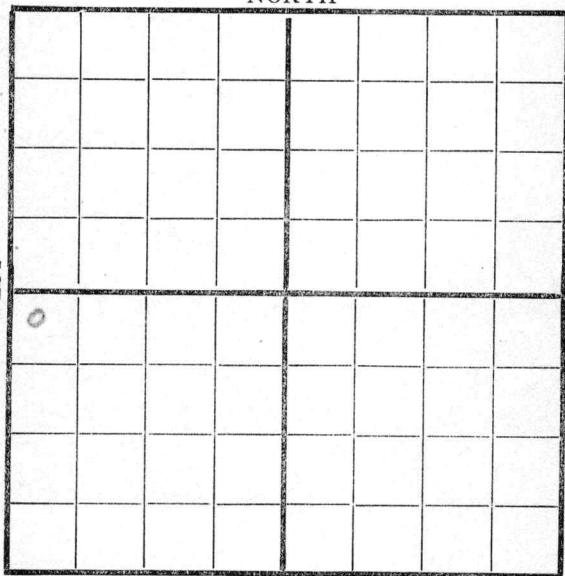

SOUTH

Location 250 N-W

Rig up _____

Drilling and Remarks:

210 @
400'

RECORD

Cased _____ in., _____ ft.

Sand _____

Gas _____

Oil _____

Total Depth _____

PRODUCTION

1st 24 hrs. Nat. _____

1st 24 hrs. after shot _____

Gas _____ Cu. Ft.

Dry Hole _____

Abandoned _____

Date

10/8 1918 Pyle Scout

Map No. K14 Sec. 25 Twp. 26 R. 5

Well No. 3 Shuss
Inland Oil and Company

Company

Contractor

NORTH

WEST

EAST

SOUTH

Location 250 N. W

Rig up_____

Drilling and Remarks:

fish Tools
@
660

RECORD

Cased-----in., -----ft.

Sand_____

Gas -----

Oil _____

Total Depth_____

PRODUCTION

1st 24 hrs. Nat. _____

1st 24 hrs. after shot-----

Gas.....Cu. Ft.

Dry Hole

Abandoned_____

Date _____

10/ 191 8

Pyle


Scout

Map No. K14 Sec. 25 Twp. 26 R. 5Well No. 3 Bluss
Inland Oil et al Company

Contractor _____

NORTH

WEST

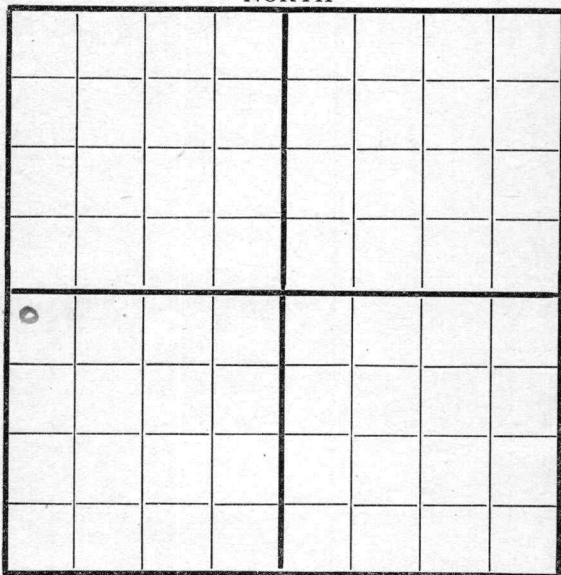

EAST

SOUTH

Location 250 N. W

Rig up _____

Drilling and Remarks:

fish @
660

RECORD

Cased _____ in., _____ ft.

Sand _____

Gas _____

Oil _____

Total Depth _____

PRODUCTION

1st 24 hrs. Nat. _____

1st 24 hrs. after shot _____

Gas _____ Cu. Ft.

Dry Hole _____

Abandoned _____


Date

10/26
1918

Pyle

Scout

Map No. K14 Sec. 25 Twp. 26 R. 5
Well No. 3
Inland Oil & Gas Company
Contractor

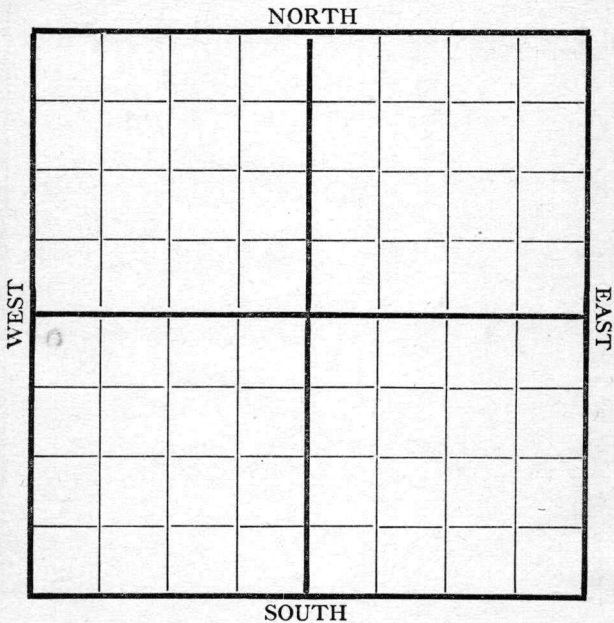

Location <u>250 NW</u> Rig up _____ Drilling and Remarks: <u>fishing @</u> <u>660'</u>	RECORD Cased _____ in., _____ ft. Sand _____ Gas _____ Oil _____ Total Depth _____
	PRODUCTION 1st 24 hrs. Nat. _____ 1st 24 hrs. after shot _____ Gas _____ Cu. Ft. Dry Hole _____ Abandoned _____

Date 11/6 1918 Pyle Scout

Map No. K14 Sec. 25 Twp. 24 R. 5Well No. 3 Skid rig
Inland Oil and Gas Company

Contractor

NORTH

WEST

EAST

SOUTH

Location 250 N 9 W

Rig up

Drilling and Remarks:

Skid rig

RECORD

Cased _____ in., _____ ft.

Sand _____

Gas _____

Oil _____

Total Depth _____

PRODUCTION

1st 24 hrs. Nat. _____

1st 24 hrs. after shot _____

Gas _____ Cu. Ft.

Dry Hole _____

Abandoned _____

Date

11/131918


Pyle

Scout

Map No. 1514 Sec. 25 Twp. 26 R. 5Well No. 3 Sluoso
Donland Oil et al Company

Contractor

NORTH

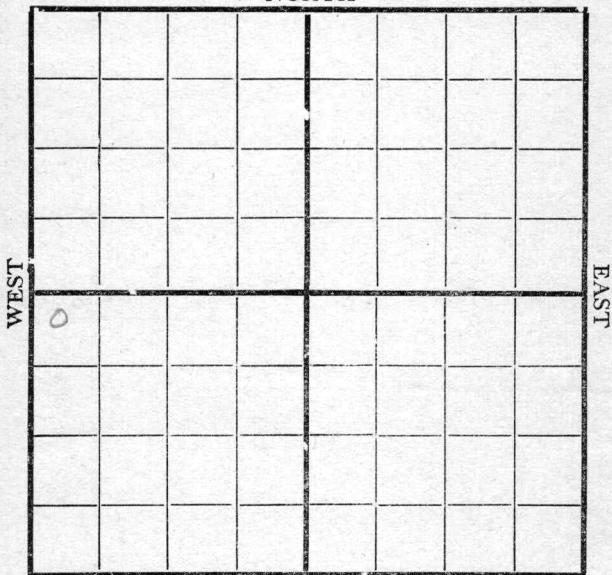

SOUTH

250 NW

Location _____

Rig up _____

Drilling and Remarks:

800'

RECORD

Cased _____ in., _____ ft.

Sand _____

Gas _____

Oil _____

Total Depth _____

PRODUCTION

1st 24 hrs. Nat. _____

1st 24 hrs. after shot _____

Gas _____ Cu. Ft.

Dry Hole _____

Abandoned _____

Date

11/21 1918 Cryb Scout


Map No. 1514 Sec. 25 Twp. 26 R. 5Well No. 3 ShuroIndiant Oil Co. Company

Contractor

NORTH

WEST

EAST

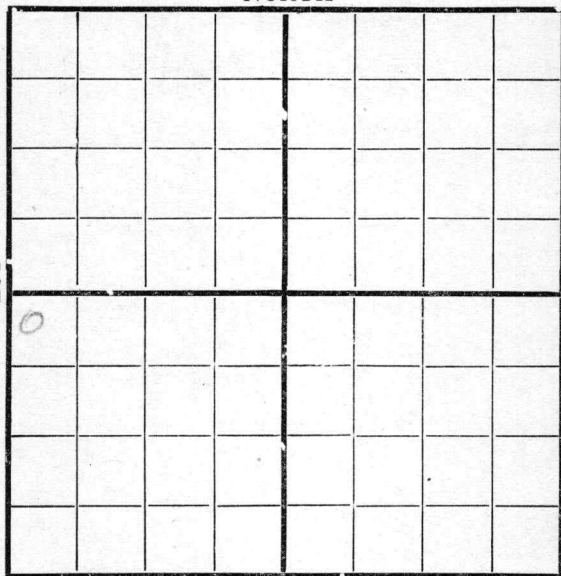

SOUTH

250 N-W

Location _____

Rig up _____

Drilling and Remarks:

RECORD

Cased _____ in., _____ ft.

Sand _____

Gas _____

Oil _____

Total Depth _____

PRODUCTION

1st 24 hrs. Nat. _____

1st 24 hrs. after shot _____

Gas _____ Cu. Ft.

Dry Hole _____

Abandoned _____

Date

11/29

191

Pyle

Scout

Map No. 1514 Sec. 25 Twp. 26 R. 5

Well No. 3 Shuro


Inland Oil & Gas Company

Contractor

NORTH

WEST

EAST

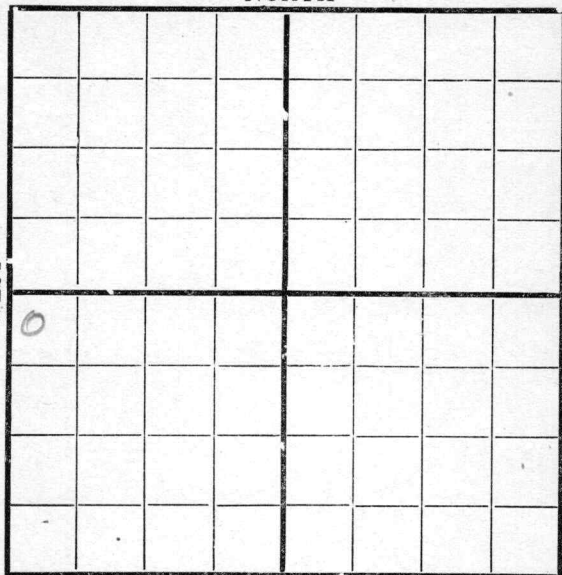

SOUTH

250 N-W

Location _____

Rig up _____

Drilling and Remarks:

D. D. for
10" @ 1050'

RECORD

Cased _____ in., _____ ft.

Sand _____

Gas _____

Oil _____

Total Depth _____

PRODUCTION

1st 24 hrs. Nat. _____

1st 24 hrs. after shot _____

Gas _____ Cu. Ft.

Dry Hole _____

Abandoned _____

Date

12/5 1918 Pyle Scout


Map No. K14 Sec. 25 Twp. 26 R. 5Well No. 3 Sluss
Inland Oil et al Company

Contractor

NORTH

WEST

EAST

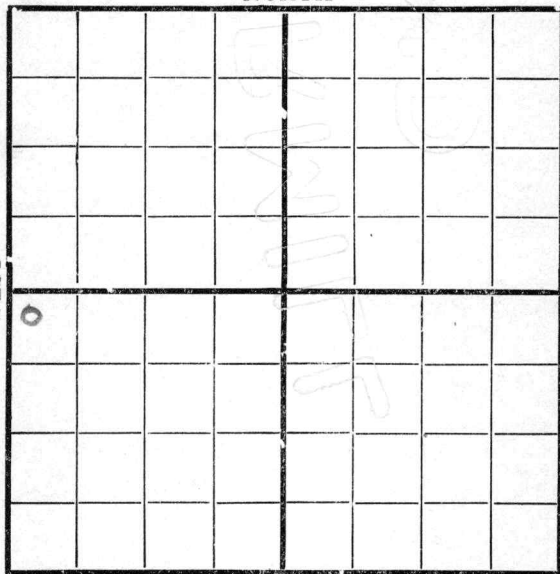

250 N-W SOUTH

Location _____

Rig up _____

Drilling and Remarks:

2000'

RECORD

Cased _____ in., _____ ft.

Sand _____

Gas _____

Oil _____

Total Depth _____

PRODUCTION

1st 24 hrs. Nat. _____

1st 24 hrs. after shot _____

Gas _____ Cu. Ft.

Dry Hole _____

Abandoned _____

Date

12/12 1918

H. B.

Scout

Map No. K14 Sec. 25 Twp. 26 R. 5Well No. 3Portland Oil & Gas Company

Contractor

NORTH

WEST

EAST

250 N-W SOUTH

Location

Rig up

Drilling and Remarks:

2390'

RECORD

Cased.....in.,ft.

Sand.....

Gas.....

Oil.....

Total Depth.....

PRODUCTION

1st 24 hrs. Nat.

1st 24 hrs. after shot.....

Gas.....Cu. Ft.

Dry Hole.....

Abandoned.....

Date

12/18

191


Pyle

Scout

Map No. 1514 Sec. 25 Twp. 26 R. 5Well No. 3 ShussInland Oil et al Company

Contractor

NORTH

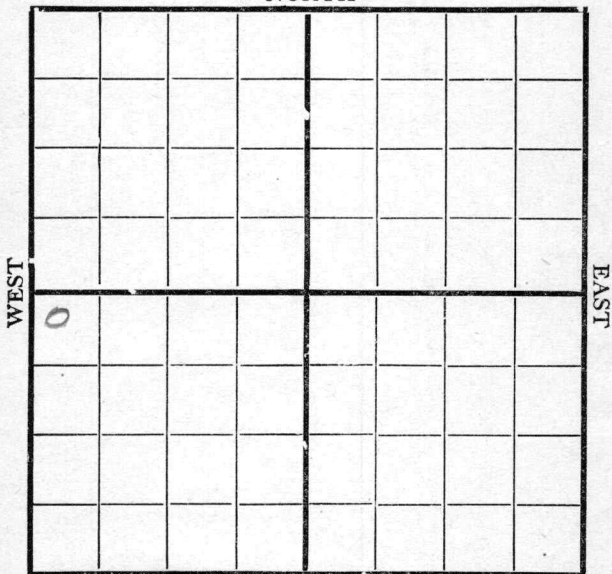250 A-W SOUTH

Location _____

Rig up _____

Drilling and Remarks:

D 10 @
2390'

RECORD

Cased _____ in., _____ ft.

Sand _____

Gas _____

Oil _____

Total Depth _____

PRODUCTION

1st 24 hrs. Nat. _____

1st 24 hrs. after shot _____

Gas _____ Cu. Ft.

Dry Hole _____

Abandoned _____

Date

12/27 1918 Pyle Scout


Map No. 1514 Sec. 25 Twp. 26 R. 5Well No. 3 ShussInland Oil and Gas Company

Contractor

NORTH

WEST

EAST

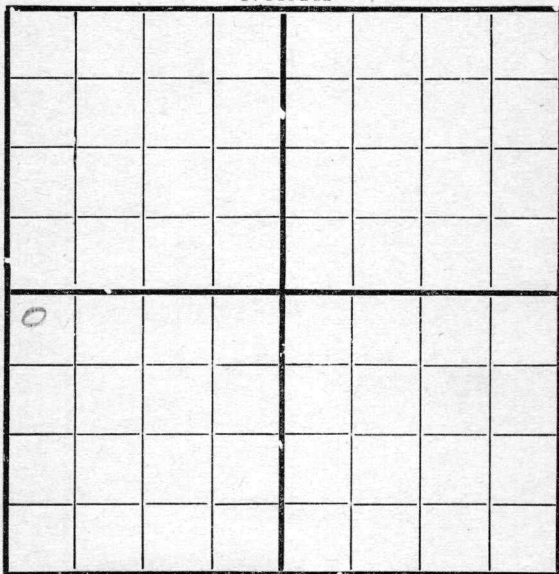

SOUTH

2507A-W

Location _____

Rig up _____

Drilling and Remarks:

D. W. @
2390'

RECORD

Cased _____ in., _____ ft.

Sand _____

Gas _____

Oil _____

Total Depth _____

PRODUCTION

1st 24 hrs. Nat. _____

1st 24 hrs. after shot _____

Gas _____ Cu. Ft.

Dry Hole _____

Abandoned _____

Date

Jan 16 1914Pyle

Scout


Map No. *K14* Sec. *25* Twp. *26* R. *5*Well No. *3 Sluss**Inland Oil et al* Company

Contractor

NORTH

WEST

EAST

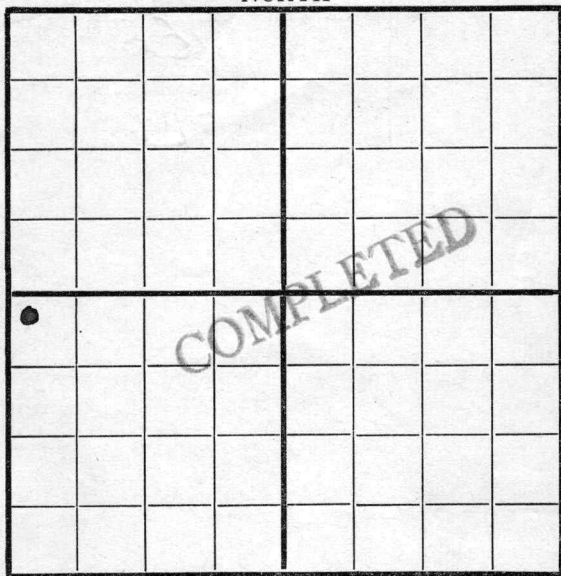*250' N.-W.* SOUTH

Location _____

Rig up _____

Drilling and Remarks:

Shot 10 Qts.

RECORD

Cased _____ in., _____ ft.

Sand *2698-2760*

Gas _____

Oil _____

Total Depth _____

PRODUCTION

1st 24 hrs. Nat. _____

1st 24 hrs. after shot *60 Bbls*

Gas _____ Cu. Ft.

Dry Hole _____

Abandoned _____

Date

Jan. 21 191*9* *Pyle* Scout