


Map No. \_\_\_\_\_ Sec. 25 Twp. 26 E. 5Well No. 3 Sluss FarmGreat Plains Company

NORTH

WEST

EAST

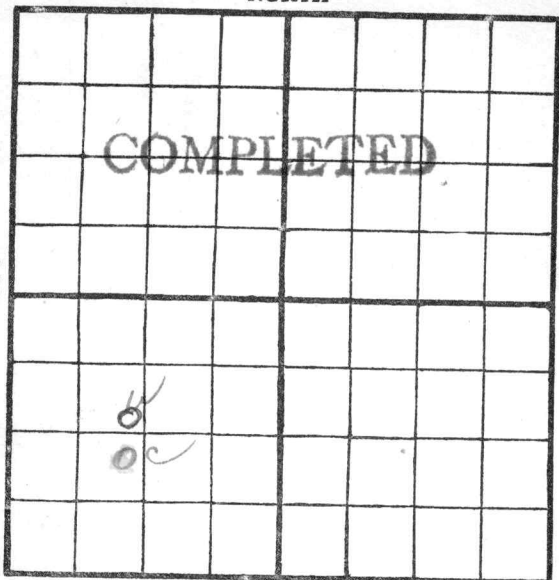

SOUTH

Location \_\_\_\_\_

Rig Up \_\_\_\_\_

Drilling Remarks:

25 Bbls (Sand) 2736-2750

Drilling Remarks:

6/20/18

## RECORD

Cased \_\_\_\_\_ in. \_\_\_\_\_ ft.

Sand \_\_\_\_\_

Gas \_\_\_\_\_

Oil \_\_\_\_\_

Total Depth \_\_\_\_\_

## PRODUCTION

1st 24 hrs. Nat. \_\_\_\_\_

1st 24 hrs. after shot \_\_\_\_\_

Gas \_\_\_\_\_ cu. ft

Dry Hole \_\_\_\_\_


Abandoned \_\_\_\_\_

L1009  
 Map No. 414 Sec. 25 Twp. 26 R. 5  
 Well No. 3 slugs Farm  
Great Plains Company

NORTH

WEST

EAST

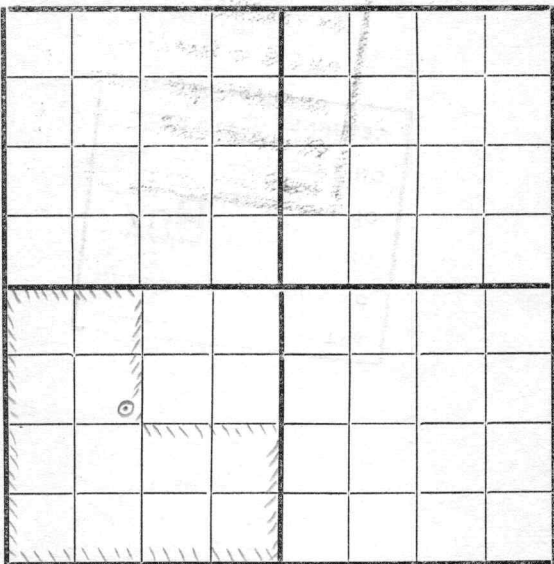

SOUTH

Location \_\_\_\_\_

Rig Up ☒ \_\_\_\_\_

Drilling and remarks

This is  
 now the  
 Great Plains  
 oil com.

## RECORD

Cased \_\_\_\_\_ in. \_\_\_\_\_ Ft.

Sand \_\_\_\_\_

Gas \_\_\_\_\_

Oil \_\_\_\_\_

Total Depth \_\_\_\_\_

## PRODUCTION

1st 24 hrs. Nat. \_\_\_\_\_

1st 24 hrs. after shot \_\_\_\_\_

Gas \_\_\_\_\_ Cu. Ft.

Dry Hole \_\_\_\_\_

Abandoned \_\_\_\_\_

Date

1/10, 1918 Pyle Scout

Map No. \_\_\_\_\_ Sec. 25 Twp. 26 R. 5  
 Well No. 3 Sluss Farm \_\_\_\_\_  
Great Plains Company \_\_\_\_\_

NORTH

|      |  |  |  |  |  |  |  |      |
|------|--|--|--|--|--|--|--|------|
| WEST |  |  |  |  |  |  |  | EAST |
|      |  |  |  |  |  |  |  |      |
|      |  |  |  |  |  |  |  |      |
SOUTH

|                                                                          |                              |
|--------------------------------------------------------------------------|------------------------------|
| Location _____<br>Rig Up _____<br>Drilling and remarks<br><u>Timbers</u> | <b>RECORD</b>                |
|                                                                          | Cased _____ in. _____ Ft.    |
|                                                                          | Sand _____                   |
|                                                                          | Gas _____                    |
|                                                                          | Oil _____                    |
|                                                                          | Total Depth _____            |
|                                                                          | <b>PRODUCTION</b>            |
|                                                                          | 1st 24 hrs. Nat. _____       |
|                                                                          | 1st 24 hrs. after shot _____ |
|                                                                          | Gas _____ Cu. Ft.            |
|                                                                          | Dry Hole _____               |
|                                                                          | Abandoned _____              |

Date 7/6, 1918 Pyle Scout


Map No. \_\_\_\_\_ Sec. 25 Twp. 26 R. 5

Well No. 3 slush Farm \_\_\_\_\_

Great Plains Company \_\_\_\_\_

NORTH

WEST

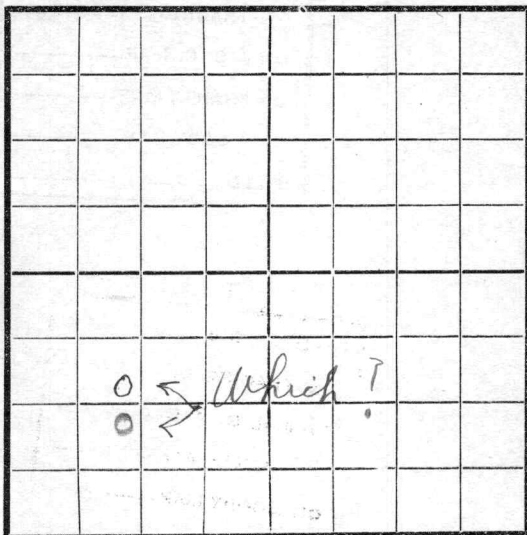

EAST

SOUTH

Location \_\_\_\_\_

Rig Up \_\_\_\_\_

Drilling and remarks

Timbers

### RECORD

Cased \_\_\_\_\_ in. \_\_\_\_\_ Ft.

Sand \_\_\_\_\_

Gas \_\_\_\_\_

Oil \_\_\_\_\_

Total Depth \_\_\_\_\_

### PRODUCTION

1st 24 hrs. Nat. \_\_\_\_\_

1st 24 hrs. after shot \_\_\_\_\_

Gas \_\_\_\_\_ Cu. Ft.

Dry Hole \_\_\_\_\_

Abandoned \_\_\_\_\_


Date

2/12, 1918 Pyre Scout

Map No. \_\_\_\_\_ Sec. 25 Twp. 26 R. 5Well No. 3 Shuco Farm  
Great Plains Company

NORTH

WEST

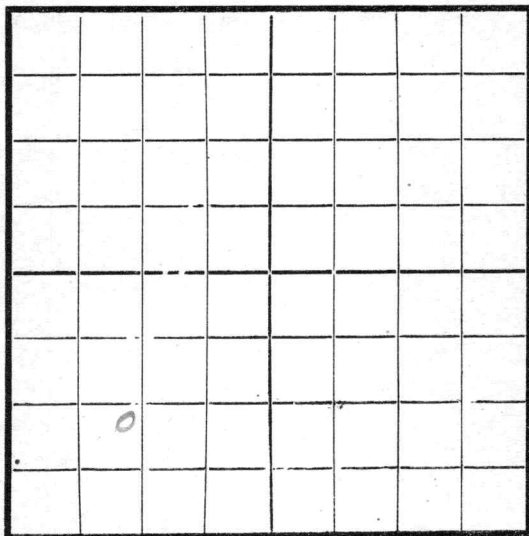

EAST

SOUTH

Location \_\_\_\_\_

Rig Up \_\_\_\_\_

Drilling and remarks

## RECORD

Cased \_\_\_\_\_ in. \_\_\_\_\_ Ft.

Sand \_\_\_\_\_

Gas \_\_\_\_\_

Oil \_\_\_\_\_

Total Depth \_\_\_\_\_

## PRODUCTION

1st 24 hrs. Nat. \_\_\_\_\_

1st 24 hrs. after shot \_\_\_\_\_

Gas \_\_\_\_\_ Cu. Ft.

Dry Hole \_\_\_\_\_

Abandoned \_\_\_\_\_


Date

1/17, 1918Cyle Scout

Map No. \_\_\_\_\_ Sec. 25 Twp. 26 R. 5Well No. 3 Sluss FarmGreat Plains Company

NORTH

WEST

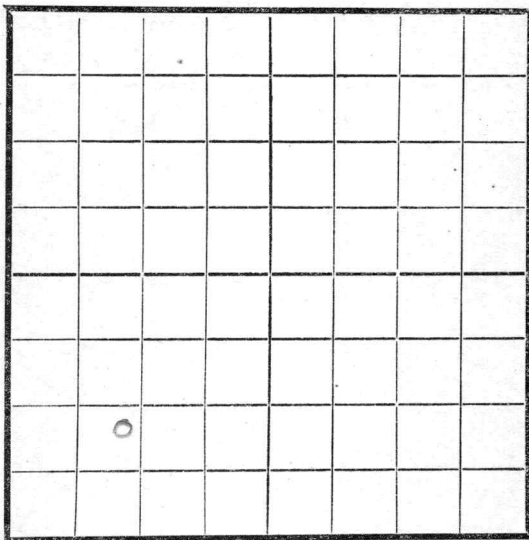

EAST

SOUTH

Location \_\_\_\_\_

Rig Up \_\_\_\_\_

Drilling and remarks

## RECORD

Cased \_\_\_\_\_ in. \_\_\_\_\_ Ft.

Sand \_\_\_\_\_

Gas \_\_\_\_\_

Oil \_\_\_\_\_

Total Depth \_\_\_\_\_

## PRODUCTION

1st 24 hrs. Nat. \_\_\_\_\_

1st 24 hrs. after shot \_\_\_\_\_

Gas \_\_\_\_\_ Cu. Ft.

Dry Hole \_\_\_\_\_

Abandoned \_\_\_\_\_

Date


4/23, 1918 C. G. C. G. C. Scout

Map No. \_\_\_\_\_ Sec. 25 Twp. 26 R. 5

Well No. 3 Shyos Farm \_\_\_\_\_  
Great Plains Company

NORTH

WEST

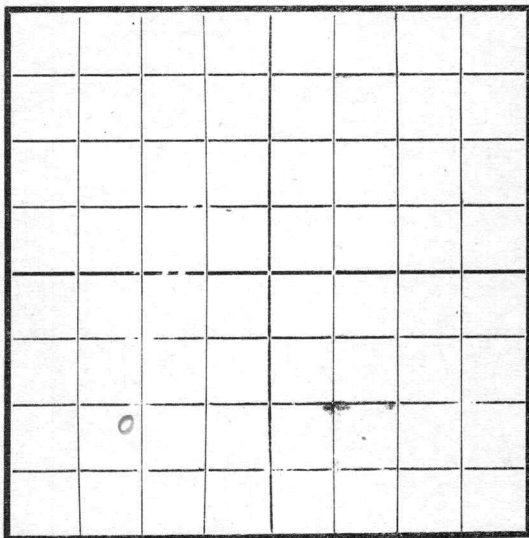

EAST

SOUTH

Location \_\_\_\_\_

Rig Up \_\_\_\_\_

Drilling and remarks

1200'

RECORD

Cased \_\_\_\_\_ in. \_\_\_\_\_ Ft.

Sand \_\_\_\_\_

Gas \_\_\_\_\_

Oil \_\_\_\_\_

Total Depth \_\_\_\_\_

PRODUCTION

1st 24 hrs. Nat. \_\_\_\_\_

1st 24 hrs. after shot \_\_\_\_\_

Gas \_\_\_\_\_ Cu. Ft.

Dry Hole \_\_\_\_\_

Abandoned \_\_\_\_\_


Date

5/1, 1918 Oyle Scout

Map No. \_\_\_\_\_ Sec. 25 Twp 26 R. 5Well No. 3 Shuss Farm  
Great Plains Company

NORTH

WEST

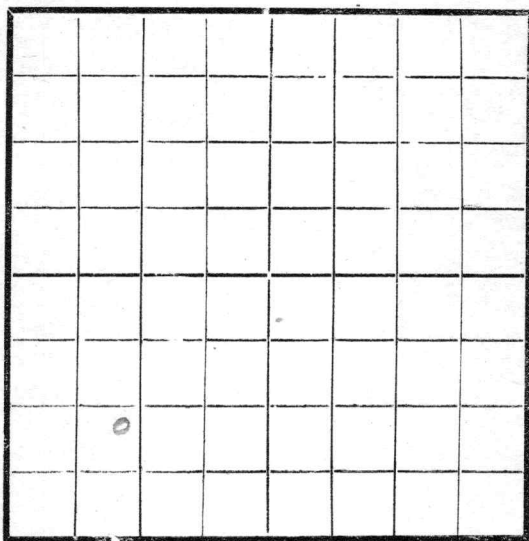

SOUTH

Location \_\_\_\_\_

Rig Up \_\_\_\_\_

Drilling and remarks \_\_\_\_\_

## RECORD

Cased \_\_\_\_\_ in. \_\_\_\_\_ Ft.

Sand \_\_\_\_\_

Gas \_\_\_\_\_

Oil \_\_\_\_\_

Total Depth \_\_\_\_\_

## PRODUCTION

1st 24 hrs. Nat. \_\_\_\_\_

1st 24 hrs. after shot \_\_\_\_\_

Gas \_\_\_\_\_ Cu. Ft.

Dry Hole \_\_\_\_\_

Abandoned \_\_\_\_\_


Date

5/8, 1918 Scout

Map No. \_\_\_\_\_ Sec. 25 Twp. 26 R. 5  
 Well No. 3 Shus Farm \_\_\_\_\_  
Great Plains Company

NORTH

WEST

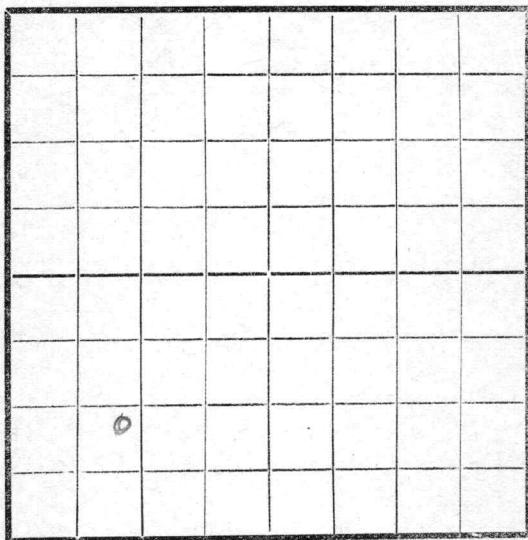

EAST

SOUTH

Location \_\_\_\_\_

Rig Up \_\_\_\_\_

Drilling and remarks

## RECORD

Cased \_\_\_\_\_ in. \_\_\_\_\_ Ft.

Sand \_\_\_\_\_

Gas \_\_\_\_\_

Oil \_\_\_\_\_

Total Depth \_\_\_\_\_

## PRODUCTION

1st 24 hrs. Nat. \_\_\_\_\_

1st 24 hrs. after shot \_\_\_\_\_

Gas \_\_\_\_\_ Cu. Ft.

Dry Hole \_\_\_\_\_

Abandoned \_\_\_\_\_

Date

5/14, 198 Cyle Scout

Map No. \_\_\_\_\_ Sec. 25 Twp. 26 R. 5  
 Well No. 3 Shus  
Great Plains Company  
 Contractor \_\_\_\_\_


|  |  |  |  |  |  |  |  |
|--|--|--|--|--|--|--|--|
|  |  |  |  |  |  |  |  |
|  |  |  |  |  |  |  |  |
SOUTH

|                       |                              |
|-----------------------|------------------------------|
| Location _____        | <b>RECORD</b>                |
| Rig up _____          | Cased _____ in., _____ ft.   |
| Drilling and Remarks: | Sand _____                   |
|                       | Gas _____                    |
|                       | Oil _____                    |
|                       | Total Depth _____            |
|                       | <b>PRODUCTION</b>            |
|                       | 1st 24 hrs. Nat. _____       |
|                       | 1st 24 hrs. after shot _____ |
|                       | Gas _____ Cu. Ft.            |
|                       | Dry Hole _____               |
|                       | Abandoned _____              |

Date 5/25/18 Pyke Scout  
 191

Map No. \_\_\_\_\_ Sec. 25 Twp. 26 R. 5  
 Well No. 3 Slush  
Great Plains Company  
 \_\_\_\_\_ Contractor

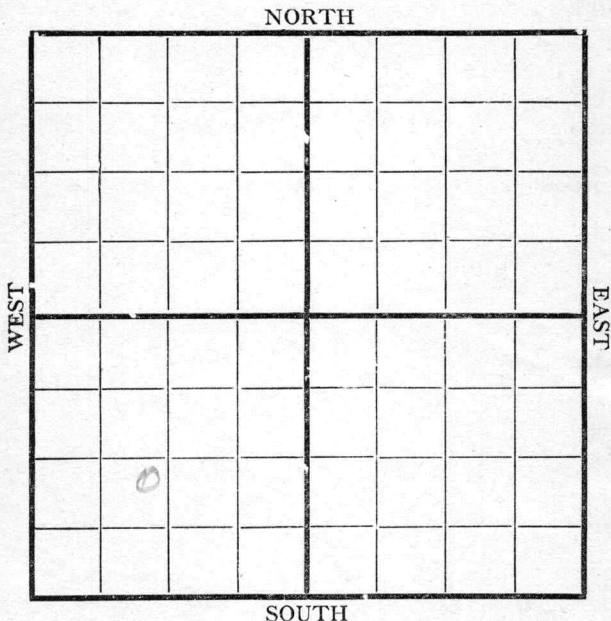

|                       | RECORD                       |
|-----------------------|------------------------------|
| Location _____        | Cased _____ in., _____ ft.   |
| Rig up _____          | Sand _____                   |
| Drilling and Remarks: | Gas _____                    |
|                       | Oil _____                    |
|                       | Total Depth _____            |
|                       | <hr/> <hr/>                  |
|                       | PRODUCTION                   |
|                       | 1st 24 hrs. Nat. _____       |
|                       | 1st 24 hrs. after shot _____ |
|                       | Gas _____ Cu. Ft.            |
|                       | Dry Hole _____               |
|                       | Abandoned _____              |

Date 5/29 1918 Dry Scout


Map No. \_\_\_\_\_ Sec. 25 Twp. 26 R. 5Well No. 3 SlushGreat Plains Company

Contractor \_\_\_\_\_

NORTH

WEST

EAST

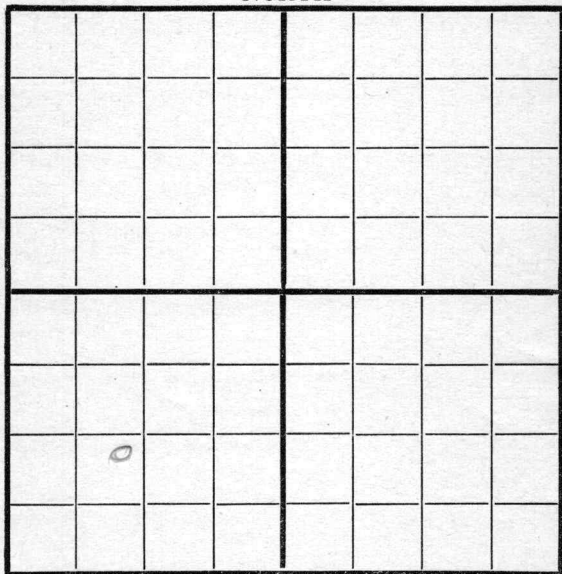

SOUTH

Location \_\_\_\_\_

Rig up \_\_\_\_\_

Drilling and Remarks:

D. Da  
2660 for  
casing

## RECORD

Cased \_\_\_\_\_ in., \_\_\_\_\_ ft.

Sand \_\_\_\_\_

Gas \_\_\_\_\_

Oil \_\_\_\_\_

Total Depth \_\_\_\_\_

## PRODUCTION

1st 24 hrs. Nat. \_\_\_\_\_

1st 24 hrs. after shot \_\_\_\_\_

Gas \_\_\_\_\_ Cu. Ft.

Dry Hole \_\_\_\_\_

Abandoned \_\_\_\_\_

Date

6/3 1918 Oyle Scout

Map No. \_\_\_\_\_ Sec. 25 Twp. 26 R. 5  
 Well No. 3 Shusoo  
Great Plains Company  
 \_\_\_\_\_ Contractor

|      |  |  |  |       |  |  |  |      |  |  |  |  |
|------|--|--|--|-------|--|--|--|------|--|--|--|--|
|      |  |  |  | NORTH |  |  |  |      |  |  |  |  |
| WEST |  |  |  |       |  |  |  |      |  |  |  |  |
|      |  |  |  |       |  |  |  |      |  |  |  |  |
|      |  |  |  |       |  |  |  |      |  |  |  |  |
|      |  |  |  | SOUTH |  |  |  |      |  |  |  |  |
|      |  |  |  |       |  |  |  | EAST |  |  |  |  |

|                       |                              |
|-----------------------|------------------------------|
| Location _____        | <b>RECORD</b>                |
| Rig up _____          | Cased _____ in., _____ ft.   |
| Drilling and Remarks: | Sand _____                   |
|                       | Gas _____                    |
|                       | Oil _____                    |
|                       | Total Depth _____            |
|                       | <b>PRODUCTION</b>            |
|                       | 1st 24 hrs. Nat. _____       |
|                       | 1st 24 hrs. after shot _____ |
|                       | Gas _____ Cu. Ft.            |
|                       | Dry Hole _____               |
|                       | Abandoned _____              |

Date 4/11 1918 Lyb Scout


Map No. 124 K 14 Sec. 25 Twp. 26 R. 5Well No. 3 ShushGreat Plains Company

Contractor

NORTH

WEST

EAST

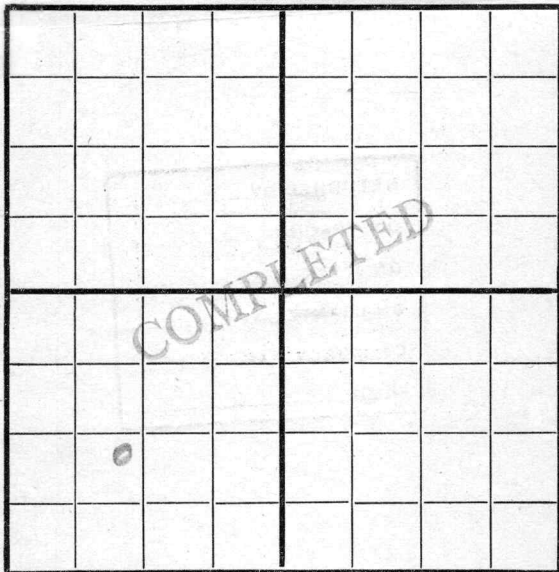

SOUTH

Location \_\_\_\_\_

Rig up \_\_\_\_\_

Drilling and Remarks:

Est 25 bbls

## RECORD

Cased \_\_\_\_\_ in., \_\_\_\_\_ ft.

Sand 2736 - 2750

Gas \_\_\_\_\_

Oil \_\_\_\_\_

Total Depth \_\_\_\_\_

## PRODUCTION

1st 24 hrs. Nat. \_\_\_\_\_

1st 24 hrs. after shot \_\_\_\_\_

Gas \_\_\_\_\_ Cu. Ft.

Dry Hole \_\_\_\_\_

Abandoned \_\_\_\_\_

Date

6/20 1918 Oyle Scout