
FORM 51 25M 8-50 WESTERN Butler KANSAS

Section 35 Township 27 Range 4E

Well No. #1 Hoopes

Company Wilbur Skaer-et al

6

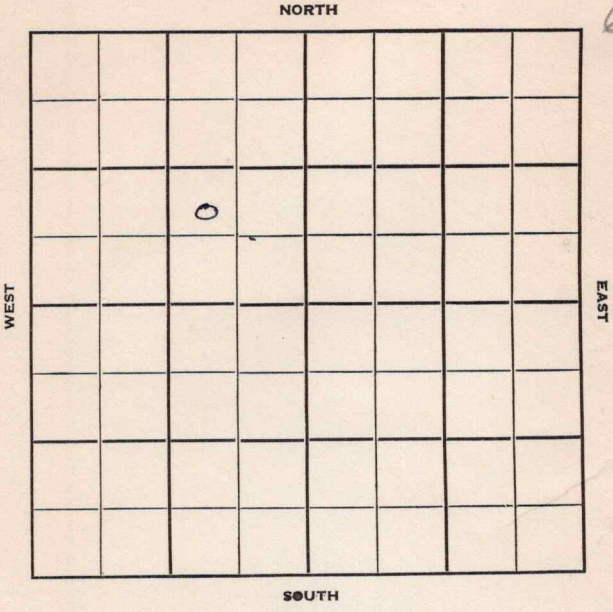

FORM 252-B
10M 8-51 TPCO.

Butler

KANSAS

Sec. 35 Twp. 27 R. 4E

Well No. #1 Hoopes Farm

Wilbur Skaer-et al Company

H. & M. Drlg. Contractor

Augusta


Ft. from N. Line

990' Ft. from S. Line

990' Ft. from E. Line

Ft. from W. Line

NW SE NW

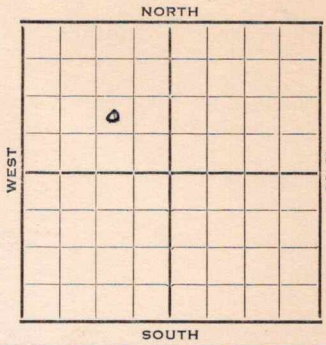

1952	Elev. 1273' REPORT
1/30	Spud 1-22-52 RTD 2597 5" @ 2597 WOC
2/6	TD 2597 5" @ 3597 Lans. 1640' KC 2012 Simp sd 2551 2nd Sch 2597
2/13	NR
3/26	Spud 1-22-52 Oil well TD 2612' Lans. 1640' KC 2012' 1st Simp. 2551' 2nd Simp 2597' TD 2612' FU 60' oil 200' water 12 hr. PB 2583' 48/2551-56 Hydro. S/8½ BO 6½ BW 12 hr. PB 2072' 24/2028-36 24/2039-47 1000 A 1½ BO 1½ BWPH 3000 A Comp. 15 BOPD

COMPLETED

FORM 275 FOR SALE BY KANSAS BLUE PRINT CO.


County Butler State Kansas

Sec. 35 (Blk. / Twp.) 27 (Sur. / Rge.) 4E Map No.

Operator Wilbur Skaer- Etal.

Well No. 1 Farm Hoopes

Elev. Location NW SE NW

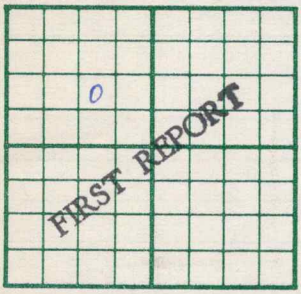

990 Ft. From S Line NW

990 Ft. From E Line Quarter

1st. Report JAN 3 0 1952

Completion

Remarks

H & M - Contr.

Spudding Date 1-22-52

Drlg. Data Augusta

RTD 2597 5" @ 2597 WOC

J. G. McGEHEE

FORM 275 FOR SALE BY KANSAS BLUE PRINT CO


County Butler State Kansas

Sec. 35 (Blk. Twp.) 27 (Sur. Rge.) 4E Map No.

Operator Wilbur Skaer etal.

Well No. 1 Farm Hoopes

Elev. 1273 Location NW SE NW

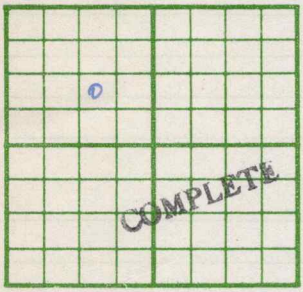

990 Ft. From S Line NW

990 Ft. From E Line Quarter

1st. Report

Completion MAR 26 1952

Remarks Augusta Pool

H & M Drlg. - Contr.

Spudding Date 1-22-52

Drlg. Data Oil well TD 2612

Lans. 1640 KC 2012 1st Simp. 2551

2nd Simp. 2597 TD 2612 FU 60' oil

200' water 12 hr. PB 2583 48/ 2551-56

Hydro. S/ 8½ bo 6½ bw 12 hr. PB 2072

24/ 2028-36 24/ 2039-47 1000 A

1½ bo 1½ bwph 3000 A

Comp. 15 bopd

J. G. McGEHEE