

Map No. 78 Sec. 29 Twp. 26 R. 5
 Well No. Keogler Farm
Leunis & Page Company

NORTH

WEST



EAST

SOUTH

Location _____

Rig Up _____

Drilling Remarks:

Drilling Remarks:

RECORD

Cased _____ in. _____ ft.

Sand _____

Gas _____

Oil _____

Total Depth _____

PRODUCTION

1st 24 hrs. Nat. _____

1st 24 hrs. after shot _____

Gas _____ cu. ft

Dry Hole _____

Abandoned _____

Map No. L1004 Sec. 29 Twp. 26 R. 5


Well No. 9 Tanager Farm

Lewis & Page Company

NORTH

WEST

EAST

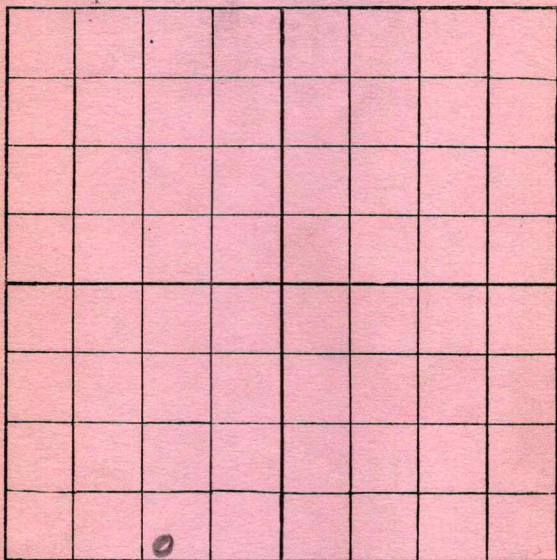

SOUTH

Location _____

Rig up ☒ _____

Drilling and remarks:

FIRST REPORT

RECORD

Cased _____ in. _____ Ft.

Sand _____

Gas _____

Oil _____

Total Depth _____

PRODUCTION

1st 24 hrs. Nat. _____

1st 24 hrs. after shot _____

Gas _____ Cu. Ft.

Dry Hole _____

Abandoned _____

Date


10/9, 1917, Candiff Scout

Map No. _____ Sec. 29 Twp. 26 R. 5

Well No. 9 Kroyer Farm
Reiner & Payne Company

NORTH

WEST

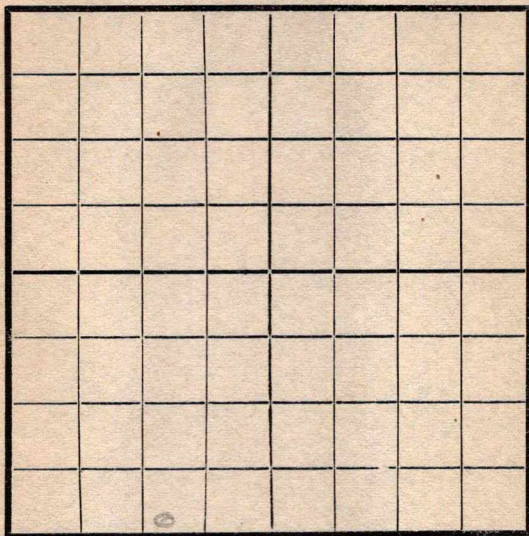

EAST

SOUTH

RECORD

Location _____

Cased _____ in. _____ Ft.

Rig Up _____

Sand _____

Drilling and remarks

Gas _____

Oil _____

Total Depth _____

PRODUCTION

1st 24 hrs. Nat. _____

1st 24 hrs. after shot _____

Gas _____ Cu. Ft.

Dry Hole _____

Abandoned _____

Date


1 Feb, 1917 Carroll Scout

Map No. _____ Sec. 29 Twp. 26 R. 5

Well No. 9 Roogler Farm
Lewis & Bagley Company

NORTH

WEST

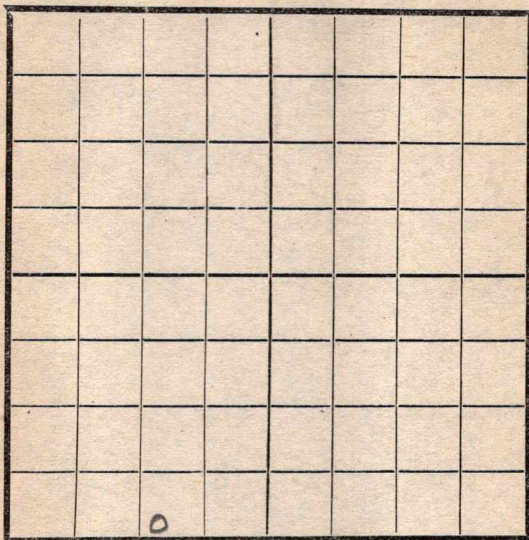

EAST

SOUTH

RECORD

Location _____

Rig Up ☒ _____

Drilling and remarks _____

Cased _____ in. _____ Ft.

Sand _____

Gas _____

Oil _____

Total Depth _____

PRODUCTION

1st 24 hrs. Nat. _____

1st 24 hrs. after shot _____

Gas _____ Cu. Ft.

Dry Hole _____

Abandoned _____


Date

11/3, 1917 Oyle Scout

Map No. _____ Sec. 29 Twp. 24 R. 5
 Well No. 8 Hoaglet Farm _____
Lewis & Gage Company

NORTH

WEST

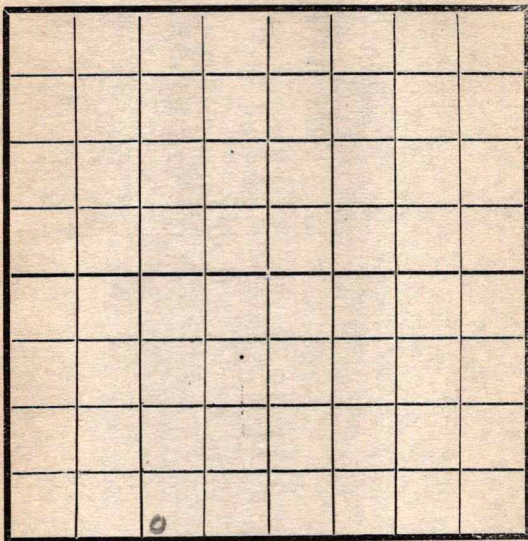

EAST

SOUTH

RECORD

Location _____

Cased _____ in. _____ Ft.

Rig Up _____

Sand _____

Drilling and remarks

Gas _____

Oil _____

Total Depth _____

PRODUCTION

1st 24 hrs. Nat. _____

1st 24 hrs. after shot _____

Gas _____ Cu. Ft.

Dry Hole _____

Abandoned _____


Date

11/10, 1917 Cycle Scout

Map No. _____ Sec. 29 Twp. 26 R. 5
 Well No. 8 Boogler Farm
Lewis & Page Company

NORTH

WEST

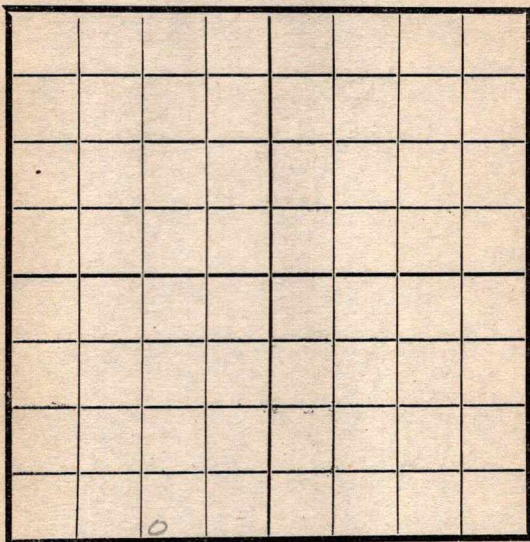

EAST

SOUTH

RECORD

Location _____
 Rig Up ☒
 Drilling and remarks _____

Cased _____ in _____ Ft.
 Sand _____
 Gas _____
 Oil _____
 Total Depth _____

PRODUCTION

1st 24 hrs. Nat. _____
 1st 24 hrs. after shot _____
 Gas _____ Cu. Ft.
 Dry Hole _____
 Abandoned _____

Date


11/14, 1917 Pyle Scout

Map No. L1009 K14 Sec. 29 Twp. 26 R. 5

Well No. 9 Hoogler Farm
Lewis & Page Company

NORTH

WEST

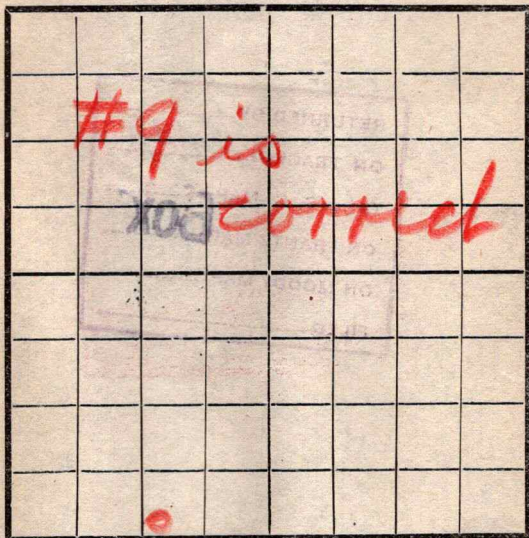

EAST

SOUTH

Location -----

Rig Up -----

Drilling and remarks

200'

RECORD

Cased ----- in. ----- Ft.

Sand -----

Gas -----

Oil -----

Total Depth -----

PRODUCTION

1st 24 hrs. Nat. -----

1st 24 hrs. after shot -----

Gas ----- Cu. Ft.

Dry Hole -----

Abandoned -----

Date

11/21

191


7

Pyle Scout

Map No. _____ Sec. 29 Twp. 26 R. 5Well No. 9 Royster FarmLewis O. Page Company

NORTH

WEST

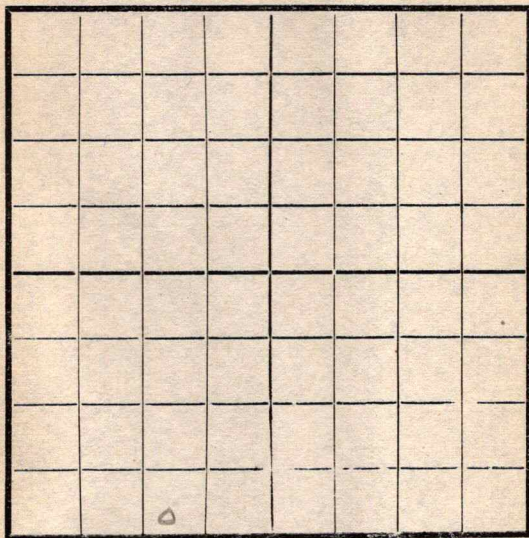

EAST

SOUTH

RECORD

Location _____

Cased _____ in. _____ Ft.

Rig Up _____

Sand _____

Drilling and remarks

Gas _____

Oil _____

Total Depth _____

PRODUCTION

1st 24 hrs. Nat. _____

1st 24 hrs. after shot _____

Gas _____ Cu. Ft.

Dry Hole _____

Abandoned _____


Date

11/28, 1917Pyle Scout

Map No. _____ Sec. 29 Twp. 26 R. 5Well No. 9 Roogler FarmLewis & Page Company

NORTH

WEST

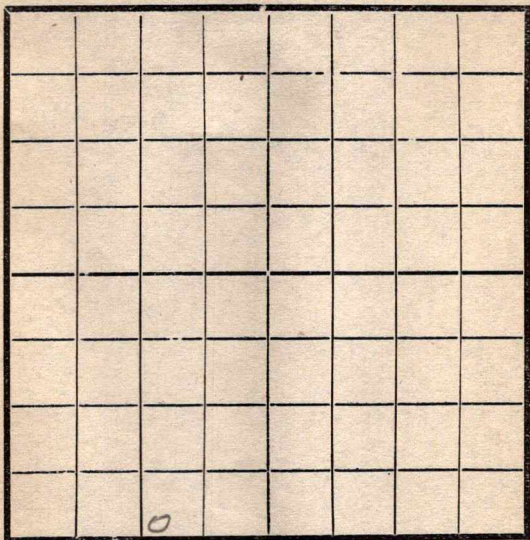

EAST

SOUTH

RECORD

Location _____

Cased _____ in _____ Ft.

Rig Up _____

Sand _____

Drilling and remarks

Gas _____

Oil _____

Total Depth _____

PRODUCTION

1st 24 hrs. Nat. _____

1st 24 hrs. after shot _____

Gas _____ Cu. Ft.

Dry Hole _____

Abandoned _____


Date

12/5, 1917 Page Scout

Map No. _____ Sec. 29 Twp. 26 R. 5Well No. 9 Hooper Farm
Lewis & Page Company

NORTH

WEST

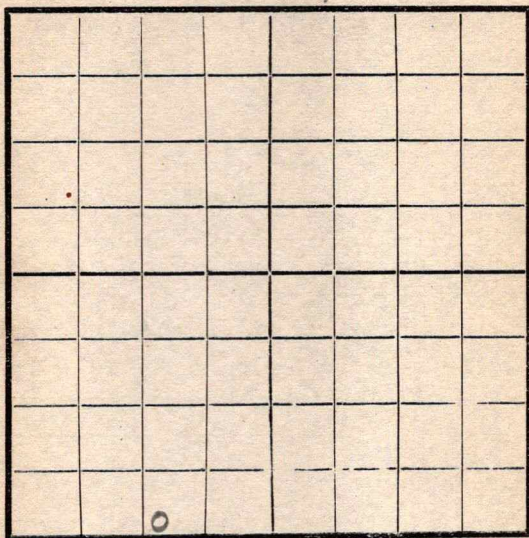

EAST

SOUTH

RECORD

Location _____

Cased _____ in. _____ Ft.

Rig Up _____

Sand _____

Drilling and remarks

Gas _____

Oil _____

Total Depth _____

PRODUCTION

1st 24 hrs. Nat. _____

1st 24 hrs. after shot _____

Gas _____ Cu. Ft.

Dry Hole _____

Abandoned _____


Date

12/26, 1917Cyle Scout

Map No. _____ Sec. 29 Twp. 26 R. 5Well No. 9 Hoogler Farm _____Lewis & Payne Company

NORTH

WEST

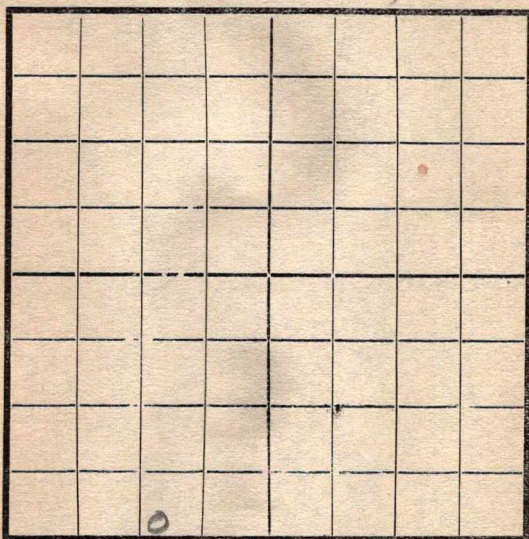

EAST

SOUTH

Location _____

Rig Up _____

Drilling and remarks

RECORD

Cased _____ in. _____ Ft.

Sand _____

Gas _____

Oil _____

Total Depth _____

PRODUCTION

1st 24 hrs. Nat. _____

1st 24 hrs. after shot _____

Gas _____ Cu. Ft.

Dry Hole _____

Abandoned _____

Date


1/2, 1918, P. L. Payne Scout

Map No. _____ Sec. 29 Twp. 26 R. 5Well No. 9 Hoogler Farm _____Lewis & Page Company _____

NORTH

WEST

EAST

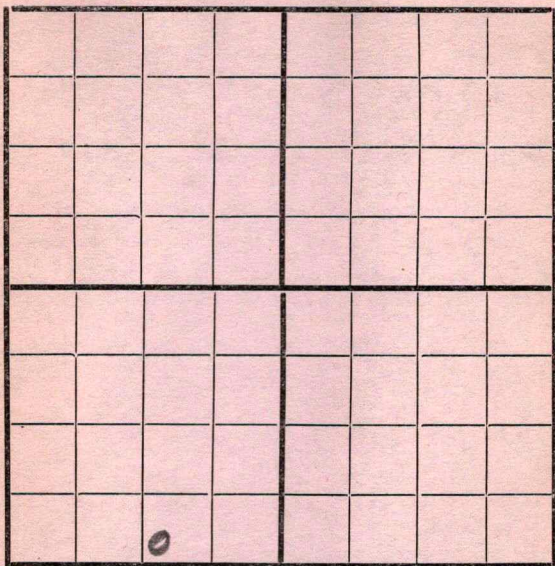

SOUTH

Location _____

Rig Up _____

Drilling and remarks

D. H.
1700'

RECORD

Cased _____ in. _____ Ft.

Sand _____

Gas _____

Oil _____

Total Depth _____

PRODUCTION

1st 24 hrs. Nat. _____

1st 24 hrs. after shot _____

Gas _____ Cu. Ft.

Dry Hole _____


Abandoned _____

Date

1/8, 1918 Pyle Scout

Map No. _____ Sec. 29 Twp. 24 R. 5
 Well No. 9000 Farm _____
Lewis & Page Company

NORTH

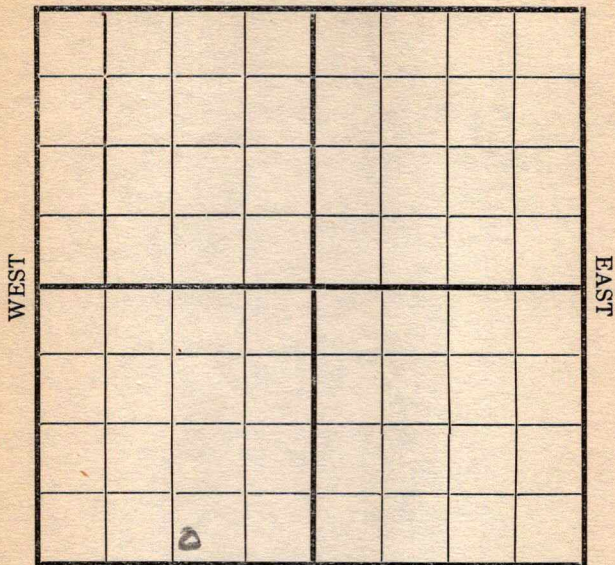

SOUTH


Location _____ Rig Up _____ Drilling and remarks _____ 1750'	RECORD Cased _____ in. _____ Ft. Sand _____ Gas _____ Oil _____ Total Depth _____ PRODUCTION 1st 24 hrs. Nat. _____ 1st 24 hrs. after shot _____ Gas _____ Cu. Ft. Dry Hole _____ Abandoned _____
--	--

Date 1/25, 1918 Page Scout

Map No. _____ Sec. 29 Twp. 24 R. 5Well No. 9 Cooper FarmLewis & Oage Company

NORTH

WEST

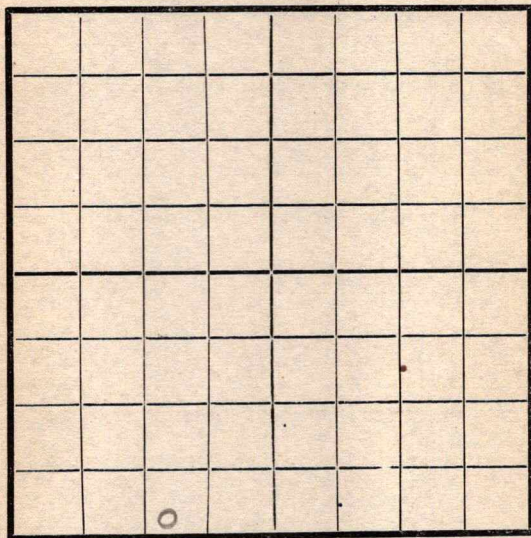

EAST

SOUTH

RECORD

Location _____

Cased _____ in _____ Ft.

Rig Up _____

Sand _____

Drilling and remarks

Gas _____

Oil _____

Total Depth _____

PRODUCTION

1st 24 hrs. Nat. _____

1st 24 hrs. after shot _____

Gas _____ Cu. Ft.

Dry Hole _____

Abandoned _____


Date

1/30, 1918 Oyle Scout

Map No. _____ Sec. 29 Twp. 26 R. 5
 Well No. 9 Trapper Farm
Lewis & Page Company
 Date Started _____ Ft. from N _____ S _____ E _____ W _____ line

NORTH

WEST

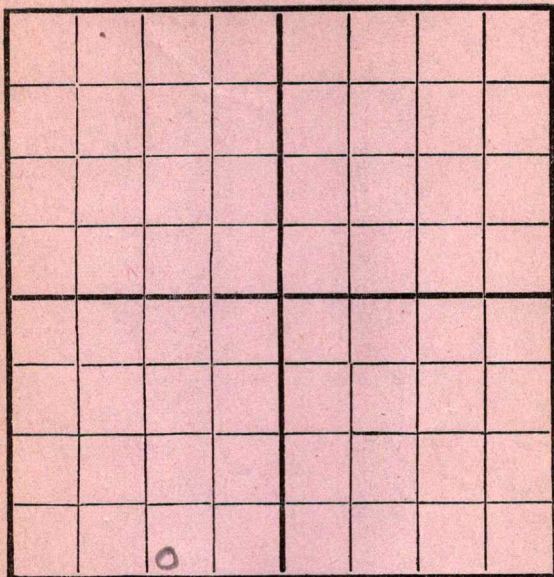

EAST

SOUTH

Cased _____ In. _____ Ft.

Sand _____

 Pay { Gas _____
 Oil _____

Total Depth _____

Production Remarks

Condition of Well on this date _____

2100'

2/5


Tyler

Scout

Map No. _____ Sec. 29 Twp. 26 R. 5
 Well No. 9 Koogler Farm _____
Lewis & Page Company _____

NORTH

WEST

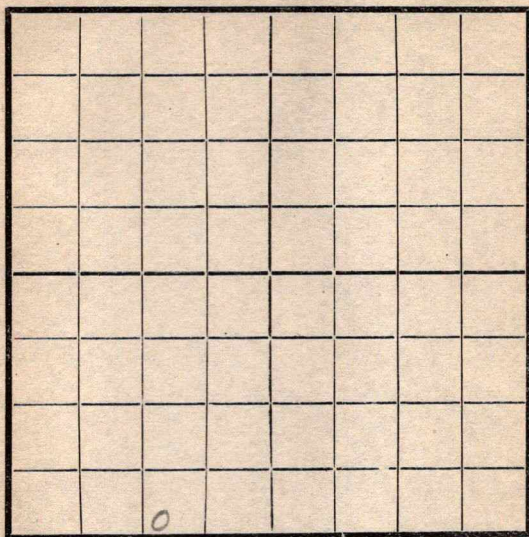

EAST

SOUTH

RECORD

Location _____

Cased _____ in. _____ Ft.

Rig Up _____

Sand _____

Drilling and remarks

Gas _____

Oil _____

Total Depth _____

2356'

PRODUCTION

1st 24 hrs. Nat. _____

1st 24 hrs. after shot _____

Gas _____ Cu. Ft.

Dry Hole _____

Abandoned _____

Date

2/12, 1918


Pyle

Scout

Map No. _____ Sec. 29 Twp. 26 R. 5Well No. 9 Hoogler Farm
Lewis & Cagle Company

NORTH

WEST

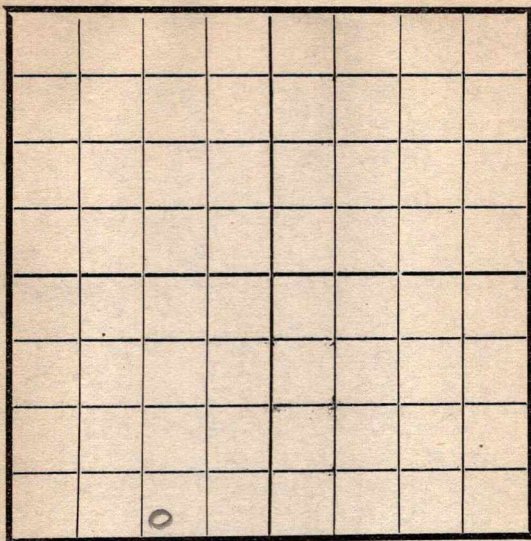

EAST

SOUTH

RECORD

Location _____

Cased _____ in. _____ Ft.

Rig Up _____

Sand _____

Drilling and remarks

Gas _____

Oil _____

Total Depth _____

PRODUCTION

1st 24 hrs. Nat. _____

1st 24 hrs. after shot _____

Gas _____ Cu. Ft.

Dry Hole _____

Abandoned _____


Date

2/20, 1918 Jyle Scout

Map No. _____ Sec. 29 Twp. 24 R. 5
 Well No. 9 Koogler Farm _____
Lewis & Page Company

NORTH

WEST

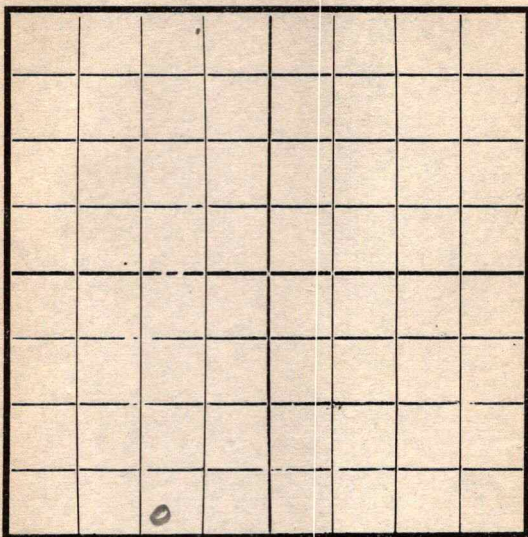

EAST

SOUTH

Location _____

Rig Up _____

Drilling and remarks

*tools stuck
 @ 2727 hole
 full water
 will plug
 back to
 2606'*

RECORD

Cased _____ in. _____ Ft.

Sand _____

Gas _____

Oil _____

Total Depth _____

PRODUCTION

1st 24 hrs. Nat. _____

1st 24 hrs. after shot _____

Gas _____ Cu. Ft.

Dry Hole _____

Abandoned _____

Date

2/8
 _____, 191*8*

27


Scout

Pyle

Map No. _____ Sec. 29 Twp. 24 R. 5Well No. 9 Koogler Farm _____Lewis & Page Company _____

NORTH

WEST

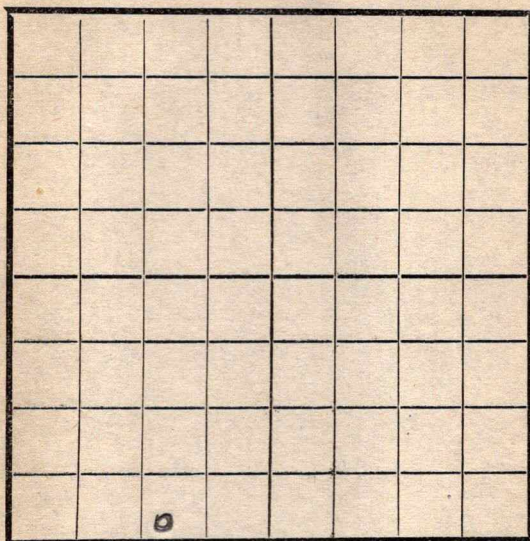

EAST

SOUTH

Location _____

Rig Up _____

Drilling and remarks

tools stuck
@ 2727' plugged
hole back to
2601' hole
full water
small show oil

RECORD

Cased _____ in. _____ Ft.

Sand 2591-2601

Gas _____

Oil _____

Total Depth 2727

PRODUCTION

1st 24 hrs. Nat. _____

1st 24 hrs. after shot _____

Gas _____ Cu. Ft.

Dry Hole _____

Abandoned _____

Date _____

3/5, 1918Oyle


Scout _____

Map No. K 14 Sec. 29 Twp. 26 R. 5

Well No. 92 Koogler

Lewis & Page Company

Contractor

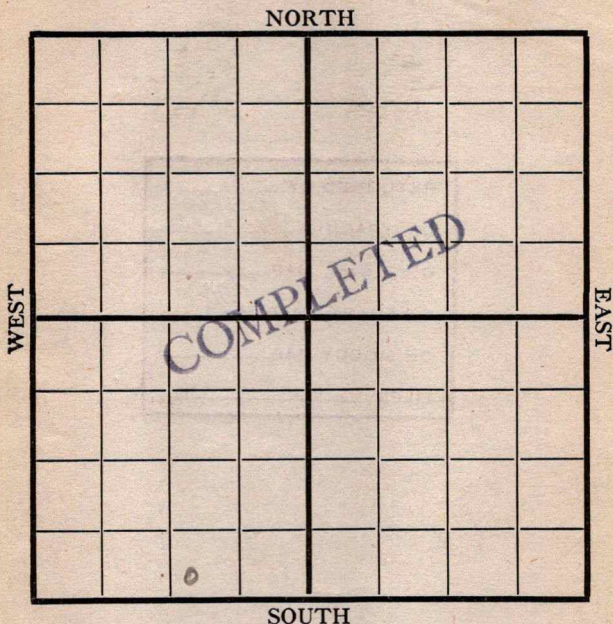

Location _____

Rig up _____

Drilling and Remarks:

*Plugged back
but failed to
shut off water
abandoned*

RECORD

Cased _____ in., _____ ft.

Sand 2591-2601

Gas _____

Oil _____

Total Depth 2727

PRODUCTION

1st 24 hrs. Nat. _____

1st 24 hrs. after shot _____

Gas _____ Cu. Ft.

Dry Hole _____

Abandoned _____

Date

7/14 1918 C. G. Lyle Scout