


Map No. _____ Sec. 25 Twp. 26 R. 5
Well No. 1 Holen Farm
Campbell et al. Company

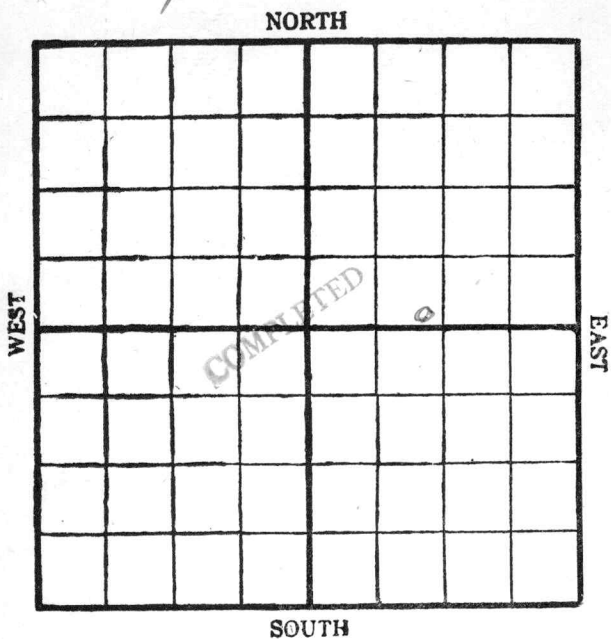

Location _____

Drilling Remarks:

Rig Up _____

Drilling Remarks:

RECORD

Cased _____ in. _____ ft.

Sand _____

Gas _____

Oil _____

Total Depth _____

PRODUCTION

1st 24 hrs. Nat. _____

1st 24 hrs. after shot _____


Gas _____ cu. ft.

Dry Hole _____

Abandoned _____

Map No. K14 Sec. 25 Twp. 26 R. 5
 Well No. 1 H. Haley
Campbell et al Company
 Contractor

NORTH

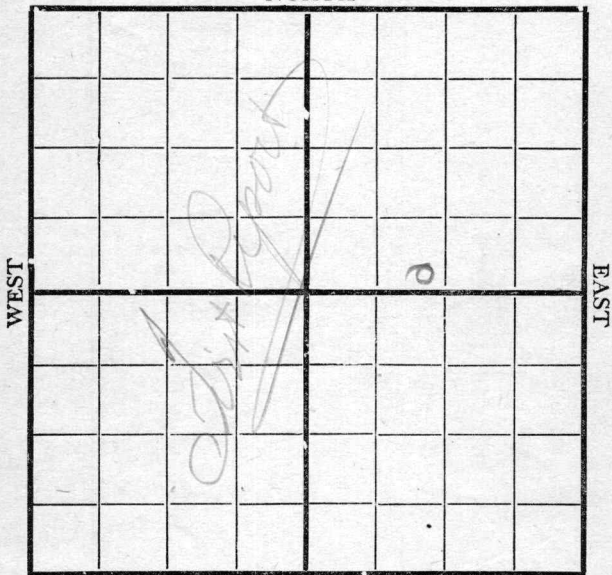

1120 W

SOUTH

200 S

Location _____

Rig up _____

Drilling and Remarks:

1650'

RECORD

Cased _____ in., _____ ft.

Sand _____

Gas _____

Oil _____

Total Depth _____

PRODUCTION

1st 24 hrs. Nat. _____

1st 24 hrs. after shot _____

Gas _____ Cu. Ft.

Dry Hole _____

Abandoned _____

Date

12/27

191

Pyle

Scout


Map No. K 14 Sec. 25 Twp. 26 R. 5Well No. 1 HolmesCampbell et al Company

Contractor

NORTH

WEST

EAST

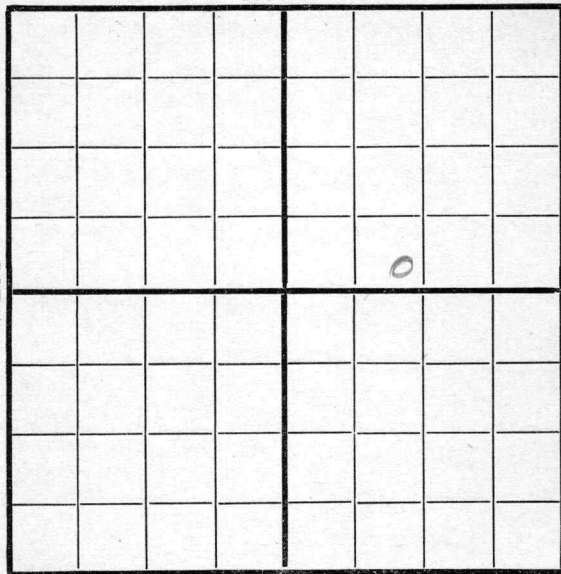

SOUTH

Location 1120-WRig up 200 S

Drilling and Remarks:

RECORD

Cased _____ in., _____ ft.

Sand _____

Gas _____

Oil _____

Total Depth _____

PRODUCTION

1st 24 hrs. Nat. _____

1st 24 hrs. after shot _____

Gas _____ Cu. Ft.

Dry Hole _____

Abandoned _____

Date

Jan 16 1919Pyle

Scout


Map No. K14 Sec. 25 Twp. 26 R. 5Well No. 1 Holmes
Campbell et al Company

Contractor

NORTH

WEST

EAST

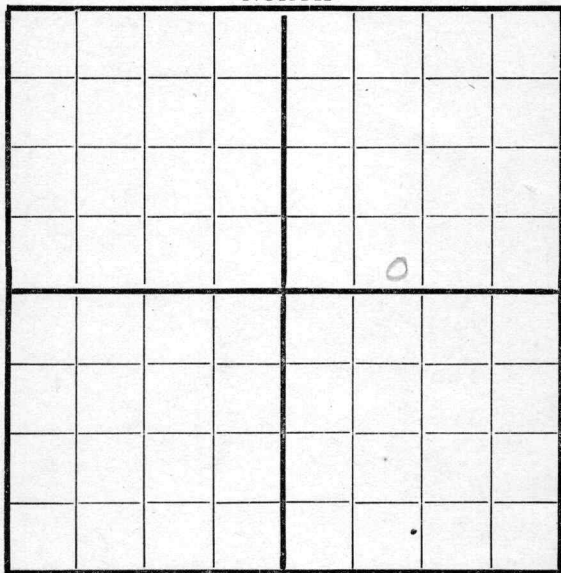

200 S

SOUTH

1120 W

Location _____

Rig up _____

Drilling and Remarks:

2000'

RECORD

Cased _____ in., _____ ft.

Sand _____

Gas _____

Oil _____

Total Depth _____

PRODUCTION

1st 24 hrs. Nat. _____

1st 24 hrs. after shot _____

Gas _____ Cu. Ft.

Dry Hole _____

Abandoned _____

Date

Jan 22 1919

Pyle

Scout


Map No. K14 Sec. 25 Twp. 26 R. 5Well No. 1 HolmCampbell et al. Company

Contractor

NORTH

WEST

EAST

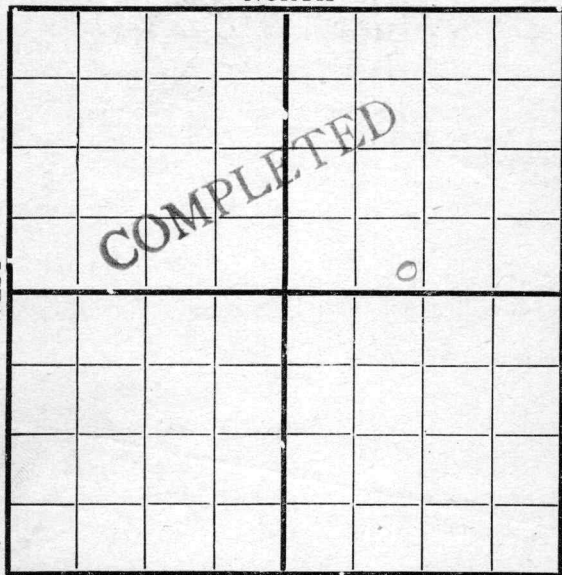

SOUTH

1120 W2005

Location _____

Rig up _____

Drilling and Remarks:

RECORD

Cased _____ in., _____ ft.

Sand _____

Gas _____

Oil _____

Total Depth _____

PRODUCTION

1st 24 hrs. Nat. _____

1st 24 hrs. after shot _____

Gas _____ Cu. Ft.

Dry Hole 3000'

Abandoned _____

Date

5/7 1919Dyle Scout