FORM 51 10M 7-48 PETROL


KANSAS Butler

Section 35 Township 27 Range 4E

Well No. 3 Moyle

Company H & M Drlg.

Misc.

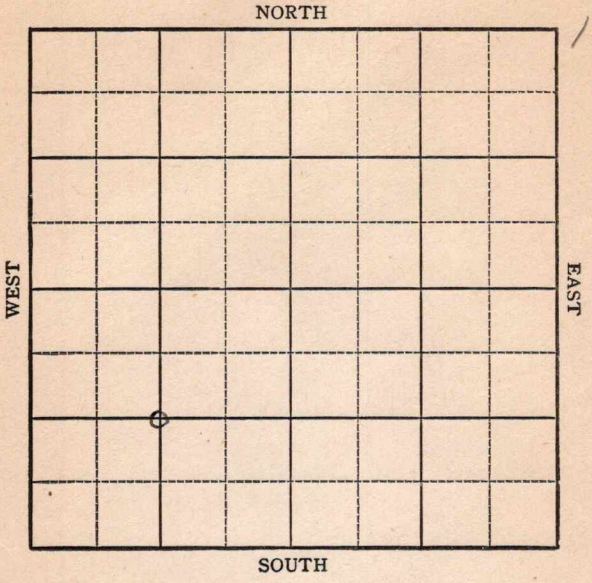

FORM 252-A
5M 10-48 PETROL

KANSAS

Butler

Sec. 35 Twp. 27 R. 4E

Well No. #3 Moyle Farm

H & M Drlg. Company

Miscellaneous


1320' Ft. from N. Line

_____ Ft. from S. Line

_____ Ft. from E. Line

1320' Ft. from W. Line

C SW

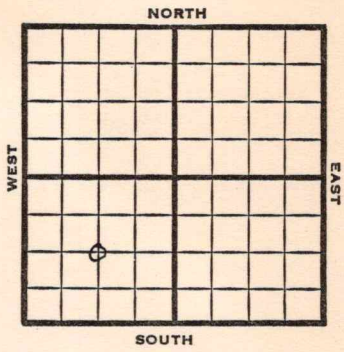

1948	Elev. 1297' REPORT
12/15	Machine
12/22	Drlg. 665'
12/29	13" @ 994' Drlg. 1145'
1¢5	Drlg. 1975'
1/12	1975' SD
1/19	Simpson 2615' 7" @ 2605' TD 2027'
1/26	5 qts.
2/2	"
2/9	5 qts.
2/16	Simp. 2615' 7" @ 2608' 5 qts Pump 25 oil & W Pot. Gr. 44° TD 2627'

COMPLETED

Form 26 200 Bks. 9-48 Petrol

Kansas

Miscellaneous

Map No. _____ Sec. 35 Twp. 27 R. 4E


Well No. 3 Moyle

H & M Drlg. Company

FIRST REPORT Contractor

C SW

SECTION PLAT

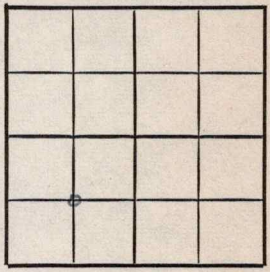

1320 Ft. from N. Line

_____ Ft. from S. Line

_____ Ft. from E. Line

1320 Ft. from W. Line

Butler County

Location _____

Rig up _____

Drilling and Remarks:

Machine

RECORD

Cased _____ in., _____ ft.

Sand _____

Gas _____

Oil _____

Total Depth _____

PRODUCTION

1st 24 hrs. Nat. _____

1st 24 hrs. after shot _____

Gas _____ Cu. Ft.

Dry Hole _____

Abandoned _____

Date

DEC 15 1948 19

S. J. LEWIS Scout

Form 26 200 Bks. 9-48 Petrol

Kansas

Miscellaneous

Map No. K-11 Sec. 35 Twp. 27 R. 4E

Well No. 3 Moyle


H. & M. Drlg. Company

COMPLETE Contractor

E 1,129 R

C SW

SECTION PLAT

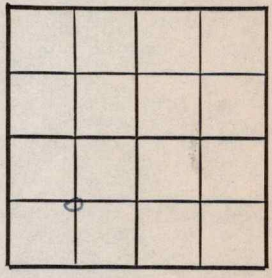

1320 Ft. from N. Line

____ Ft. from S. Line

____ Ft. from E. Line

1320 Ft. from W. Line

Butler County

Location

Rig up

Drilling and Remarks:

Surf 265

7" @ 260'

5 sks

Prod 25 sks + W

RH

44 @ 2a

RECORD

Cased ____ in., ____ ft.

Sand

Gas

Oil

Total Depth 2627

PRODUCTION

1st 24 hrs. Nat.

1st 24 hrs. after shot

Gas ____ Cu. Ft.

Dry Hole

Abandoned

Date

FEB 16 1949 19

S. J. LEWIS Scout