FORM 51 10M 2-49 PETROL

KANSAS


Butler

Section 35 Township 27 Range 4E

Well No. 3 Moyle

Company H & M Drlg

Misc.

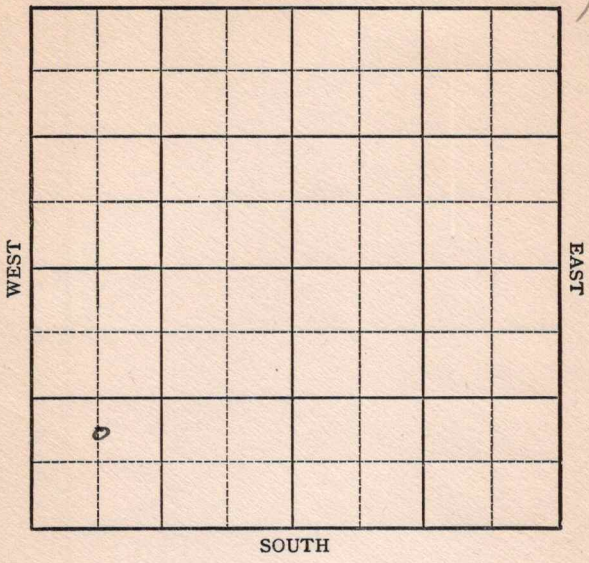

FORM 252-A
5M 10-48 PETROL

KANSAS Butler

Sec. 35 Twp. 27 R. 4E ✓

Well No. #3 Moyle Farm

H. & M. Drlg. Company

Miscellaneous


_____ Ft. from N. Line

990' Ft. from S. Line

_____ Ft. from E. Line

660' Ft. from W. Line

C N L SW SW

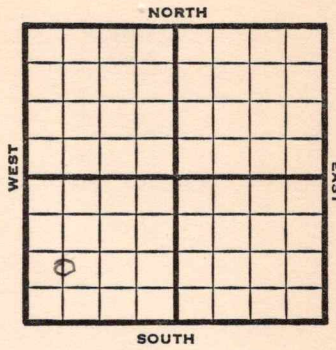

1949	Elev 1303' REPORT
4/6	Location
4/12	Drlg. 225'
4/20	18" @ 105' Drlg. 1325'
4/27	KC 2070' Drlg. 2090'
5/4	Drlg. 2575'
5/10	Arbuckle 2640' 7" @ 2615' TD 2641' 20 qts 2626-31 CO
5/18	SD
5/25	"
6/1	"
6/7	"
6/15	"
6/21	"
6/28	"
7/6	"
7/12	"
7/20	"
7/27	"
8/3	"
8/10	"
8/17	"

OVER

78125

1949

8/24 TD 2641'
Arb. 2640'
Aband.

ABANDONED

Form 26 200 Bks. 9-48 Petrol

Kansas

Miscellaneous

Map No. _____ Sec. 35 Twp. 27 R. 4E


Well No. 3 Moyle

H. & M. Drlg. Company

FIRST REPORT Contractor

C N L SW SW

SECTION PLAT

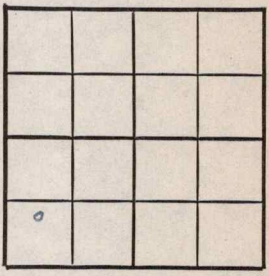

_____ Ft. from N. Line

990 Ft. from S. Line

_____ Ft. from E. Line

660 Ft. from W. Line

Butler County

Location x

Rig up

Drilling and Remarks:

RECORD

Cased _____ in., _____ ft.

Sand

Gas

Oil

Total Depth

PRODUCTION

1st 24 hrs. Nat.

1st 24 hrs. after shot

Gas _____ Cu. Ft.

Dry Hole

Abandoned

Date

APR 6 1949 19

S. J. LEWIS Scout

Form 26 200 Bks. 6-49 Petrol

Miscellaneous

Kansas

Map No. K11 Sec. 35 Twp. 27 R. 4E

Well No. 3 Moyle


H & M Drlg. Company

ABANDONED Contractor

C N L SW SW

E1,1303

SECTION PLAT

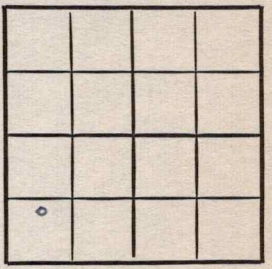

Ft. from N. Line

990 Ft. from S. Line

Ft. from E. Line

660 Ft. from W. Line

Butler County

Location

Rig up

Drilling and Remarks:

Cr #2648

RECORD

Cased in., ft.

Sand

Gas

Oil

Total Depth 2641

PRODUCTION

1st 24 hrs. Nat.

1st 24 hrs. after shot

Gas Cu. Ft.

Dry Hole

Abandoned

Date

AUG 24 1949 19 S. J. LEWIS Scout