
FORM 51 25M 3-49 PETROL

Butler KANSAS

Section 35 Township 27 Range 4E

Well No. #5 Moyle

Company H & M Drlg.

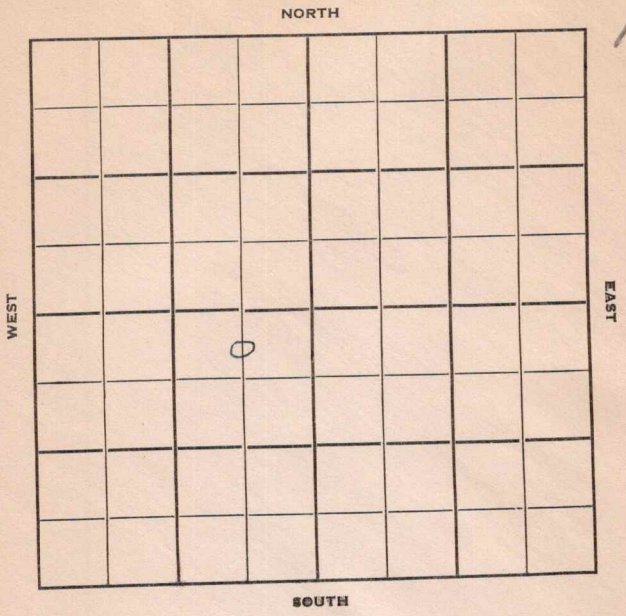

11

FORM 252-B
10M 9-49 PETROL

KANSAS Butler ✓

Sec. 35 Twp. 27 R. 4-E

Well No. #5 Moyle Farm

H & M Drlg. Company

H & M Drlg. Contractor

Augusta


330 Ft. from N. Line

Ft. from S. Line

660 Ft. from E. Line

Ft. from W. Line

C N L NE SW

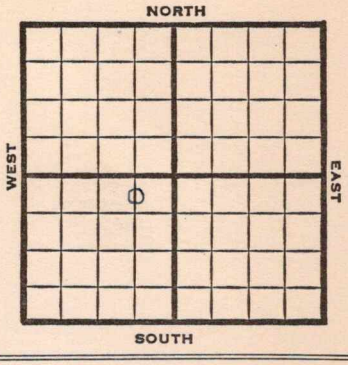

1950	Elev 1276 REPORT
9/13	Location
11/1	Spud 9-14-50 13" @ 965 TD 2608 16 qt 2550-56 Comp 18 bopd TD 2608 Completed
	COMPLETED

FORM 275 FOR SALE BY KANSAS BLUE PRINT CO.


County Butler State Kansas

Sec. 35 (Blk. Twp.) 27 (Sur. Rge.) 4E Map No.

Operator H & M Drlg.

Well No. 5 Farm Moyle

Elev. Location C N L NE SW

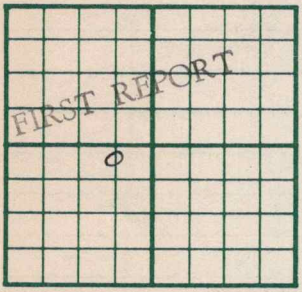

330 Ft. From N Line SW

660 Ft. From E Line Quarter

1st. Report SEP 1 3 1950

Completion

Remarks

Spudding Date

Drlg. Data Augusta Pool

Location

J. E. TYRA

FORM 275 FOR SALE BY KANSAS BLUE PRINT CO.


County Butler State Kansas

Sec. 35 (Blk. Twp.) 27 (Sur. Rge.) 4E Map No.

Operator H & M Drlg.

Well No. 5 Farm Moyle

Elev. 1276 Location C N L NE SW

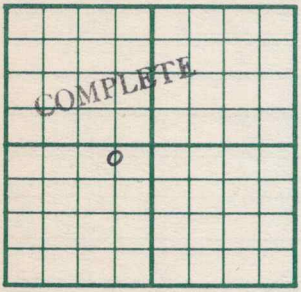

330 Ft. From N Line SW

660 Ft. From E Line Quarter

1st. Report

Completion NOV 1 19[illegible]

Remarks Augusta Pool
H & M Drlg. - Contr.

Spudding Date 9-14-50

Drlg. Data Oil well TD 2608

13" @ 965 TD 2608 16 qt/ 2550-56

Comp. 18 bopd

J. E. TYRA