

KANSAS

FORM C1 25M 3-49 PETROL

Greenwood

Section 36 Township 25 Range 10E

Well No. 1 Smith

Company Chas. Carlock et al

Misc.

NORTH

WEST

							o

EAST

SOUTH

Greenwood KANSAS ✓

Sec. 36 Twp. 25 R. 10E

Well No. #1 Smith Farm

Chas Carlock et al

Miscellaneous (Mendenhall, Cont.) Company


990' Ft. from N. Line

 Ft. from S. Line

330' Ft. from E. Line

 Ft. from W. Line

SE NE NE

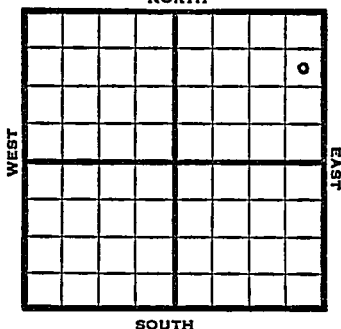

1949	Elev	REPORT
8/31	RUR	
9/7	Miss 2005'	
	TD 2005'	
	5" @ 2005'	
9/14	TD 2009'	
	Miss 2005'	
	5"@ 2005'	
	500 acid	
	Pump 20 Oil Pot	
	38° Gr.	
	Comp	
	COMPLETED	

Kansas


Map No. _____ Sec. 36 Twp. 25 R. 10E

Well No. 1 Smith

Chas. Carlock et al. Company

Mendenhall Contractor

SE NE NE

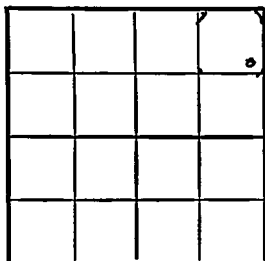FIRST REPORT
SECTION PLAT

990 Ft. from N. Line

Ft. from S. Line

330 Ft. from E. Line

Ft. from W. Line

Greenwood County

Location _____

Rig up _____

Drilling and Remarks:

R U R

RECORD

Cased _____ in., _____ ft.

Sand _____

Gas _____

Oil _____

Total Depth _____

PRODUCTION

1st 24 hrs. Nat. _____

1st 24 hrs. after shot _____

Gas _____ Cu. Ft.

Dry Hole _____

Abandoned _____

Date

AUG 31 1949

19

S. J. LEWIS

Scout

Map No. K16 Sec. 36 Twp. 25 R. 10E

Well No. 1 Smith

Chas. Carlock et al. Company

COMPLETE

Contractor

SE NE NE


SECTION PLAT

990 Ft. from N. Line

 Ft. from S. Line

330 Ft. from E. Line

 Ft. from W. Line

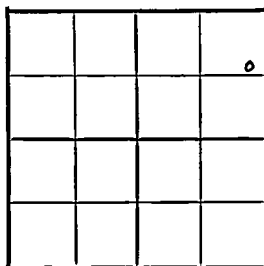

Greenwood County

Location

Rig up

Drilling and Remarks:

Miss 2005
5" C 2005
500 acid
Pump 2005 Rod
38° Gr

RECORD

Cased in., ft.

Sand

Gas

Oil

Total Depth 2009

PRODUCTION

1st 24 hrs. Nat.

1st 24 hrs. after shot

Gas Cu. Ft.

Dry Hole

Abandoned

Date

SEP 14 1949

S. J. LEWIS Scout