

KANSAS

Greenwood

Section 36 Township 25 Range 10E

Well No. 1 Smith "C"


Company R.E. Smith

Misc.

NORTH

WEST

EAST

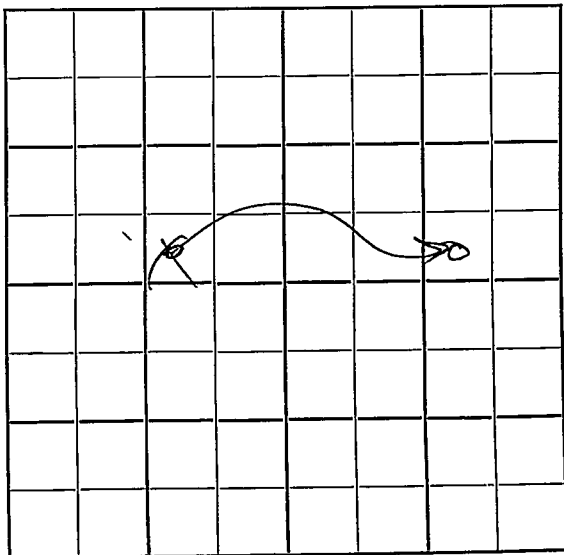

SOUTH

KANSAS

Greenwood

Sec. 36 Twp. 25 R. 10E

Well No. #1 Smith "C" Farm

R. E. Smith Company

Miscellaneous


 Ft. from N. Line

330' Ft. from S. Line

990' Ft. from E. Line

 Ft. from W. Line

SW SE NE
SE SE NW

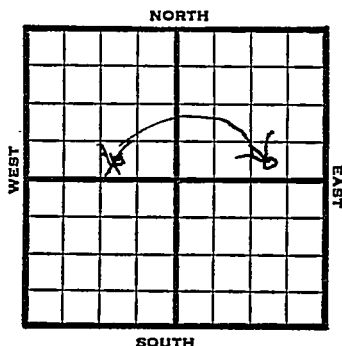

1949	REPORT
4/20	10" @ 14'
4/27	Drlg. 1950'
5/4	"
5/10	Miss 1972: 7" @ 1975' TD 1985' 600 acid Pump 25 oil Pot. Gr. 38°
	COMPLETED

Map No. _____ Sec. 36 Twp. 25 R. 10E

Well No. 1 Smith "C"

R. E. Smith Company

FIRST REPORT

Contractor

SW SE NW

SECTION PLAT

_____ Ft. from N. Line

330 Ft. from S. Line

990 Ft. from E. Line

_____ Ft. from W. Line

Greenwood County

Location _____

Rig up _____

Drilling and Remarks:

10" @ 14

RECORD

Cased _____ in., _____ ft.

Sand _____

Gas _____

Oil _____

Total Depth _____

PRODUCTION

1st 24 hrs. Nat. _____

1st 24 hrs. after shot _____

Gas _____ Cu. Ft.

Dry Hole _____

Abandoned _____

Date

APR 20 1949

S. J. LEWIS Scout

Map No. K16 Sec. 36 Twp. 25 R. 10E

Well No. 1 Smith "C"

R. E. Smith Company

COMPLETE Contractor

SW SE NE

7

SECTION PLAT

 Ft. from N. Line

330 Ft. from S. Line

990 Ft. from E. Line

 Ft. from W. Line

Greenwood County

Location

Rig up

Drilling and Remarks:

Mis 1972

7 "C 1975

600 and

Prod 25 oil Per

35° SW

RECORD

Cased in., ft.

Sand

Gas

Oil

Total Depth 1955

PRODUCTION

1st 24 hrs. Nat.

1st 24 hrs. after shot

Gas Cu Ft.

Dry Hole

Abandoned

Date

MAY 18 1949 19

S. J. LEWIS Scout

Map No. _____ Sec. 36 Twp. 25 R. 10E

Well No. 1 Smith "C"

R. E. Smith Company

CORRECTION

Contractor

SW SE NE

SECTION PLAT

_____ Ft. from N. Line

330 Ft. from S. Line

990 Ft. from E. Line

_____ Ft. from W. Line

Greenwood County

Location _____

Rig up _____

Drilling and Remarks:

Reported
SW SE NW

RECORD

Cased _____ in., _____ ft.

Sand _____

Gas _____

Oil _____

Total Depth _____

PRODUCTION

1st 24 hrs. Nat. _____

1st 24 hrs. after shot _____

Gas _____ Cu. Ft.

Dry Hole _____

Abandoned _____

Date

JUN 1 1940 19

S. J. LEWIS

Scout