
FORM 501 10-17 2M No. 889 BEACON

Map No. _____ Sec. 35, Twp. 27, R 4

Well No. 7 - Moyle Farm

Eugene Company

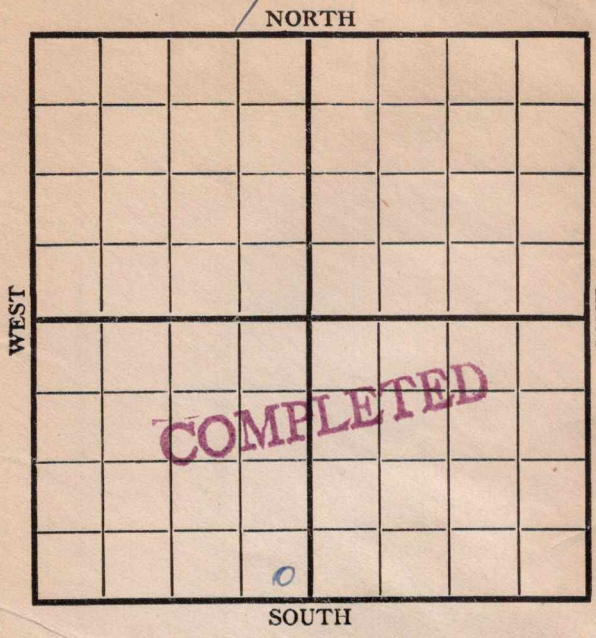

Location _____	Rig up _____
Drilling Remarks:	Drilling Remarks:

RECORD		PRODUCTION	
Cased	in. ft.	1st 24 hrs. Nat.	
Sand		1st 24 hrs. after shot	
Gas		Gas	Cu. Ft.
Oil		Dry Hole	
Total Depth		Abandoned	

Form 26—1M Books of 100 Sheets Each.


1001

Map No. K11 Sec. 35 Twp. 27 R. 4

Well No. 7 Moyle Farm

Enterprise Company

NORTH

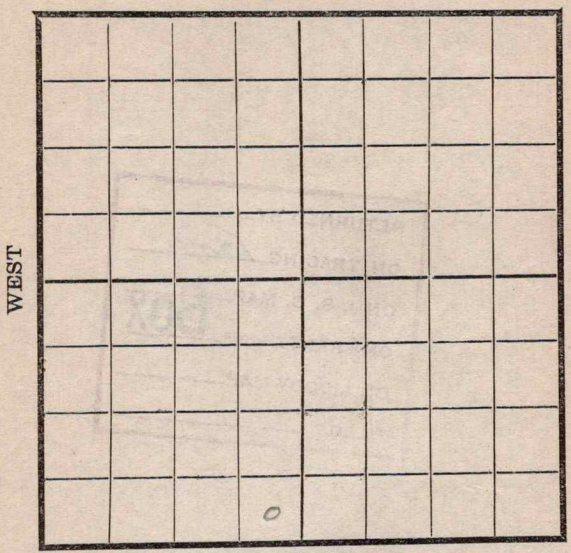

Location ✓

Rig Up

Drilling and remarks

330 N/S Line

330 W/E "

FIRST REPORT

RECORD

Cased ____ in. ____ Ft.

Sand

Gas

Oil

Total Depth

PRODUCTION

1st 24 hrs. Nat.

1st 24 hrs. after shot

Gas ____ Cu. Ft

Dry Hole

Abandoned

Date

12/19, 1912. Scou


Form 26—1M Books of 100 Sheets Each.

Map No. _____ Sec. 35 Twp. 32 R. 4

Well No. Thoyle Farm

Empire Company

NORTH

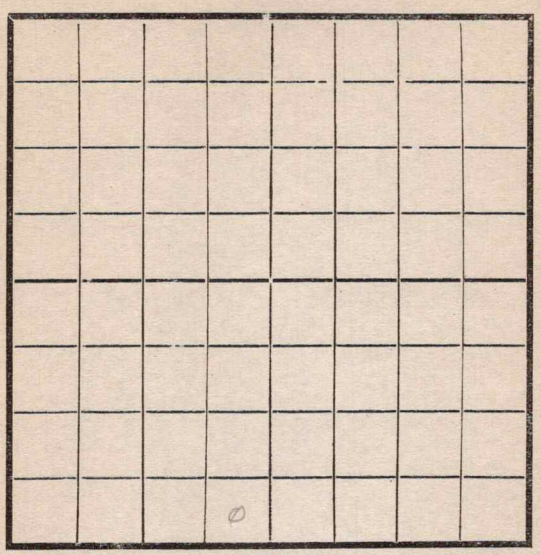

WEST

EAST

SOUTH

Location _____

Rig Up _____

Drilling and remarks

RECORD

Cased _____ in. _____ Ft.

Sand _____

Gas _____

Oil _____

Total Depth _____

PRODUCTION

1st 24 hrs. Nat. _____

1st 24 hrs. after shot _____

Gas _____ Cu. Ft.

Dry Hole _____

Abandoned _____

Date

1/2 _____, 191 8. _____ Scout


Form 26—1M Books of 100 Sheets Each.

Map No. _____ Sec. 35 Twp. 27 R. 4

Well No. 7 Moyle Farm

Empire Company

NORTH

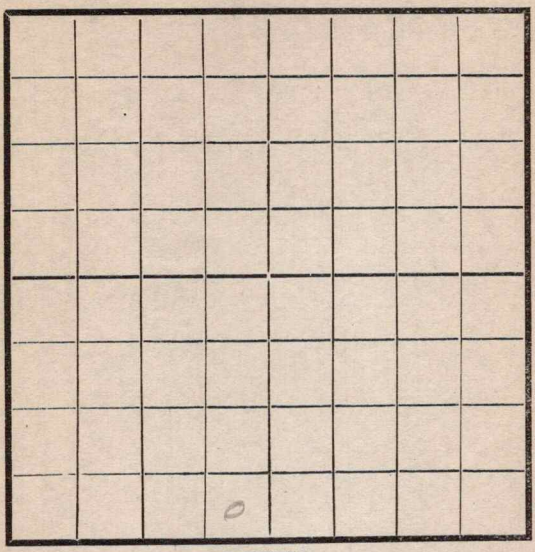

Location _____

Rig Up _____

Drilling and remarks

RECORD

Cased _____ in. _____ Ft.

Sand _____

Gas _____

Oil _____

Total Depth _____

PRODUCTION

1st 24 hrs. Nat. _____

1st 24 hrs. after shot _____

Gas _____ Cu. Ft.

Dry Hole _____

Abandoned _____

Date

1/9, 191__. S. Condy Scout


Form 26—1M Books of 100 Sheets Each.

Map No. _____ Sec. 35 Twp. 27 R. 4

Well No. 7 Murphy Farm

Empire Company

NORTH

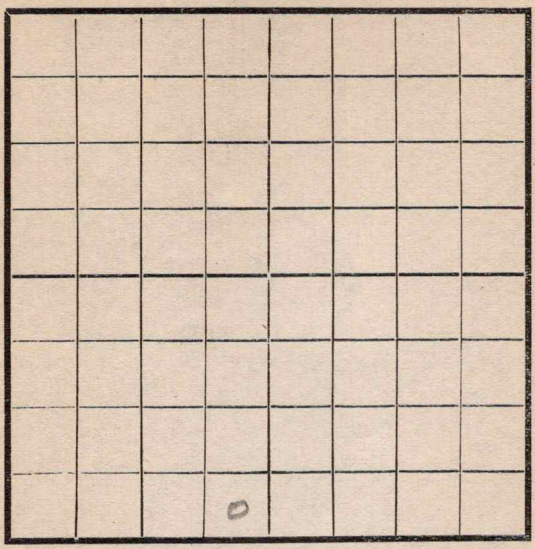

Location _____

Rig Up _____

Drilling and remarks

RECORD

Cased _____ in. _____ Ft.

Sand _____

Gas _____

Oil _____

Total Depth _____

PRODUCTION

1st 24 hrs. Nat. _____

1st 24 hrs. after shot _____

Gas _____ Cu. Ft.

Dry Hole _____

Abandoned _____

Date

1/16, 1918. Cundy Scout

Form 26—1M Books of 100 Sheets Each—4-15-18


Map No. ____ Sec. 35 Twp. 27 R. 24

Well No. 7 Moyle

Empire Company

M. B. Kelley Contractor

Augusta Ks

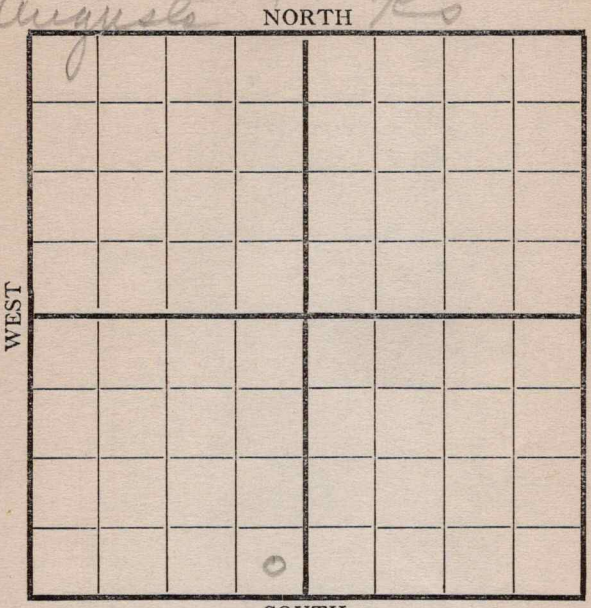

Location ____

Rig up ____

Drilling and Remarks:

Rigging up

RECORD

Cased ____ in., ____ ft.

Sand ____

Gas ____

Oil ____

Total Depth ____

PRODUCTION

1st 24 hrs. Nat. ____

1st 24 hrs. after shot ____

Gas ____ Cu. Ft.

Dry Hole ____

Abandoned ____

Date

6/26 191 8. Cundy Scout

Form 26—1M Books of 100 Sheets Each—4-15-18


Map No. _____ Sec. 35 Twp. 27 R. 4

Well No. 7 Murphy

engineer

_____ Company

_____ Contractor

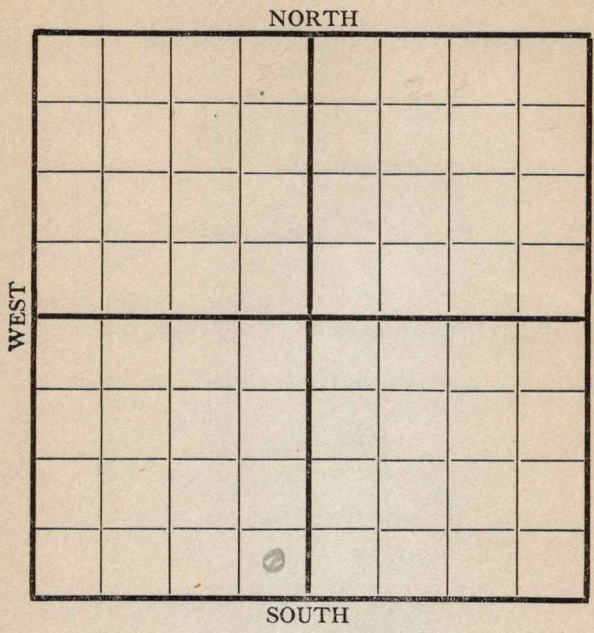

Location _____

Rig up _____

Drilling and Remarks:

Rigged up

RECORD

Cased _____ in., _____ ft.

Sand _____

Gas _____

Oil _____

Total Depth _____

PRODUCTION

1st 24 hrs. Nat. _____

1st 24 hrs. after shot _____

Gas _____ Cu. Ft.

Dry Hole _____

Abandoned _____

Date

7/3 191 _____ Scout

Form 26—1M Books of 100 Sheets Each—4-15-18


Map No. _____ Sec. 35 Twp. 27 R. 4

Well No. 7 Maple

Engine

_____ Company

_____ Contractor

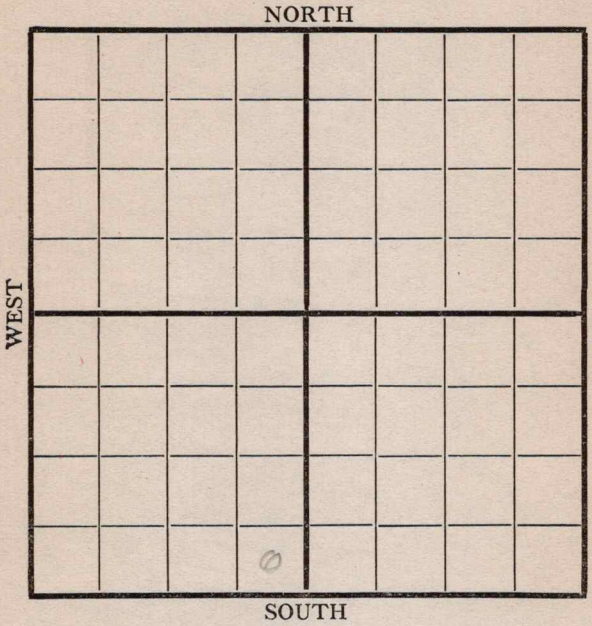

Location _____

Rig up _____

Drilling and Remarks:

365

RECORD

Cased _____ in., _____ ft.

Sand _____

Gas _____

Oil _____

Total Depth _____

PRODUCTION

1st 24 hrs. Nat. _____

1st 24 hrs. after shot _____

Gas _____ Cu. Ft.

Dry Hole _____

Abandoned _____

Date

7/10 191 8 _____ Scout

Form 26—1M Books of 100 Sheets Each—4-15-18


Map No. _____ Sec. 35 Twp. 27 R. 4

Well No. 2 Murphy

Empire

_____ Company

_____ Contractor

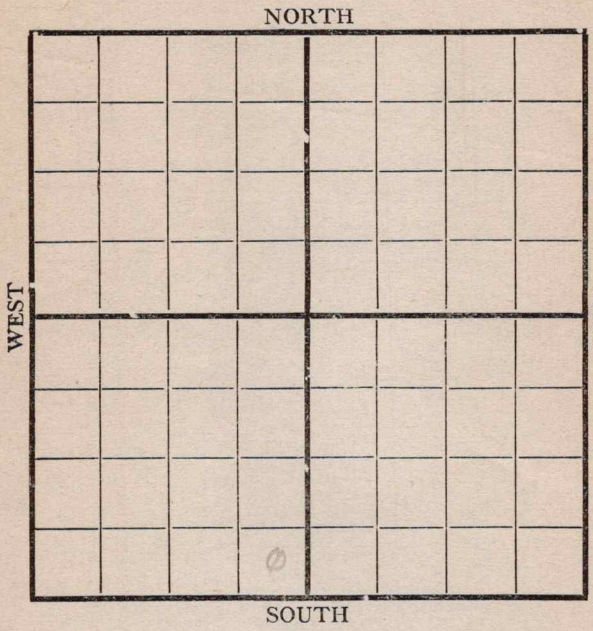

Location _____

Rig up _____

Drilling and Remarks:

770

RECORD

Cased _____ in., _____ ft.

Sand _____

Gas _____

Oil _____

Total Depth _____

PRODUCTION

1st 24 hrs. Nat. _____

1st 24 hrs. after shot _____

Gas _____ Cu. Ft.

Dry Hole _____

Abandoned _____

Date

7/17 191_____. _____ Scout


Form 26—1M Books of 100 Sheets Each—4-15-18

Map No. ____ Sec. 35 Twp. 27 R. 4

Well No. 7 Maple

Engine Company

Contractor

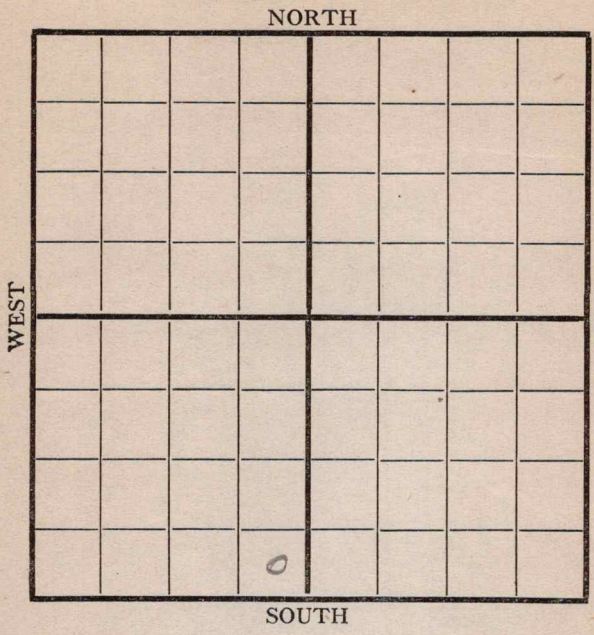

Location ____

Rig up ____

Drilling and Remarks:

1375

RECORD

Cased ____ in., ____ ft.

Sand ____

Gas ____

Oil ____

Total Depth ____

PRODUCTION

1st 24 hrs. Nat. ____

1st 24 hrs. after shot ____

Gas ____ Cu. Ft.

Dry Hole ____

Abandoned ____

Date

7/24 191 8 [illegible] Scout


Form 26—1M Books of 100 Sheets Each—4-15-18

Map No. ____ Sec. 35 Twp. 27 R. 4

Well No. 7 Moyle

Empire Company

Contractor

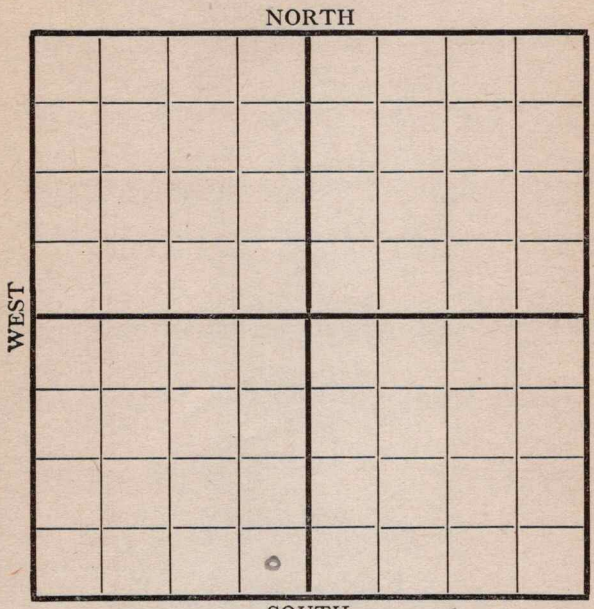

330' ~~FSL~~ x 330' ~~FE~~ E Line

Location ____

Rig up ____

Drilling and Remarks:

1720

RECORD

Cased ____ in., ____ ft.

Sand ____

Gas ____

Oil ____

Total Depth ____

PRODUCTION

1st 24 hrs. Nat. ____

1st 24 hrs. after shot ____

Gas ____ Cu. Ft.

Dry Hole ____

Abandoned ____

Date

7/31 191 8 Scout


Form 26—1M Books of 100 Sheets Each—4-15-18

Map No. _____ Sec. 35 Twp. 27 R. 4

Well No. 7 Moyle

Engineer _____ Company

_____ Contractor

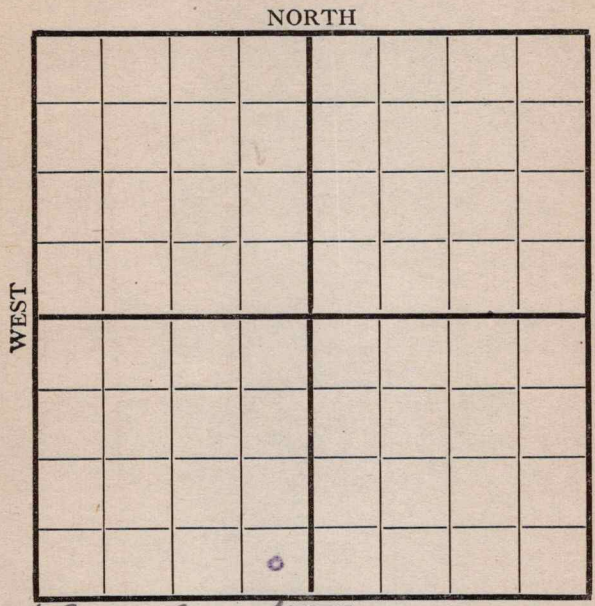

330 E 8 S

Location _____

Rig up _____

Drilling and Remarks:

2345

RECORD

Cased _____ in., _____ ft.

Sand _____

Gas _____

Oil _____

Total Depth _____

PRODUCTION

1st 24 hrs. Nat. _____

1st 24 hrs. after shot _____

Gas _____ Cu. Ft.

Dry Hole _____

Abandoned _____

Date

8/14 _____ 191 _____ Scout


Form 26—1M Books of 100 Sheets Each—4-15-18

Map No. _____ Sec. 35 Twp. 27 R. 4

Well No. 7 Moyle

Company

Contractor

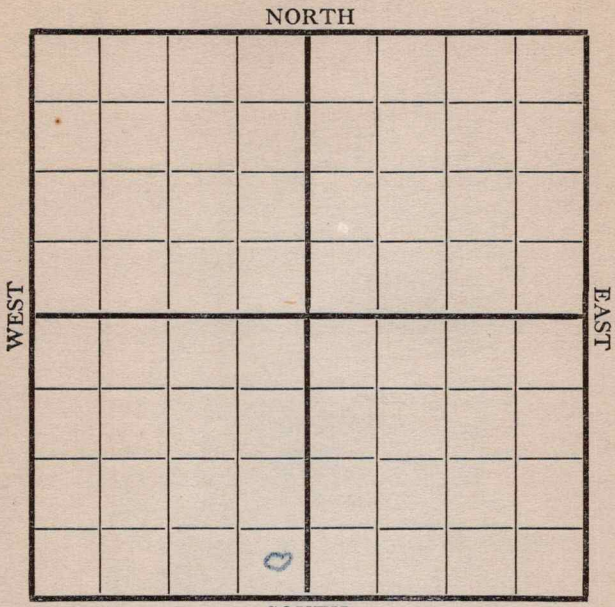

Location _____

Rig up _____

Drilling and Remarks:

LR
2375

RECORD

Cased _____ in., _____ ft.

Sand _____

Gas _____

Oil _____

Total Depth _____

PRODUCTION

1st 24 hrs. Nat. _____

1st 24 hrs. after shot _____

Gas _____ Cu. Ft.

Dry Hole _____

Abandoned _____

Date

8/21 191 8

Scout


Form 26—1M Books of 100 Sheets Each—4-15-18

Map No. K11 Sec. 35 Twp. 27 R. 4

Well No. 7 Mongle

Empire Company

Contractor

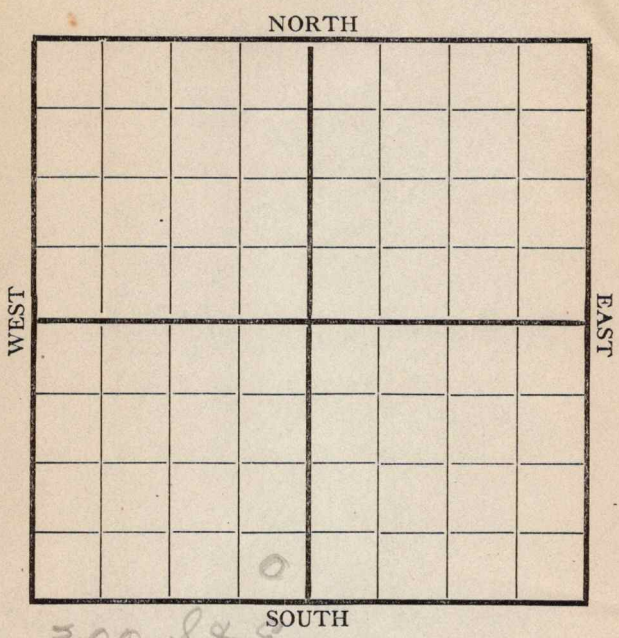

Location

Rig up

Drilling and Remarks:

Top Sand 2568

RECORD

Cased in., ft.

Sand

Gas

Oil

Total Depth

PRODUCTION

1st 24 hrs. Nat.

1st 24 hrs. after shot

Gas Cu. Ft.

Dry Hole

Abandoned

Date 1/28 191

Scout

Form 26—1M Books of 100 Sheets Each—4-15-18

1001

Map No. K 11 Sec. 35 Twp. 27 R. 4

Well No. 7 Murphy

Empire Company

Contractor

NORTH

WEST

COMPLETED

EAST

SOUTH

300 S & E

Location

Rig up

Drilling and Remarks:

Estat

7 5/8 Csg

RECORD

Cased in., ft.

Sand 2568-2620

Gas

Oil

Total Depth

PRODUCTION

1st 24 hrs. Nat.

1st 24 hrs. after shot

Gas Cu. Ft.

Dry Hole

Abandoned

Date 9/6 191 8 Scout