

KANSAS


FORM 51 5M 10-41 PETROL

Greenwood ✓

Section 9 Township 25 Range 11-E

Well No. #1 Christy

Company Dunne Bros.

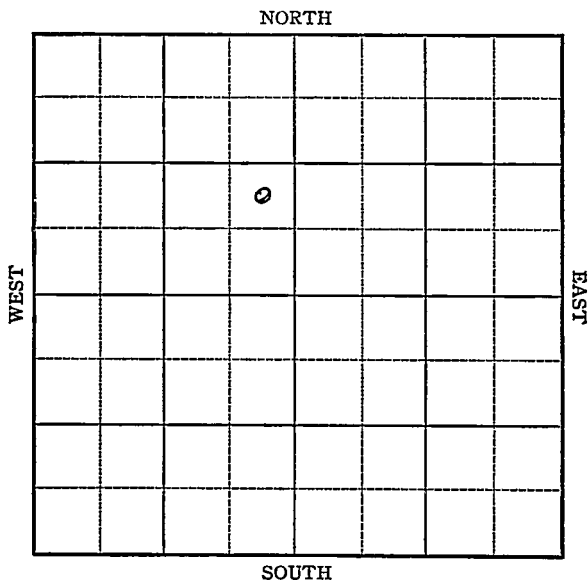

KANSAS

Greenwood

Sec. 9 Twp. 25 R. 11-E

Well No. #1 Christy Farm

Dunne Bros. Company


Virgil

Ft. from N. Line

990 Ft. from S. Line

330 Ft. from E. Line

Ft. from W. Line

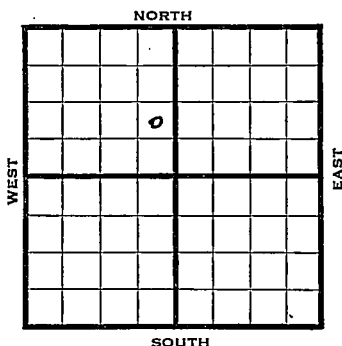

1943

REPORT

1/6

8"-688'  
6"-1100'  
Bart. 1650'-67'  
Water  
D & A  
T. D. 1708'

FIRST REPORT

ABANDONED

**KANSAS**  
 Map No. 7 Sec. 9 Twp. 25 R. 11E

Well No. 1 Christy

Dunne Bros. Company

# **FIRST REPORT**

Contractor

NE SE NW

**ABANDONED**


SECTION PLAT

       Ft. from N. Line

990 Ft. from S. Line

330 Ft. from E. Line

       Ft. from W. Line

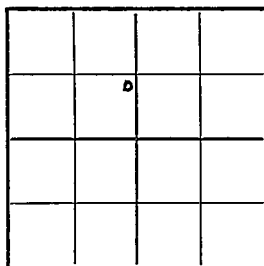

**VIRGIL POOL**

Location                                 

Rig up                                 

Drilling and Remarks:

8" - 688'

6" - 1100'

'Bart. 1650' - 67'

Water

D & A

## **RECORD**

Cased            in.,            ft.

Sand                                 

Gas                                 

Oil                                 

Total Depth 1708'

## **PRODUCTION**

1st 24 hrs. Nat.                                 

1st 24 hrs. after shot                                 

Gas                                  Cu. Ft.

Dry Hole                                 

Abandoned                                 

Date

JAN 6 1943 19 S. J. LEWIS Scout