


Map No. \_\_\_\_\_ Sec. 30 Twp. 26 R. 5Well No. 1-Loaglev Farm \_\_\_\_\_Page St al. Company \_\_\_\_\_

NORTH

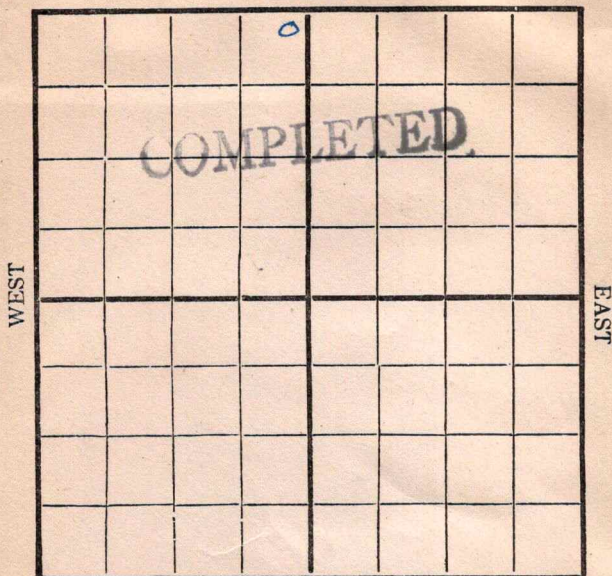

SOUTH

Location \_\_\_\_\_

Rig Up 1-22-17

Drilling Remarks:

Drilling Remarks:

## RECORD

Cased \_\_\_\_\_ in \_\_\_\_\_ Ft.

S and \_\_\_\_\_

Gas \_\_\_\_\_

Oil \_\_\_\_\_

Total Depth \_\_\_\_\_

## PRODUCTION

1st 24 hrs. Nat \_\_\_\_\_

1st 24 hrs. after shot \_\_\_\_\_

Gas \_\_\_\_\_ Cu. Ft.


Dry Hole \_\_\_\_\_

Abandoned \_\_\_\_\_

Map No. \_\_\_\_\_ Sec. 30 Twp. 26 R. 5  
 Well No. 1 Koogler Farm \_\_\_\_\_  
Page et al Company \_\_\_\_\_

NORTH

WEST

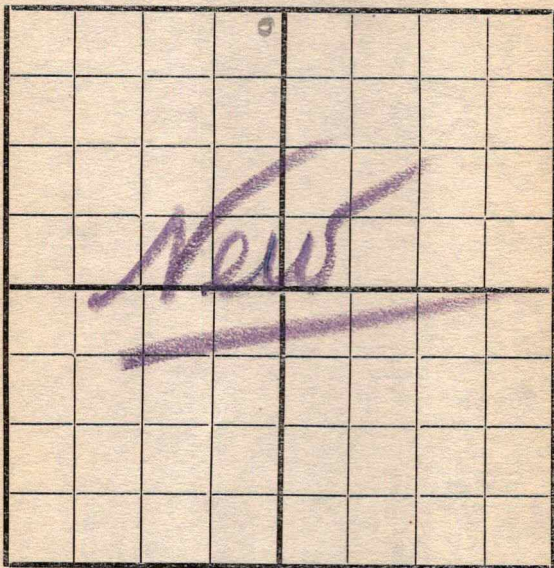

EAST

SOUTH

Location \_\_\_\_\_  
 Rig Up ☒ \_\_\_\_\_  
 Drilling and remarks \_\_\_\_\_

RECORD

Cased \_\_\_\_\_ in. \_\_\_\_\_ Ft.  
 Sand \_\_\_\_\_  
 Gas \_\_\_\_\_  
 Oil \_\_\_\_\_  
 Total Depth \_\_\_\_\_

PRODUCTION

1st 24 hrs. Nat. \_\_\_\_\_  
 1st 24 hrs. after shot \_\_\_\_\_  
 Gas \_\_\_\_\_ Cu. Ft.  
 Dry Hole \_\_\_\_\_  
 Abandoned \_\_\_\_\_

Date

1/22, 1917 Condy Scout



Map No. \_\_\_\_\_ Sec. 30 Twp. 26 R. 5  
 Well No. 1 Kogler Farm \_\_\_\_\_  
Page & Lewis Company \_\_\_\_\_

NORTH

|      |  |  |  |  |  |  |  |      |
|------|--|--|--|--|--|--|--|------|
| WEST |  |  |  |  |  |  |  | EAST |
|      |  |  |  |  |  |  |  |      |
|      |  |  |  |  |  |  |  |      |
SOUTH

Location \_\_\_\_\_  
 Rig Up \_\_\_\_\_  
 Drilling and remarks \_\_\_\_\_

RECORD

Cased \_\_\_\_\_ in. \_\_\_\_\_ Ft.  
 Sand \_\_\_\_\_  
 Gas \_\_\_\_\_  
 Oil \_\_\_\_\_  
 Total Depth \_\_\_\_\_

PRODUCTION

1st 24 hrs. Nat. \_\_\_\_\_  
 1st 24 hrs. after shot \_\_\_\_\_  
 Gas \_\_\_\_\_ Cu. Ft.  
 Dry Hole \_\_\_\_\_  
 Abandoned \_\_\_\_\_


Date

1/29, 1917 Candy Scout \_\_\_\_\_

Map No. \_\_\_\_\_ Sec. 30 Twp. 26 R. 5Well No. 1 Kogler FarmPage 2 Lewis Company

NORTH

WEST

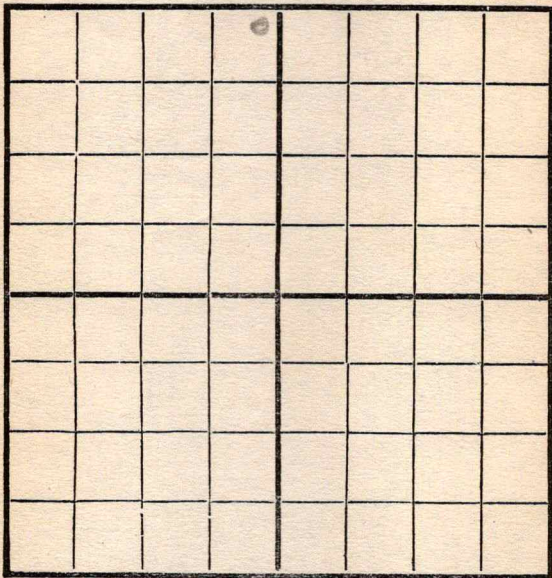

EAST

SOUTH

Location \_\_\_\_\_

Rig Up ☒ \_\_\_\_\_

Drilling and remarks \_\_\_\_\_

## RECORD

Cased \_\_\_\_\_ in. \_\_\_\_\_ Ft.

Sand \_\_\_\_\_

Gas \_\_\_\_\_

Oil \_\_\_\_\_

Total Depth \_\_\_\_\_

## PRODUCTION

1st 24 hrs. Nat. \_\_\_\_\_

First 24 hrs. after shot \_\_\_\_\_

Gas \_\_\_\_\_ Cu. Ft.

Dry Hole \_\_\_\_\_

Abandoned \_\_\_\_\_

Date


2/5, 1912 early Scout



Map No. \_\_\_\_\_ Sec. 30 Twp. 26 R. 5Well No. Page 9 Farm \_\_\_\_\_

\_\_\_\_\_ Company

NORTH

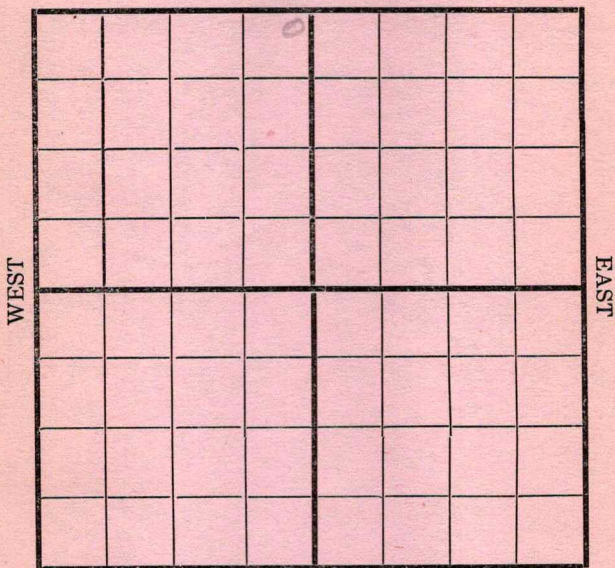

SOUTH

Location \_\_\_\_\_

Rig Up \_\_\_\_\_

Drilling and remarks \_\_\_\_\_

## RECORD

Cased \_\_\_\_\_ in. \_\_\_\_\_ Ft.

Sand \_\_\_\_\_

Gas \_\_\_\_\_

Oil \_\_\_\_\_

Total Depth \_\_\_\_\_

## PRODUCTION

1st 24 hrs. Nat. \_\_\_\_\_

1st 24 hrs. after shot \_\_\_\_\_

Gas \_\_\_\_\_ Cu. Ft.

Dry Hole \_\_\_\_\_


Abandoned \_\_\_\_\_

Date

3/12, 1912 Condit Scout

Map No. \_\_\_\_\_ Sec. 30 Twp. 26 R. 5  
 Well No. 1 Kasper Farm \_\_\_\_\_  
Page 9 L. L. L. Company \_\_\_\_\_

NORTH

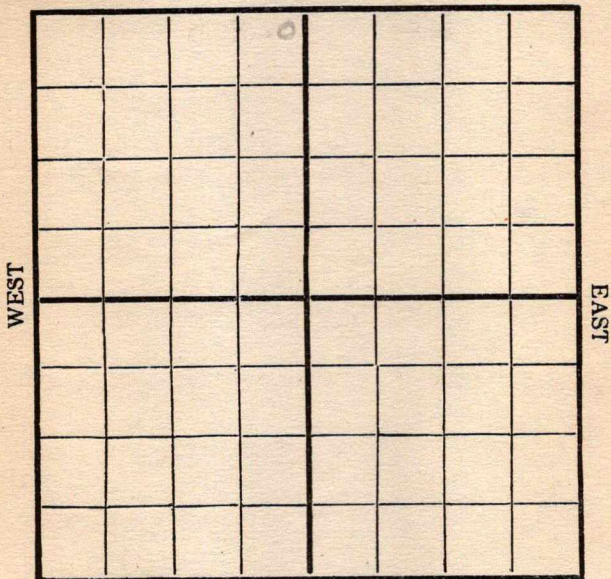

SOUTH

Location \_\_\_\_\_  
 Rig Up \_\_\_\_\_  
 Drilling and remarks \_\_\_\_\_

RECORD

Cased \_\_\_\_\_ in. \_\_\_\_\_ Ft.  
 Sand \_\_\_\_\_  
 Gas \_\_\_\_\_  
 Oil \_\_\_\_\_  
 Total Depth \_\_\_\_\_

PRODUCTION

1st 24 hrs. Nat. \_\_\_\_\_  
 1st 24 hrs. after shot \_\_\_\_\_  
 Gas \_\_\_\_\_ Cu. Ft.  
 Dry Hole \_\_\_\_\_  
 Abandoned \_\_\_\_\_

Date


2/9, 1917 Condeff Scout



Map No. \_\_\_\_\_ Sec. 30 Twp. 26 R. 5Well No. 1 Kasper Farm \_\_\_\_\_Page & Lewis Company \_\_\_\_\_

NORTH

WEST

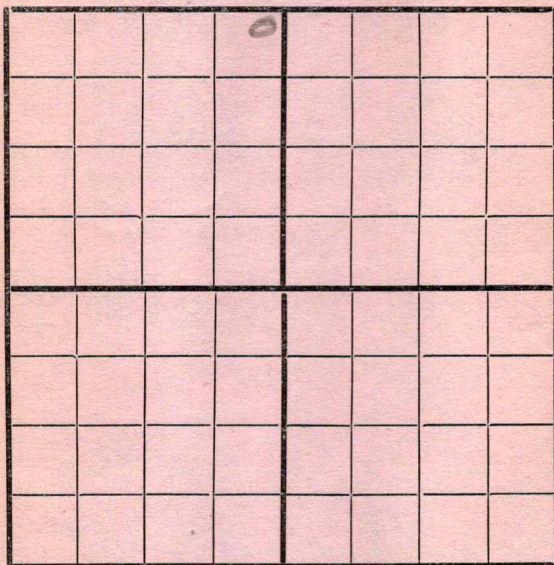

EAST

SOUTH

Location \_\_\_\_\_

Rig Up \_\_\_\_\_

Drilling and remarks

Spending

## RECORD

Cased \_\_\_\_\_ in. \_\_\_\_\_ Ft.

Sand \_\_\_\_\_

Gas \_\_\_\_\_

Oil \_\_\_\_\_

Total Depth \_\_\_\_\_

## PRODUCTION

1st 24 hrs. Nat. \_\_\_\_\_

1st 24 hrs. after shot \_\_\_\_\_

Gas \_\_\_\_\_ Cu. Ft.

Dry Hole \_\_\_\_\_

Abandoned \_\_\_\_\_


Date

7/26, 1917 Cooley Scout

Map No. \_\_\_\_\_ Sec. 30 Twp. 26 R. 5Well No. 1 Ranger \_\_\_\_\_ FarmPage 25 of \_\_\_\_\_ Company

NORTH

WEST

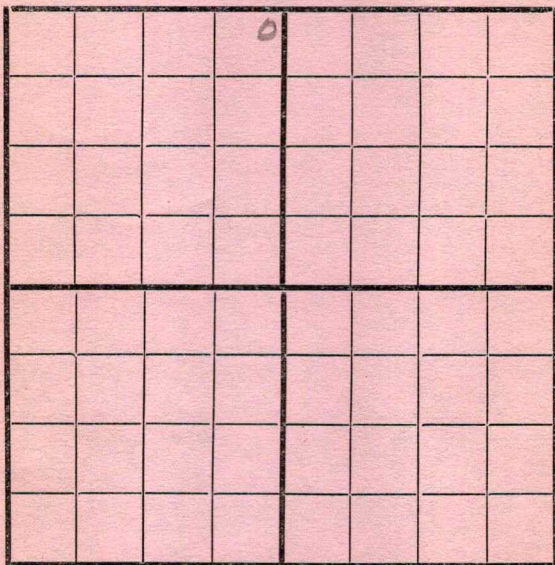

EAST

SOUTH

Location \_\_\_\_\_

Rig Up \_\_\_\_\_

Drilling and remarks

320'

## RECORD

Cased \_\_\_\_\_ in. \_\_\_\_\_ Ft.

Sand \_\_\_\_\_

Gas \_\_\_\_\_

Oil \_\_\_\_\_

Total Depth \_\_\_\_\_

## PRODUCTION

1st 24 hrs. Nat. \_\_\_\_\_

1st 24 hrs. after shot \_\_\_\_\_

Gas \_\_\_\_\_ Cu. Ft.

Dry Hole \_\_\_\_\_

Abandoned \_\_\_\_\_

Date


3/5, 1917

Scout



Map No. \_\_\_\_\_ Sec. 30 Twp. 26 R. 5

Well No. 1 Kangas Farm  
Page & Levin Company

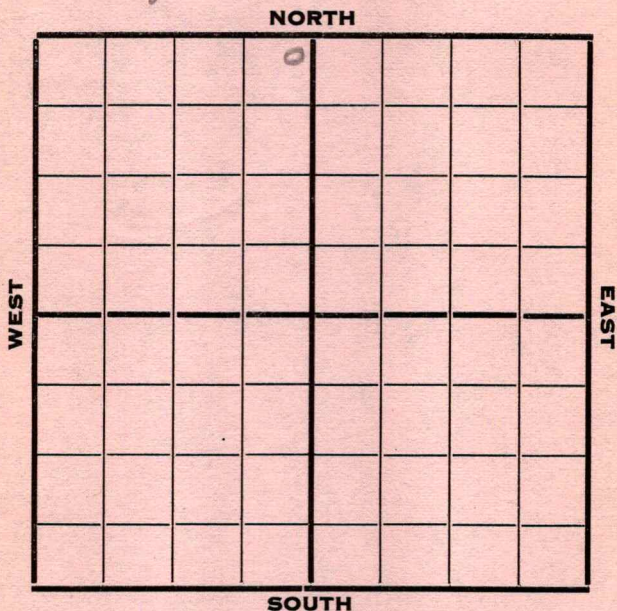

Location \_\_\_\_\_

Rig up \_\_\_\_\_

Drilling and Remarks:

500'

**RECORD**

Cased \_\_\_\_\_ in. \_\_\_\_\_ Ft.

Sand \_\_\_\_\_

Gas \_\_\_\_\_

Oil \_\_\_\_\_

Total Depth \_\_\_\_\_

**PRODUCTION**

1st 24 hrs. Nat. \_\_\_\_\_

1st 24 hrs. after shot \_\_\_\_\_

Gas \_\_\_\_\_ Cu. Ft.

Dry Hole \_\_\_\_\_

Abandoned \_\_\_\_\_


Date

3/12, 1917, Cardeff Scout

Map No. \_\_\_\_\_ Sec. 30 Twp. 26 R. 5Well No. 1 Page & Lewis Farm \_\_\_\_\_

Company \_\_\_\_\_

NORTH

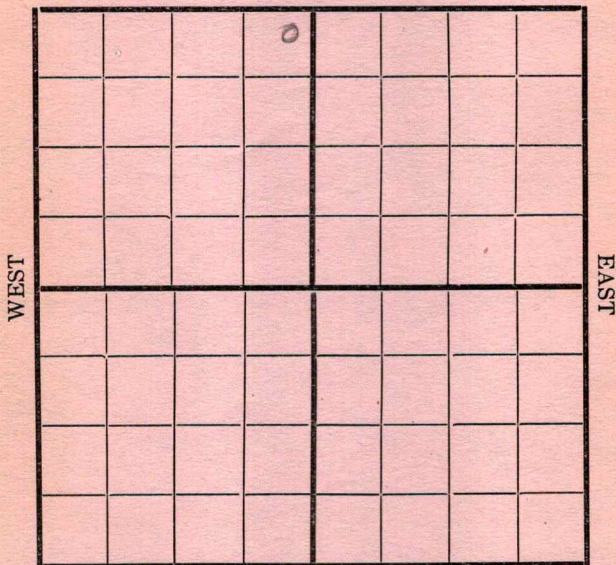

SOUTH

Location \_\_\_\_\_

Rig. Up \_\_\_\_\_

Drilling and remarks

1010'

## RECORD

Cased \_\_\_\_\_ in. \_\_\_\_\_ Ft.

Sand \_\_\_\_\_

Gas \_\_\_\_\_

Oil \_\_\_\_\_

Total Depth \_\_\_\_\_

## PRODUCTION

1st 24 hrs. Nat. \_\_\_\_\_

1st 24 hrs. after shot \_\_\_\_\_

Gas \_\_\_\_\_ Cu. Ft.

Dry Hole \_\_\_\_\_

Abandoned \_\_\_\_\_


Date

3/21, 1917 Carroll Scout



Map No. \_\_\_\_\_ Sec. 30 Twp. 26 R. 5Well No. 1 Kosgeen FarmPayed Lewis Company

NORTH

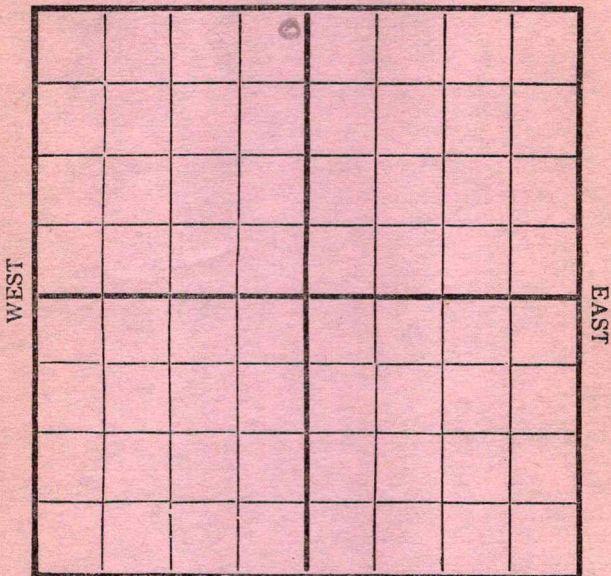

SOUTH

REMARKS:

1610

Date

9/26, 1912 Candy Scout

Map No. \_\_\_\_\_ Sec. 30 Twp. 26 R. 5  
 Well No. 1 \_\_\_\_\_ Farm \_\_\_\_\_  
Page 8 of 10 \_\_\_\_\_ Company \_\_\_\_\_

NORTH

|      |  |  |  |  |  |  |  |  |      |
|------|--|--|--|--|--|--|--|--|------|
| WEST |  |  |  |  |  |  |  |  | EAST |
|      |  |  |  |  |  |  |  |  |      |
|      |  |  |  |  |  |  |  |  |      |
SOUTH

Location \_\_\_\_\_  
 Rig Up \_\_\_\_\_  
 Drilling and remarks \_\_\_\_\_

1950

RECORD

Cased \_\_\_\_\_ in. \_\_\_\_\_ Ft.  
 Sand \_\_\_\_\_  
 Gas \_\_\_\_\_  
 Oil \_\_\_\_\_  
 Total Depth \_\_\_\_\_

PRODUCTION

1st 24 hrs. Nat. \_\_\_\_\_  
 1st 24 hrs. after shot \_\_\_\_\_  
 Gas \_\_\_\_\_ Cu. Ft.  
 Dry Hole \_\_\_\_\_  
 Abandoned \_\_\_\_\_

Date 4/5, 1917 Carley Scout



Map No. \_\_\_\_\_ Sec. 30 Twp. 26 R. 5Well No. 1 Kasper Farm \_\_\_\_\_Page 20 of \_\_\_\_\_ Company \_\_\_\_\_

NORTH

WEST

EAST

SOUTH

Location \_\_\_\_\_

Rig Up \_\_\_\_\_

Drilling and remarks

2015'

## RECORD

Cased \_\_\_\_\_ in. \_\_\_\_\_ Ft.

Sand \_\_\_\_\_

Gas \_\_\_\_\_

Oil \_\_\_\_\_

Total Depth \_\_\_\_\_

## PRODUCTION

1st 24 hrs. Nat. \_\_\_\_\_

1st 24 hrs. after shot \_\_\_\_\_

Gas \_\_\_\_\_ Cu. Ft.

Dry Hole \_\_\_\_\_


Abandoned \_\_\_\_\_

Date

4/11, 1917 Cord Scout \_\_\_\_\_

Map No. \_\_\_\_\_ Sec. 30 Twp. 26 R. 5  
 Well No. 1 Kingle Farm \_\_\_\_\_  
Page & Lewis Company \_\_\_\_\_

NORTH

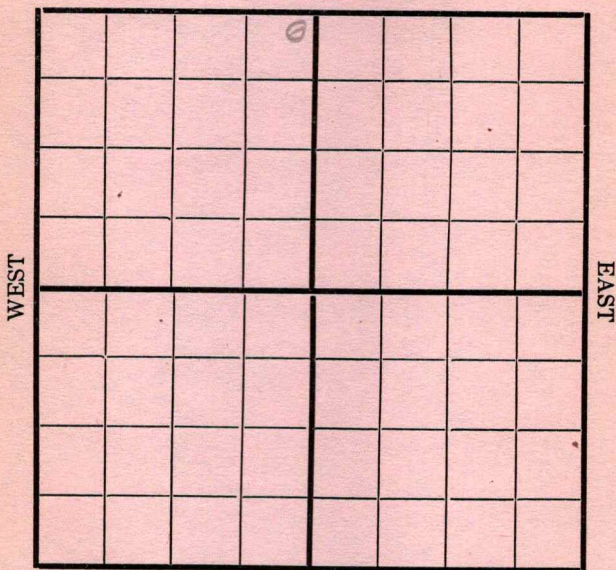

SOUTH

Location \_\_\_\_\_

Rig Up \_\_\_\_\_

Drilling and remarks

2460'

**RECORD**

Cased \_\_\_\_\_ in. \_\_\_\_\_ Ft.

Sand \_\_\_\_\_

Gas \_\_\_\_\_

Oil \_\_\_\_\_

Total Depth \_\_\_\_\_

**PRODUCTION**

1st 24 hrs. Nat. \_\_\_\_\_

1st 24 hrs. after shot \_\_\_\_\_

Gas \_\_\_\_\_ Cu. Ft.

Dry Hole \_\_\_\_\_

Abandoned \_\_\_\_\_


Date

4/19, 1917 Carley Scout



Map No. \_\_\_\_\_ Sec. 30 Twp. 26 R. 5  
 Well No. 1 Hoagden Farm \_\_\_\_\_  
Page 7 Davis Company \_\_\_\_\_

NORTH

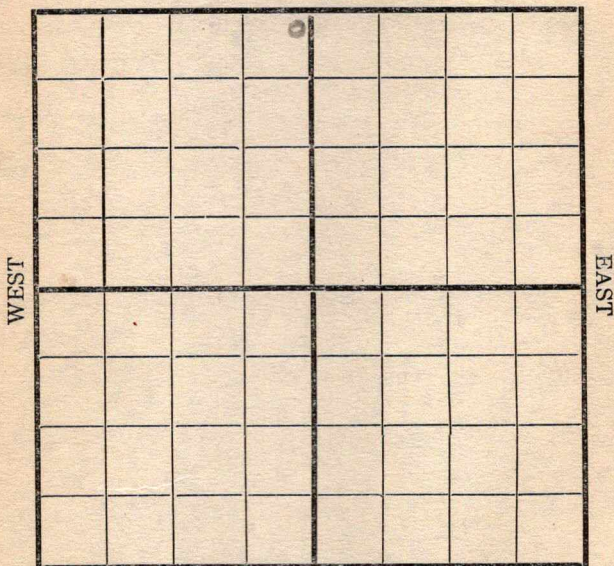

SOUTH

Location \_\_\_\_\_

Rig Up \_\_\_\_\_

Drilling and remarks

*will tube  
and test*

## RECORD

Cased \_\_\_\_\_ in. \_\_\_\_\_ Ft.

Sand 2609-2613

Gas \_\_\_\_\_

Oil \_\_\_\_\_

Total Depth \_\_\_\_\_

## PRODUCTION

1st 24 hrs. Nat. \_\_\_\_\_

1st 24 hrs. after shot \_\_\_\_\_

Gas \_\_\_\_\_ Cu. Ft.

Dry Hole \_\_\_\_\_


Abandoned \_\_\_\_\_

Date

4/26, 1917 Cordiff Scout

Map No. *K-14* Sec. *30* Twp. *26* R. *5*Well No. *1 Koogler* Farm  
*Paye & Lewis* Company

NORTH

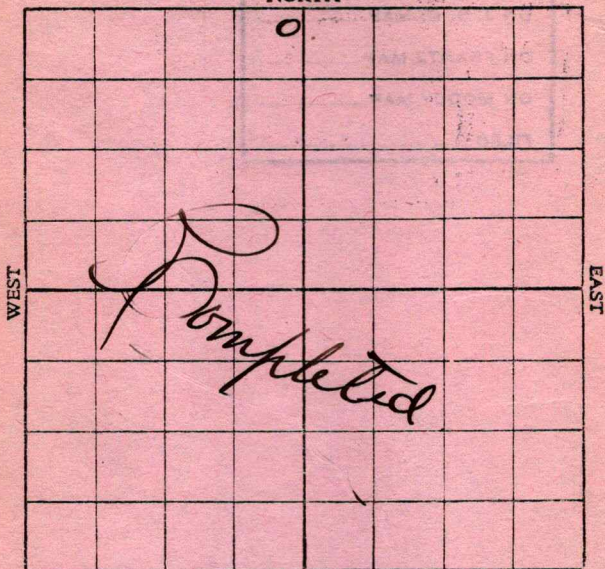

SOUTH

Location \_\_\_\_\_

Rig up \_\_\_\_\_

Drilling and remarks:

*Pumped 40*  
*bbls. 1st*  
*24 hrs.*

## RECORD

Cased \_\_\_\_\_ in. \_\_\_\_\_ Ft.

Sand \_\_\_\_\_

Gas \_\_\_\_\_

Oil *2609 - 2613*

Total Depth \_\_\_\_\_

## PRODUCTION

1st 24 hrs. Nat. \_\_\_\_\_

1st 24 hrs. after shot \_\_\_\_\_

Gas \_\_\_\_\_ Cu. Ft.

Dry Hole \_\_\_\_\_

Abandoned \_\_\_\_\_

Date

*5/5*, 191*7*, *Drocker* Scout



Map No. \_\_\_\_\_ Sec. 30 Twp. 26 R. 5

Well No. \_\_\_\_\_ Farm \_\_\_\_\_

Company \_\_\_\_\_

NORTH

|   |  |  |  |  |  |  |  |  |  |
|---|--|--|--|--|--|--|--|--|--|
| North Line - Osage Nation   |  |  |  |  |  |  |  |  |  |
| <div style="border: 2px solid red; padding: 5px; text-align: center;"> <b>RECEIVED</b><br/> <b>Treasurer's Office</b><br/> <b>OCT 12 1917</b> </div> |  |  |  |  |  |  |  |  |  |
| <div style="border: 2px solid red; padding: 5px; text-align: center;"> <b>REFERRED TO</b> </div>                                                     |  |  |  |  |  |  |  |  |  |
| M. A. Hoogler   |  |  |  |  |  |  |  |  |  |
| 40   |  |  |  |  |  |  |  |  |  |

EAST

WEST

SOUTH

Location \_\_\_\_\_

Rig Up \_\_\_\_\_

Drilling and remarks \_\_\_\_\_

**RECORD**

Cased \_\_\_\_\_ in. \_\_\_\_\_ Ft.

Sand \_\_\_\_\_

Gas \_\_\_\_\_

Oil \_\_\_\_\_

Total Depth \_\_\_\_\_

**PRODUCTION**

1st 24 hrs. Nat. \_\_\_\_\_

1st 24 hrs. after shot \_\_\_\_\_

Gas \_\_\_\_\_ Cu. Ft.

Dry Hole \_\_\_\_\_

Abandoned \_\_\_\_\_

Date \_\_\_\_\_

\_\_\_\_\_, 191\_\_\_\_ Scout \_\_\_\_\_

Our map shows a  
#1 producing well  
at your #7 Location.  
What is correct?

RETURNED BY \_\_\_\_\_  
ON TRACING \_\_\_\_\_  
ON J. S. C. MAP \_\_\_\_\_  
ON FRANTZ MAP \_\_\_\_\_  
ON MOODY MAP \_\_\_\_\_  
FILED \_\_\_\_\_

SOUTH

RECORD

Gas \_\_\_\_\_  
Sand \_\_\_\_\_  
Lias \_\_\_\_\_  
Oil \_\_\_\_\_  
Total Depth \_\_\_\_\_

PRODUCTION

1st 24 hrs. after \_\_\_\_\_  
1st 24 hrs. after shut \_\_\_\_\_  
Gas \_\_\_\_\_  
D.Y. Hole \_\_\_\_\_  
Abandoned \_\_\_\_\_

Location

This is

bottom and remarks

Date



Map No. \_\_\_\_\_ Sec. 30 Twp. 26 R. 5Well No. 1700 gler Farm \_\_\_\_\_Company Lewis & Page

NORTH

EAST

WEST

SOUTH

Location \_\_\_\_\_

Rig up \_\_\_\_\_

Drilling and remarks:

*Completed well*

## RECORD

Cased \_\_\_\_\_ in. \_\_\_\_\_ Ft.

Sand \_\_\_\_\_

Gas \_\_\_\_\_

Oil \_\_\_\_\_

Total Depth \_\_\_\_\_

## PRODUCTION

1st 24 hrs. Nat. \_\_\_\_\_

1st 24 hrs. after shot \_\_\_\_\_

Gas \_\_\_\_\_ Cu. Ft.

Dry Hole \_\_\_\_\_

Abandoned \_\_\_\_\_

Date

10/9, 1917, Candys Scout

Map No. \_\_\_\_\_ Sec. 30 Twp. 26 R. 5

Well No. 1 Kogler Farm \_\_\_\_\_

Lewis & P. & Co Company \_\_\_\_\_

NORTH

|  |  |  |  |  |  |  |  |
|--|--|--|--|--|--|--|--|
|  |  |  |  |  |  |  |  |
|  |  |  |  |  |  |  |  |
SOUTH

Location \_\_\_\_\_

Rig up \_\_\_\_\_

Drilling and remarks:

*Corrected  
location of  
Completed  
well #1*

RECORD

Cased \_\_\_\_\_ in. \_\_\_\_\_ Ft.

Sand \_\_\_\_\_

Gas \_\_\_\_\_

Oil \_\_\_\_\_

Total Depth \_\_\_\_\_

PRODUCTION

1st 24 hrs. Nat. \_\_\_\_\_

1st 24 hrs. after shot \_\_\_\_\_

Gas \_\_\_\_\_ Cu. Ft.

Dry Hole \_\_\_\_\_

Abandoned \_\_\_\_\_

Date

10/9, 1917, Landry Scout