

Map No. _____ Sec. 35 Twp. 27 R. 4
 Well No. 1 Skoer (SKoer) Farm _____
Empire Company

NORTH

WEST

EAST



SOUTH

Location _____

Rig Up _____

Drilling Remarks:

Drilling Remarks:

RECORD

PRODUCTION

Cased _____ in _____ Ft.

1st 24 hrs. Nat. _____

S and _____

1st 24 hrs. after shot _____

Gas _____

Gas _____ Cu. Ft.

Oil _____


Dry Hole _____

Total Depth _____

Abandoned _____

Map No. _____ Sec. 35 Twp. 27 R. 4
 Well No. 1 Spencer Farm _____
Empire Company _____

NORTH

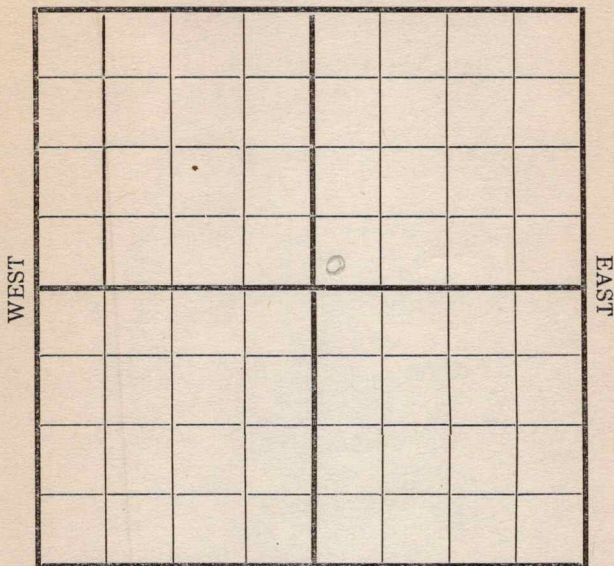

SOUTH

Location _____
 Rig Up ☒ _____
 Drilling and remarks _____

FIRST REPORT

RECORD

Cased _____ in. _____ Ft.
 Sand _____
 Gas _____
 Oil _____
 Total Depth _____

PRODUCTION

1st 24 hrs. Nat. _____
 1st 24 hrs. after shot _____
 Gas _____ Cu. Ft.
 Dry Hole _____
 Abandoned _____

Date


2/12, 1917 Condit Scout

Map No. _____ Sec. 35 Twp. 27 R. 4
 Well No. 1 Steen Farm _____
Empire Company _____

NORTH

WEST

EAST

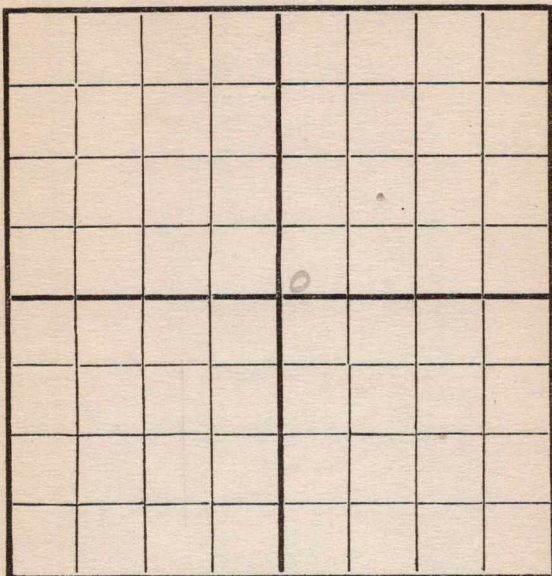

SOUTH

Location _____
 Rig Up _____
 Drilling and remarks _____

RECORD

Cased _____ in. _____ Ft.
 Sand _____
 Gas _____
 Oil _____
 Total Depth _____

PRODUCTION


1st 24 hrs. Nat. _____
 1st 24 hrs. after shot _____
 Gas _____ Cu. Ft.
 Dry Hole _____
 Abandoned _____

Date

191

Scout

Map No. _____ Sec. 35 Twp. 27 R. 4
 Well No. 1st Rock Farm _____
Engine Company _____
 NORTH

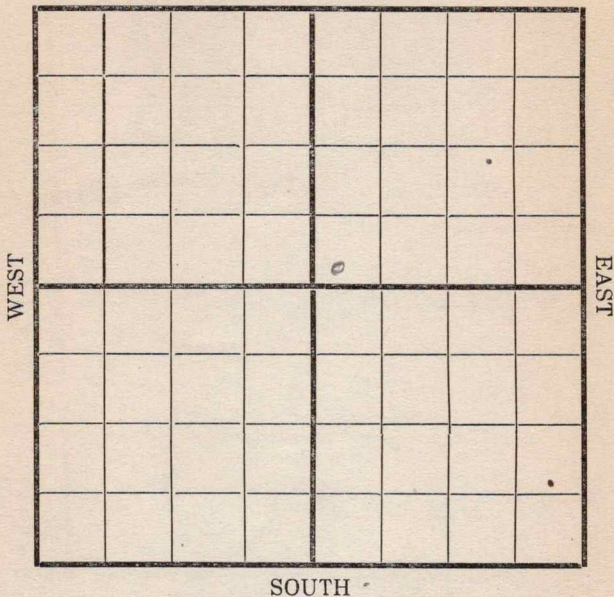

Location _____
 Rig Up ✓ _____
 Drilling and remarks _____

RECORD

Cased _____ in. _____ Ft.
 Sand _____
 Gas _____
 Oil _____
 Total Depth _____

PRODUCTION


1st 24 hrs. Nat. _____
 1st 24 hrs. after shot _____
 Gas _____ Cu. Ft.
 Dry Hole _____
 Abandoned _____

Date Dec 7, 1917 Condy Scout

Map No. _____ Sec. 35 Twp. 27 R. 4Well No. 1 SKR Farm _____
Engine Company _____

NORTH

WEST

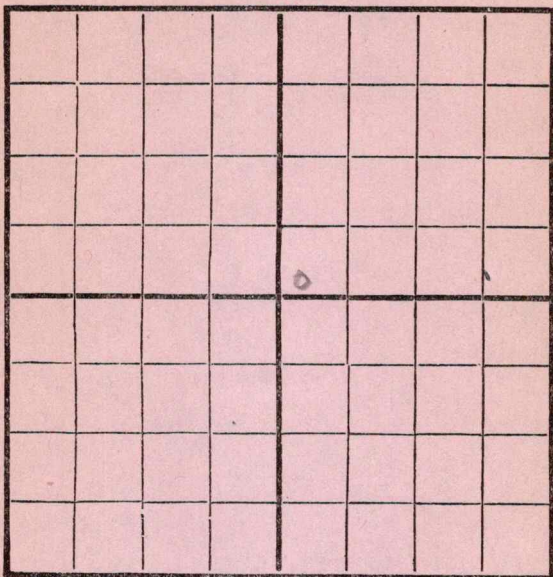

EAST

SOUTH

REMARKS:

Rig

Date

35, 1917Conley

Scout

Map No. _____ Sec. 35 Twp. 27 R. 4


Well No. 1-12-1 Farm _____

Cummins Company _____

NORTH

WEST

EAST

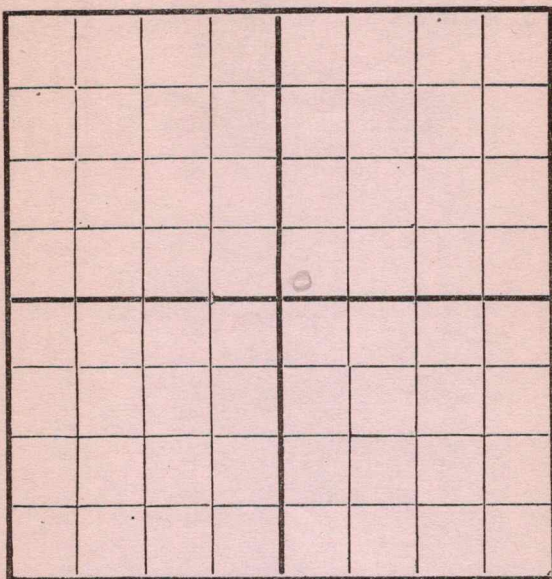

SOUTH

Location _____

Rig Up _____

Drilling and remarks

150

RECORD

Cased _____ in. _____ Ft.

Sand _____

Gas _____

Oil _____

Total Depth _____

PRODUCTION

1st 24 hrs. Nat. _____

1st 24 hrs. after shot _____

Gas _____ Cu. Ft.

Dry Hole _____

Abandoned _____

Date


3/12, 191 2 Cummins Scout

Map No. _____ Sec. 35 Twp. 27 R. 4Well No. 1 Sker _____ Farm _____Empire _____ Company _____

NORTH

WEST

EAST

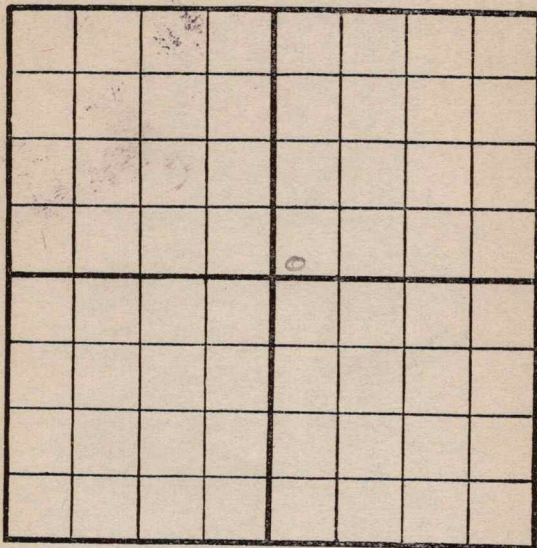

SOUTH

Location _____

Rig Up _____

Drilling and remarks

600

RECORD

Cased _____ in. _____ Ft.

Sand _____

Gas _____

Oil _____

Total Depth _____

PRODUCTION

1st 24 hrs. Nat. _____

1st 24 hrs. after shot _____

Gas _____ Cu. Ft.

Dry Hole _____


Abandoned _____

Date

3/19, 1917 Carly Scout

Map No. _____ Sec. 35 Twp. 22 R. 4
 Well No. 1 Skene Farm _____
Engine Company _____

NORTH

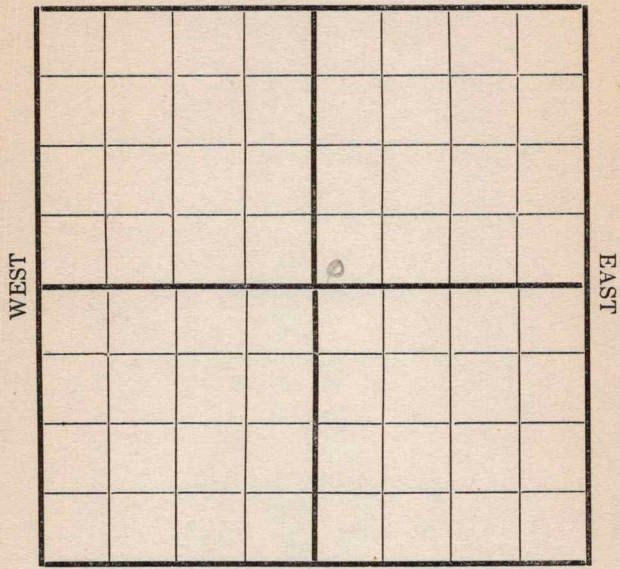


SOUTH

Location _____ Rig Up _____ Drilling and remarks <u>000'</u>	RECORD
	Cased _____ in. _____ Ft.
	Sand _____
	Gas _____
	Oil _____
	Total Depth _____
	PRODUCTION
	1st 24 hrs. Nat. _____
	1st 24 hrs. after shot _____
	Gas _____ Cu. Ft.
	Dry Hole _____
	Abandoned _____

Date 3/26, 1917 C. C. C. Co. Scout _____

Map No. _____ Sec. 35 Twp. 27 R. 4
 Well No. 1265 Farm _____
Empire Company _____

NORTH

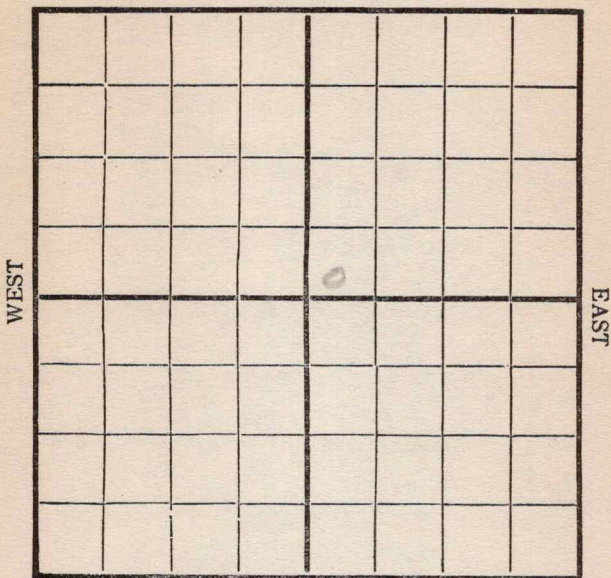

SOUTH

Location _____
 Rig Up _____
 Drilling and remarks _____

1265

RECORD

Cased _____ in. _____ Ft.
 Sand _____
 Gas _____
 Oil _____
 Total Depth _____

PRODUCTION

1st 24 hrs. Nat. _____
 First 24 hrs. after shot _____
 Gas _____ Cu. Ft.
 Dry Hole _____
 Abandoned _____

Date 4/4, 1917 Empire Scout

Map No. _____ Sec. 35 Twp. 22 R. 4Well No. 1 steam Farm _____
Engine Company _____

NORTH

WEST

EAST

SOUTH

Location _____

Rig Up _____

Drilling and remarks

*Rig burned
Down Re-
building -
1265'*

RECORD

Cased _____ in. _____ Ft.

Sand _____

Gas _____

Oil _____

Total Depth _____

PRODUCTION

1st 24 hrs. Nat. _____

1st 24 hrs. after shot _____

Gas _____ Cu. Ft.

Dry Hole _____

Abandoned _____

Date


4/10 191 *2. Carby* Scout

Map No. _____ Sec. 35 Twp. 27 R. 4
 Well No. 1265 Farm _____
Engine Company _____

NORTH

WEST

EAST

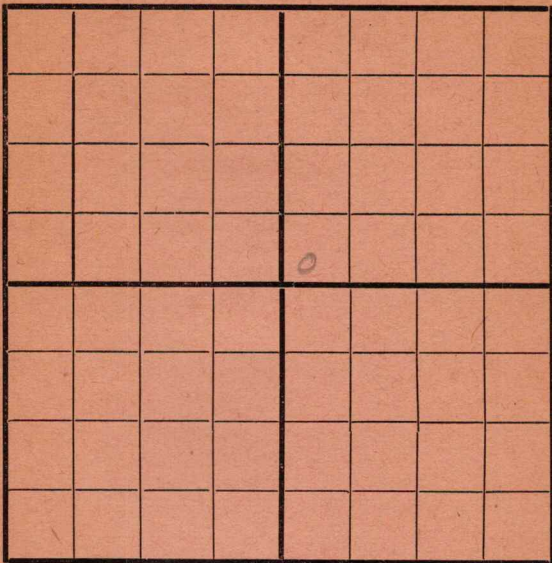

SOUTH

Location _____
 Rig Up _____
 Drilling and remarks _____

RECORD

Cased _____ in. _____ Ft.
 Sand _____
 Gas _____
 Oil _____
 Total Depth _____

PRODUCTION

1st 24 hrs. Nat. _____
 1st 24 hrs. after shot _____
 Gas _____ Cu. Ft.
 Dry Hole _____
 Abandoned _____


Date _____

191 _____

Scout _____

Map No. _____ Sec. 35 Twp. 22 R. 4Well No. 1-5000 _____ Farm
Empire _____ Company

NORTH

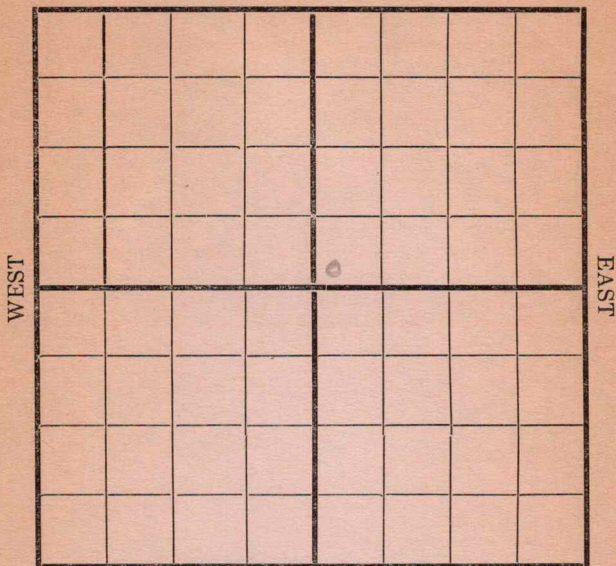

SOUTH

Location _____

Rig Up _____

Drilling and remarks

1795'

RECORD

Cased _____ in. _____ Ft.

Sand _____

Gas _____

Oil _____

Total Depth _____

PRODUCTION

1st 24 hrs. Nat. _____

1st 24 hrs. after shot _____

Gas _____ Cu. Ft.

Dry Hole _____

Abandoned _____

Date

4/24/1917 _____ Scout

Map No. _____ Sec. 35 Twp. 27 R. 4Well No. 1 Skew Farm _____
Engine Company _____

NORTH

WEST

EAST

SOUTH

Location: _____

Rig Up _____

Drilling and remarks

RECORD

Cased _____ in. _____ Ft.

Sand _____

Gas _____

Oil _____

Total Depth _____

PRODUCTION

1st 24 hrs. Nat. _____

1st 24 hrs. after shot _____

Gas _____ Cu. Ft.

Dry Hole _____

Abandoned _____

Date


3/2, 1917 Carly Scout

Map No. _____ Sec. 35 Twp. 27 R. 4
 Well No. 1 Skane Farm _____
Engine Company _____

NORTH

WEST

EAST

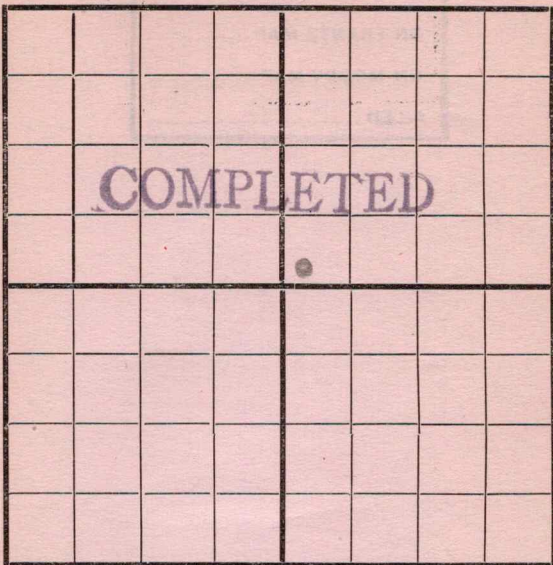

SOUTH

Location _____
 Rig Up _____
 Drilling and remarks _____

Est at
100 Bbls

RECORD

Cased _____ in. _____ Ft.
 Sand 2093-2090
 Gas _____
 Oil _____
 Total Depth _____

PRODUCTION

1st 24 hrs. Nat. _____
 1st 24 hrs. after shot _____
 Gas _____ Cu. Ft.
 Dry Hole _____
 Abandoned _____

Date 5/8, 1917 Condit Scout