


Map No. 10 Sec. 2 Twp. 23 R. 9

Well No. 3<sup>A</sup> Hartley Farm

Greenland Oil Co. Company

NORTH

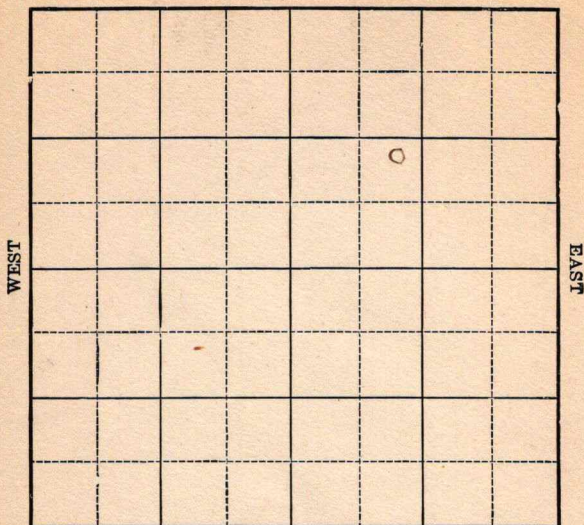

Location \_\_\_\_\_

### Drilling Remarks

Rig Up\_\_\_\_\_

### Drilling Remarks

# RECORD

Cased \_\_\_\_\_ in. \_\_\_\_\_ ft.

# Sand

# Gas

# Oil

Total Depth

## PRODUCTION

1st 24 hrs. Nat. ....

1st. 24 hrs. after shot.....

**Gas** \_\_\_\_\_ **cu. ft.**

Dry Hole\_\_\_\_\_

Abandoned \_\_\_\_\_

Map No. Kansas Sec. 2 Twp. 23 R 9


Well No. 3<sup>A</sup> Hartley Farm  
Greenland Oil Company

\_\_\_\_\_ Ft. from N. Line

990 Ft. from S. Line

\_\_\_\_\_ Ft. from E. Line

990 Ft. from W. Line

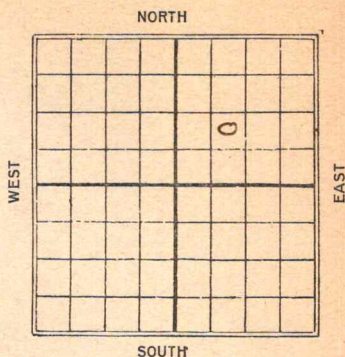

Date

1925

REPORT

5/1 Sandy shale 2395-2405  
Sand 2405-29 Slugged  
Back to 2427  
80 gts 100 Bbls


COMPLETED

## SECTION PLAT

|  |  |   |  |
|--|--|---|--|
|  |  |   |  |
|  |  | o |  |
|  |  |   |  |
|  |  |   |  |

\_\_\_\_\_ Ft. from N. Line

990 \_\_\_\_\_ Ft. from S. Line

\_\_\_\_\_ Ft. from E. Line

990 \_\_\_\_\_ Ft. from W. Line

Location \_\_\_\_\_

Rig up \_\_\_\_\_

Drilling and Remarks:

Andy shub 2395-2405And 2405-2429Plugged Back to2427'80/ 100 bls

## RECORD

Cased \_\_\_\_\_ in., \_\_\_\_\_ ft.

Sand \_\_\_\_\_

Gas \_\_\_\_\_

Oil \_\_\_\_\_

Total Depth \_\_\_\_\_

## PRODUCTION

1st 24 hrs. Nat. \_\_\_\_\_

1st 24 hrs. after shot \_\_\_\_\_

Gas \_\_\_\_\_ Cu. Ft.

Dry Hole \_\_\_\_\_

Abandoned \_\_\_\_\_

Date

MAY 1 1925

CHAS. L. SHERWOOD

192

Scout