
Form 51 5M 8-24 16567

Map No. Kan Sec. 3 Twp. 23 R. 9

Well No. 1 Noler Farm

Tom Conway Company

A Phillips Pet

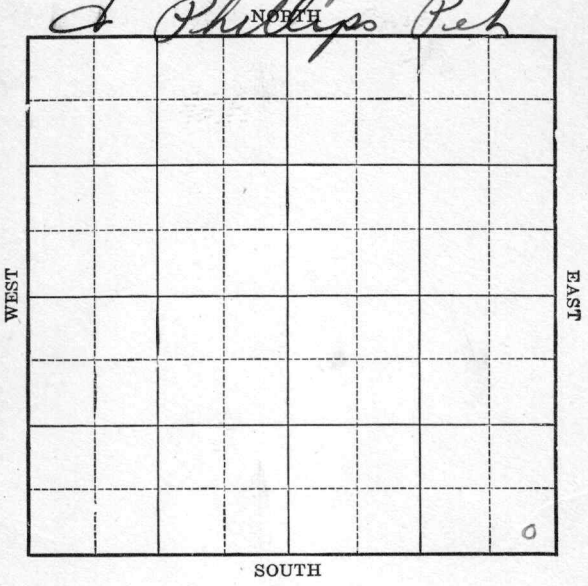

Location

Drilling Remarks

Rig Up

Drilling Remarks

RECORD

Cased in. ft.

Sand

Gas

Oil

Total Depth

PRODUCTION

1st 24 hrs. Nat.

1st. 24 hrs. after shot

Gas cu. ft.

Dry Hole

Abandoned


Form 252A 5M 8-24 16529

Map No. Kansas Sec. 3 Twp. 23 R 9

Well No. 1 Nolan Farm

~~Jones Conway~~ Company

Conway & Phillips Pet

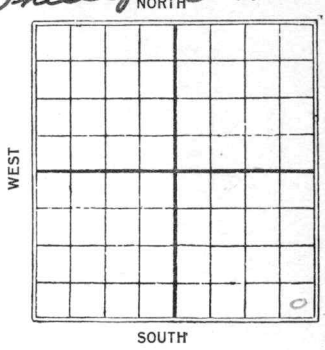

Ft. from N. Line

330 Ft. from S. Line

330 Ft. from E. Line

Ft. from W. Line

C.

Date 1925	REPORT
5/21	Timbers
5/29	Rig
6/5	Spudding
6/12	Dalg 1000
6/19	" 1520
6/26	T 2340 - oil 2348 - pulling big pipe
7/3	T.D. 2399 - T 2340 - O 2348 74 - Slate 2374-78 Pay. 2378-2399 100 Barrels

Form 26–1M Bks.—3-23—11959.

Map No. 13 15th Add Sec. 3 Twp. 23 R. 9

Well No. 1 Nobe

Tom Conway Company

Contractor

FIRST REPORTS


Ft. from N. Line

330 Ft. from S. Line

330 Ft. from E. Line

Ft. from W. Line

SECTION PLAT

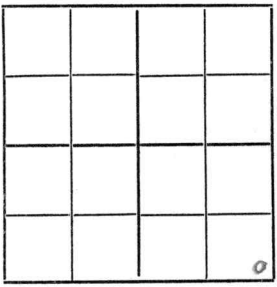

Location

Rig up Timbers

Drilling and Remarks:

RECORD

Cased in., ft.

Sand

Gas

Oil

Total Depth

PRODUCTION

1st 24 hrs. Nat.

1st 24 hrs. after shot

Gas Cu. Ft.

Dry Hole

Abandoned

Date

MAY 21 1925

192 CHAS. L. SHERWOOD Scout

Form 26—1M Bks.—3-23—11959.


Map No. 12 Sec. 3 Twp. 23 R. 9

Well No. 1 NoBR

Conway & Phillips Pet Co Company

_____ Contractor

SECTION PLAT

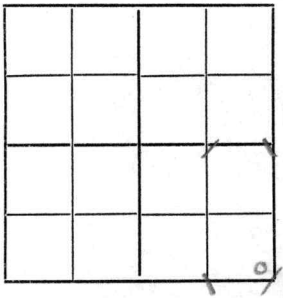

_____ Ft. from N. Line

330 Ft. from S. Line

330 Ft. from E. Line

_____ Ft. from W. Line

CORRECTION

Location _____

Rig up _____

Drilling and Remarks:

Tap at 3320' Oil 3348 Pulling Big Pipe by Owner ship to above.

RECORD

Cased _____ in., _____ ft.

Sand _____

Gas _____

Oil _____

Total Depth _____

PRODUCTION

1st 24 hrs. Nat. _____

1st 24 hrs. after shot _____

Gas _____ Cu. Ft.

Dry Hole _____

Abandoned _____

Date

JUN 26 1925

_____ 192___.

CHAS. L. SHERWOOD

_____ Scout

Form 26—1M Bks.—3-23—11959.

Map No. 12 Wards Sec. 3 Twp. 23 R. 9


Well No. 1 Tobe

Conway & Phillips Drlg Co. Company

Contractor

COMPLETED

SECTION PLAT

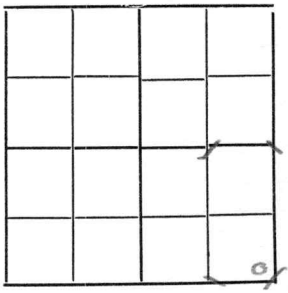

_____Ft. from N. Line

330 Ft. from S. Line

330 Ft. from E. Line

_____Ft. from W. Line

Location _____

Rig up _____

Drilling and Remarks:

Top of 2340'
1st Oil 2348'-74'
Slate 2374-78'
Pay 2378-2399'

100/200 bbls

RECORD

Cased _____ in., _____ ft.

Sand _____

Gas _____

Oil _____

Total Depth 2399'

PRODUCTION

1st 24 hrs. Nat. _____

1st 24 hrs. after shot _____

Gas _____ Cu. Ft.

Dry Hole _____

Abandoned _____

Date

JUL 3 1925

192

CHAS. L. SHERWOOD

Scout