

Map No. 1 Kans Sec. 2 Twp. 23 R. 9^E

Well No. 3 (B) Hartley Farm

~~Rodgers Riverly et al~~ Company
Greenland oil

NORTH

SOUTH

WEST

EAST

Location _____

Drilling Remarks

RECORD

Cased _____ in. _____ ft.

Sand _____

Gas _____

Oil _____

Total Depth _____

Rig Up _____

Drilling Remarks

PRODUCTION

1st 24 hrs. Nat. _____

1st. 24 hrs. after shot _____

Gas _____ cu. ft.

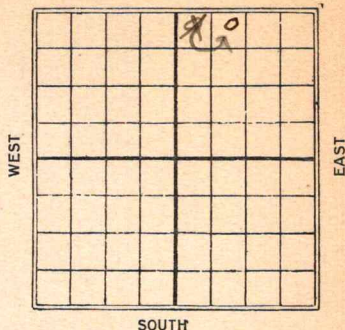
Dry Hole _____

Abandoned _____

Map No. 1 Kansas Sec. 2 Twp. 23 R. 9^EWell No. 3^(B) Hartley Farm
~~Rodgers & Renteria~~ Greenland oil Company
NORTH330 Ft. from N. Line

Ft. from S. Line

Ft. from E. Line

330
330 Ft. from W. Line

C.

Date	REPORT
1925	
4/6	Location
5/29	Spudding
6/5	Dly 350'
6/12	✓ 1360'
6/19	✓ 2000'
6/26	✓ 2398
7/3	\$ 2398 - log. 2400' in sd.
7/10	2400
7/17	tools in hole 2400 shanty tools
7/24	Added Rig 75' Southwest.
7/31	Logging up
8/17	
8/14	650'
8/20	1540
8/26	2100
9/3	SD 2388'
9/11	Stand 2393-2472 120 gals 150 Bbls

15
 Map No. **KANSAS** Sec. 2 Twp. 23 R. 9 ^E
Well No. 3^(B) HartleyRodgers Roney et al. Company

Contractor

FIRST REPORT

SECTION PLAT

330 Ft. from N. Line

Ft. from S. Line

Ft. from E. Line

330 Ft. from W. Line

		0	

Location ✓✓

Rig up

Drilling and Remarks:

RECORD

Cased _____ in., _____ ft.

Sand _____

Gas _____

Oil _____

Total Depth _____

PRODUCTION

1st 24 hrs. Nat. _____

1st 24 hrs. after shot _____

Gas _____ Cu. Ft.

Dry Hole _____

Abandoned _____

Date

APR 6 1925

192

M. A. BENEAR

Scout

Map No. 1544 Sec. 2 Twp. 23 R. 9Well No. 38 HartleyGreenland Oil Co Company

Contractor

CORRECTION

330

Ft. from N. Line

Ft. from S. Line

Ft. from E. Line

990

Ft. from W. Line

CORRECTION

SECTION PLAT

		<u>240</u>	

Location

Rig up

Drilling and Remarks:

Spuddingchy location to above.

RECORD

Cased _____ in., _____ ft.

Sand _____

Gas _____

Oil _____

Total Depth _____

PRODUCTION

1st 24 hrs. Nat. _____

1st 24 hrs. after shot _____

Gas _____ Cu. Ft.

Dry Hole _____

Abandoned _____

Date

MAY 29 1925

CHAS. L. SHERWOOD

Scout

Map No. KANSAS Sec. 2 Twp. 22 R. 9Well No. 3 B Hartley
Sherwood Oil Co. Company

Contractor

COMPLETED

SECTION PLAT

330

Ft. from N. Line

Ft. from S. Line

Ft. from E. Line

990

Ft. from W. Line

		o	

Location

Rig up

Drilling and Remarks:

RECORD

Cased _____ in., _____ ft.

Sand 2393-2472

Gas _____

Oil _____

Total Depth 2472

PRODUCTION

1st 24 hrs. Nat. _____

1st 24 hrs. after shot _____

Gas _____ Cu. Ft.

Dry Hole _____

Abandoned _____

Date

SEP 11 1925

192

CHAS. L. SHERWOOD

Scout