X12-52 Schum

STATE: Kansas	COMPANY: Musgrove 1
COUNTY: Ellis	FARM: Kippes — WELL NO.
BLOCK	SURVEY
SEC. 13	TOTAL DEPTH: 3595'
T. 15 — R. 17W	SW-SW-SE
	COMMENCED
	COMPLETED
ALTITUDE 1954	REMARKS
PRODUCTION Dry	

CASING RECORD

Dst 3536-41 1hr
Rec 20' mud cutr Bhp 760

SHOT — QUARTS — BETWEEN
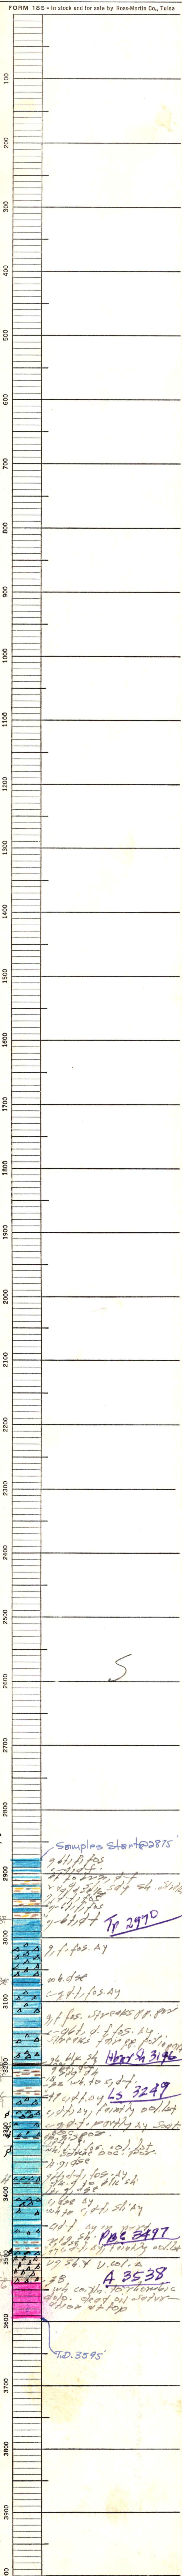
FORM 186 - In stock and for sale by Ross-Martin Co., Tulsa