


Buller Co

Map No. *Kansas* Sec. *35* Twp. *27* R. *4*

Well No. *13 Shaw* Farm

Sinclair & Empire Company

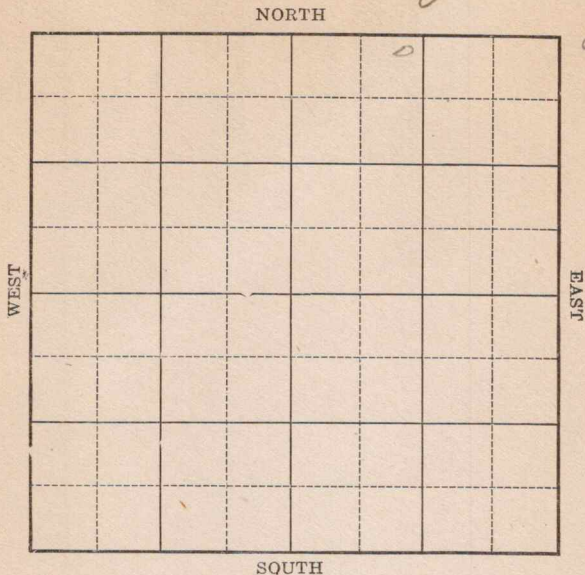

Location _____

Drilling Remarks

RECORD

Cased _____ in. _____ ft.

Sand _____

Gas _____

Oil _____

Total Depth _____

Rig Up _____

Drilling Remarks

PRODUCTION

1st 24 hrs. Nat. _____

1st 24 hrs. after shot _____

Gas _____ cu. ft.

Dry Hole _____

Abandoned _____

Butler Co

Map No. Kansas Sec. 35 Twp. 27 R. 4Well No. 13 Skar FarmSinclair & Empire Company

NORTH

WEST


EAST

SOUTH

200 Ft. from N. Line

Ft. from S. Line

Ft. from E. Line

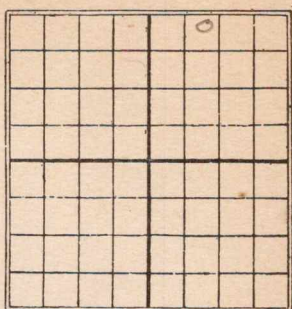990 Ft. from W. Line

Date

REPORT

192512/23 Drilling 40012/31 Drlg 865'19261/8 Running 10" 1435'1/14 Drlg 1798'1/30 ✓ 2044'1/27 Running 6" 2250'2/42/10 I.S. 2550' 200' O.F.H.2/17 I.S. 2550-2604' 1100'

oil in hole, cleaning

out. I.S. 2537-2592'

#100

2/2 Sand 2550-2604

Pumping 25 barrels

Butter Co

Map No. KANSAS 11 35 Sec. 35 Twp. 27 R. 4Well No. 13 AltonUncle Sam & Co Company

Contractor

SECTION PLAT

		0	

200 Ft. from N. Line

Ft. from S. Line

Ft. from E. Line

990 Ft. from W. Line

FIRST REPORTS

Location

Rig up

Drilling and Remarks:

Dry 400

RECORD

Cased _____ in., _____ ft.

Sand _____

Gas _____

Oil _____

Total Depth _____

PRODUCTION

1st 24 hrs. Nat. _____

1st 24 hrs. after shot _____

Gas _____ Cu. Ft.

Dry Hole _____

Abandoned _____

Date

DEC 23 1925

192

CHAS. L. SHERWOOD

Scout

Map No. 1211 Sec. 35 Twp. 27 R. 4

Well No. 13 AKAON
Linclair & Empire Company

Contractor

COMPLETED

200 Ft. from N. Line

_____ Ft. from S. Line

_____ Ft. from E. Line

990 Ft. from W. Line

SECTION PLAT

		o	

Location _____

Rig up _____

Drilling and Remarks:

RECORD

Cased _____ in., _____ ft.

Sand 2550-2604

Gas _____

Oil _____

Total Depth 2604

PRODUCTION

1st 24 hrs. Nat. _____

1st 24 hrs. after shot _____

Gas _____ Cu. Ft.

Dry Hole _____

Abandoned _____

Date

MAR 3 1926

CHAS. L. SHERWOOD

192

Scout

35 ft. pumping natural