


Butler Co

Map No. Kansas Sec. 35 Twp. 27 R. 4

Well No. 14 Skaw Farm

Sinclair & Empire Company

NORTH

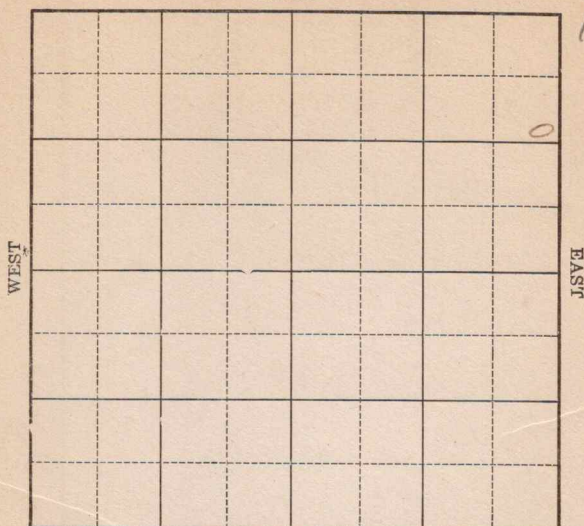

SOUTH

Location _____

Drilling Remarks

Rig Up _____

Drilling Remarks

RECORD

Cased _____ in. _____ ft.

Sand _____

Gas _____

Oil _____

Total Depth _____

PRODUCTION

1st 24 hrs. Nat. _____

1st 24 hrs. after shot _____

Gas _____ cu. ft.


Dry Hole _____

Abandoned _____

Butler Co

Map No. Kansas Sec. 35 Twp. 27 R. 4Well No. 14 Skau FarmLinclair & Empur Company

NORTH

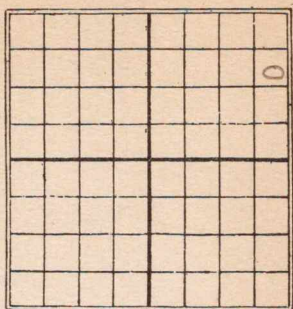1020 Ft. from N. Line

Ft. from S. Line

250 Ft. from E. Line

Ft. from W. Line

Date

REPORT

192512/23Bldg Rig12/3119261/8Rigging up.1/12Only 350'1/30✓ 830'1/27✓ 1520'2/42/10✓ 3626'2/24Sand 2537-92 40 Bbls

Map No. *KANSAS* Sec. *35* Twp. *27* R. *4*

Well No. *14* *Account*

Anclain & Empire Company

Contractor

SECTION PLAT

1020 Ft. from N. Line

Ft. from S. Line

750 Ft. from E. Line

Ft. from W. Line

			<i>6</i>

FIRST REPORTS

Location

Rig up

Drilling and Remarks:

Block Rev

RECORD

Cased in., ft.

Sand

Gas

Oil

Total Depth

PRODUCTION

1st 24 hrs. Nat.

1st 24 hrs. after shot

Gas Cu. Ft.

Dry Hole

Abandoned

Date

DEC 23 1925

CHAS. L. SHERWOOD
Scout

Button Co

K11 KANSAS 35 Twp. 27 R. 4
Map No. Sec. Twp. R.Well No. 14 254011
Sunclair & Empire Company

Contractor

COMPLETED

SECTION PLAT

1020 Ft. from N. Line

Ft. from S. Line

250 Ft. from E. Line

Ft. from W. Line

			0

Location

Rig up

Drilling and Remarks:

RECORD

Cased in. ft.

Sand 2537-2592

Gas

Oil

Total Depth 2592

PRODUCTION

1st 24 hrs. Nat.

1st 24 hrs. after shot

Gas Cu. Ft.

Dry Hole

Abandoned

Date

FEB 24 1926

CHAS. L. SHERWOOD

192

Scout

Pumping 40 BS