


Map No. 35 Sec. 27 Twp. 4 R. 4

Well No. 15 AKar (SKar) Farm

Linclair & Empire Company

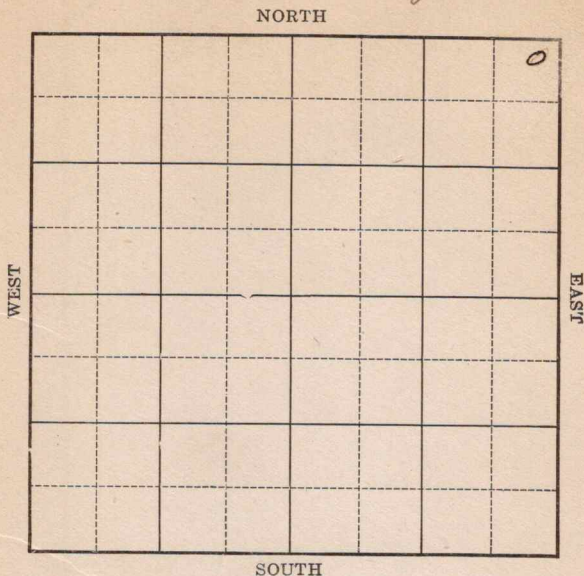

Location _____

Drilling Remarks

Rig Up _____

Drilling Remarks

RECORD

Cased _____ in. _____ ft.

Sand _____

Gas _____

Oil _____

Total Depth _____

PRODUCTION

1st 24 hrs. Nat. _____

1st 24 hrs. after shot _____

Gas _____ cu. ft.

Dry Hole _____

Abandoned _____

Butler Co

Map No. _____ Sec. 33 Twp. 27 R. 4

Well No. 15 Spaul Farm

Lindair O & G Company

NORTH

250 Ft. from N. Line

-----Ft. from S. Line

250' Ft. from E. Line

Ft. from W. Line

WEST

EAST

SOUTH

1926

Date _____

REPORT

3/3	Location
-----	----------

3/10	Bldg Riq
------	----------

3/18 | _____

3/25	Rigging up.
------	-------------

4/1	Alg 600
-----	---------

4/9/	0	745
------	---	-----

4/14.	"	1220
-------	---	------

4/21	"	1800
------	---	------

4/30	Dlg 2480.
------	-----------

5/8	Dand 2568-2601' 1500'
	aih

5/12	Sond. 2568-2604, 80 bbls. natural
------	--------------------------------------

Map No. *K11* **KANSAS** Sec. *35* Twp. *27* R. *4*

Well No. *15* *Alcen*
Anchor & Empire Company

Contractor

SECTION PLAT

250 Ft. from N. Line

Ft. from S. Line

250 Ft. from E. Line

Ft. from W. Line

FIRST REPORTS

			0

Location *✓*

Rig up

Drilling and Remarks:

RECORD

Cased _____ in., _____ ft.

Sand _____

Gas _____

Oil _____

Total Depth _____

PRODUCTION

1st 24 hrs. Nat. _____

1st 24 hrs. after shot _____

Gas _____ Cu. Ft.

Dry Hole _____

Abandoned _____

Date

MAR 3 1926

CHAS. L. SHERWOOD

192

Scout

K11 **KANSAS** Sec. 35 Twp. 27 R. 4

Well No. 15 Sharon

McClain & Empire Company

Contractor

COMPLETED

250 Ft. from N. Line

_____ Ft. from S. Line

250 Ft. from E. Line

_____ Ft. from W. Line

SECTION PLAT

			0

Location _____

Rig up _____

Drilling and Remarks:

RECORD

Cased _____ in., _____ ft.

Sand 1568-2604

Gas _____

Oil _____

Total Depth 2604

PRODUCTION

1st 24 hrs. Nat. _____

1st 24 hrs. after shot _____

Gas _____ Cu. Ft.

Dry Hole _____

Abandoned _____

Date

MAY 12 1926

192

CHAS. L. SHERWOOD

Scout

80 BS natural.