

Company Sinclair-Prairie & CSO

A 7x7 grid map with 'NORTH' at the top, 'SOUTH' at the bottom, 'WEST' on the left, and 'EAST' on the right. The word 'Misc.' is written in the top-left cell, and a small circle is in the cell at row 3, column 6.

Sec. 35 Twp. 27 R. 4E

Well No. #17 Skaer Farm

Sinclair-Prairie & CSO Company

Miscellaneous


Ft. from N. Line

990 Ft. from S. Line

990 Ft. from E. Line

Ft. from W. Line

NW SE NE

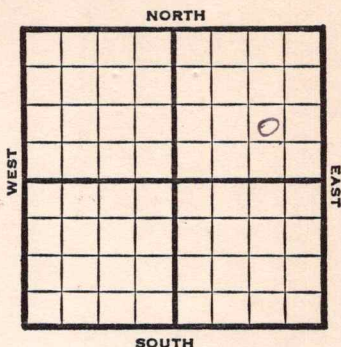

Elev. 1300' REPORT

1947

8/27 Location

9/3 "

9/10 "

9/17 "

9/24 "

10/1 "

10/8 "

10/15 "

10/22 "

10/29 Mach.

11/5 Drlg. 751'

11/12 Drlg. 615'

11/19 12" @ 750'
Drlg. 1020'

11/25 Drlg. 1535'

12/3 10" @ 1557'
Drlg. 1785'

12/10 "

12/17 8" @ 2042'

OVER

1947

781366

12/30

Simp. 2527'

7" @ 2528'

Arb. 2594'

500 acid

Pump 150 Pot

38.0 Gr.

TD 2595'

COMPLETED

Map No. _____ Sec. 35 Twp. 27 R. 4E

Well No. 17 Skaer

Sinclair-Prairie & CSO Company

FIRST REPORT

Contractor _____

NW SE NE

SECTION PLAT

_____ Ft. from N. Line

990 Ft. from S. Line

990 Ft. from E. Line

_____ Ft. from W. Line

			0

Butler County

Location X

Rig up _____

Drilling and Remarks:

RECORD

Cased _____ in., _____ ft.

Sand _____

Gas _____

Oil _____

Total Depth _____

PRODUCTION

1st 24 hrs. Nat. _____

1st 24 hrs. after shot _____

Gas _____ Cu. Ft.

Dry Hole _____

Abandoned _____

Date

AUG 27 1947

19

S. J. LEWIS

Scout

