


Map No. 9 Kansas Sec. 2 Twp. 23 R. 9 ✓Well No. 6 a. Hartley FarmManhattan Company

NORTH

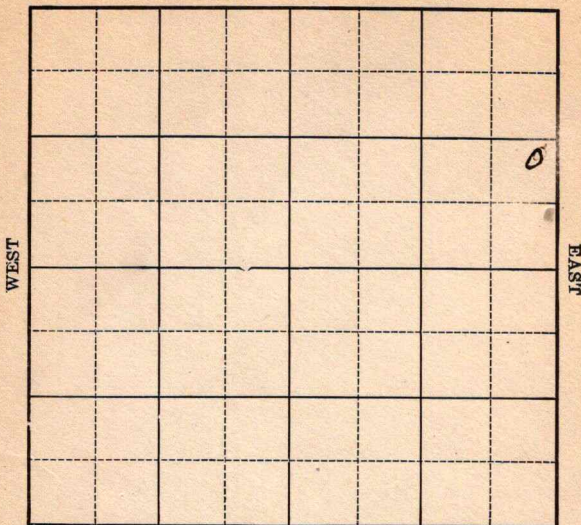

SOUTH

Location _____

Drilling Remarks _____

Rig Up _____

Drilling Remarks _____

RECORD

Cased _____ in. _____ ft.

Sand _____

Gas _____

Oil _____

Total Depth _____

PRODUCTION

1st 24 hrs. Nat. _____

1st 24 hrs. after shot _____

Gas _____ cu. ft.

Dry Hole _____

Abandoned _____


Greenwood Co

Map No. _____ Sec. 2 Twp. 23 R. 9Well No. 6 # Hartley Farm _____Manhattan Oil Company

_____ Ft. from N. Line

990' Ft. from S. Line330' Ft. from E. Line

_____ Ft. from W. Line

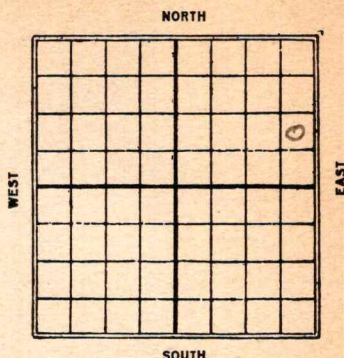

1926

Date

REPORT

3/3 Timbers2/24 Alg 22253/5 " 18203/10 Rig3/18 Rigging up.4/1 Alg 8804/7 " 13504/14 " 15204/21 " 1595-4/30 " 18255/8 " 21605/12 " 2365'5/19 Sand. 2365-2407 I.D.Oil 2396 100/75 BBl.

K15 **KANSAS** Sec. 2 Twp. 23 R. 9

Well No. 64 Hartley
Manhattan oil Co. Company

Contractor

SECTION PLAT

_____ Ft. from N. Line

990 Ft. from S. Line

330 Ft. from E. Line

_____ Ft. from W. Line

FIRST REPORTS

Location _____

Rig up lumber

Drilling and Remarks:

RECORD

Cased _____ in., _____ ft.

Sand _____

Gas _____

Oil _____

Total Depth _____

PRODUCTION

1st 24 hrs. Nat. _____

1st 24 hrs. after shot _____

Gas _____ Cu. Ft.

Dry Hole _____

Abandoned _____

Date

MAR 3 1926

192

CHAS. L. SHERWOOD

Scout

K15 **KANSAS** Sec. 2 Twp. 23 R. 9
 Map No. 64 Hartley

Well No. Manhattan oil Co Company

Contractor

COMPLETED

SECTION PLAT

		✓	0
		✓	

_____ Ft. from N. Line

990 Ft. from S. Line

330 Ft. from E. Line

_____ Ft. from W. Line

Location _____

Rig up _____

Drilling and Remarks:

oil 2376

1007 75 BS

RECORD

Cased _____ in., _____ ft.

Sand 2365-2407

Gas _____

Oil _____

Total Depth 2407

PRODUCTION

1st 24 hrs. Nat. _____

1st 24 hrs. after shot _____

Gas _____ Cu. Ft.

Dry Hole _____

Abandoned _____

Date

MAY 19 1926

192

CHAS. L. SHERWOOD

Scout