

KANSAS

Section 35 Township 27 Range 4EWell No. #18 SkaerCompany Sinclair-Prairie etal.

NORTH

						0.	

SOUTH

WEST EAST

KANSAS


Butler

Sec. 35 Twp. 27 R. 4EWell No. #18 Skaer FarmSinclair-Prairie et al Company

Misc.

990 Ft. from N. Line Ft. from S. Line990 Ft. from E. Line Ft. from W. Line

SW NE NE

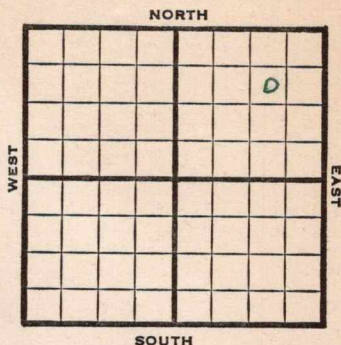

1948

Elev. 1296' REPORT

1/14	Location
1/21	"
1/26	Mach.
2/4	"
2/11	"
2/18	Drlg 60'
2/25	15" @ 77' Drlg. 605'
3/3	12" @ 825' Drlg. 1165'
3/10	Drlg. 1875'
3/17	8" @ 1725' Lansing 1755' KC 2043' 2355' fishing.
3/24	Simpson Sd 2546' TD 2547' Run csg.
3/31	6" @ 2547' WOC
4/7	Arbuckle 2609' TD 2610'
4/14	PB 2604'

OVER

1948

781370

4/21

Arbuckle 2609'

6" @ 2547'

Pump 12 Pot.

Gr. 39°

TD 2610'

COMPLETED

Map No. _____ Sec. 35 Twp. 27 R. 4E

Well No. 18 Skaer

Sinclair-Prairie et al. Company

FIRST REPORT Contractor

SW NE NE


SECTION PLAT

990 Ft. from N. Line

_____ Ft. from S. Line

990 Ft. from E. Line

_____ Ft. from W. Line

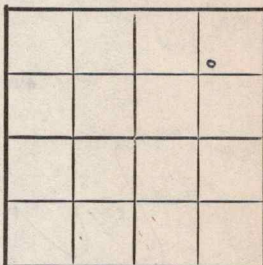

Butler County

Location X

Rig up _____

Drilling and Remarks:

RECORD

Cased _____ in., _____ ft.

Sand _____

Gas _____

Oil _____

Total Depth _____

PRODUCTION

1st 24 hrs. Nat. _____

1st 24 hrs. after shot _____

Gas _____ Cu. Ft.

Dry Hole _____

Abandoned _____

Date

JAN 14 1948 19

S. J. LEWIS Scout

Map No. 11 Sec. 35 Twp. 27 R. 4E

Well No. 18 Shaer

Sinclair-Prairie etal. Company

COMPLETE Contractor

SW NE NE

E/11296
SECTION PLAT

990 Ft. from N. Line

Ft. from S. Line

990 Ft. from E. Line

Ft. from W. Line

			6

Butler County

Location _____

Rig up _____

Drilling and Remarks:

Qr 72609

6 102547

Pump 12 Pst

3526

RECORD

Cased _____ in., _____ ft.

Sand _____

Gas _____

Oil _____

Total Depth 2610

PRODUCTION

1st 24 hrs. Nat. _____

1st 24 hrs. after shot _____

Gas _____ Cu. Ft.

Dry Hole _____

Abandoned _____

Date

APR 21 1948

19

S. J. LEWIS Scout