
DX 78-1

Butler KANSAS

Section 35 Township 27 Range 4E

Well No. 20 Skaer

Company Sinclair

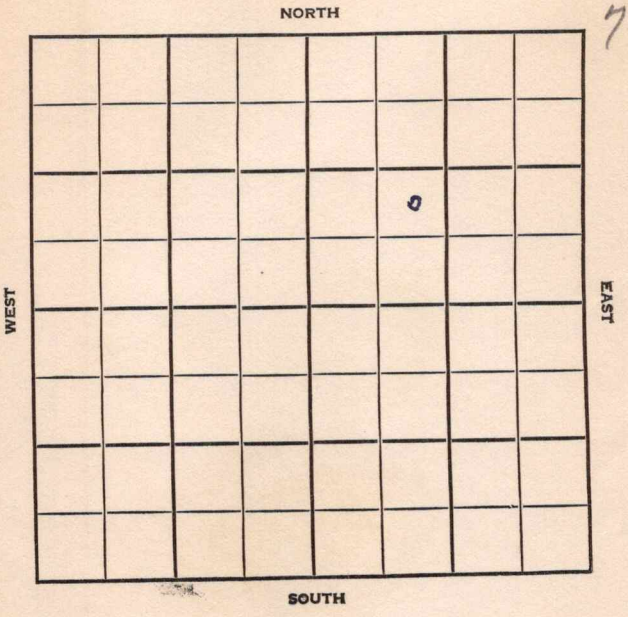

Butler KANSAS

SEC.	TWP.	R.
35	27	4E

WELL NO.

20 Skaer FARM

COMPANY

Sinclair

CONTRACTOR

Smitherman

Augusta Pool


_____ Ft. from N. Line

990 Ft. from S. Line

_____ Ft. from E. Line

990 Ft. from W. Line

NE SW NE

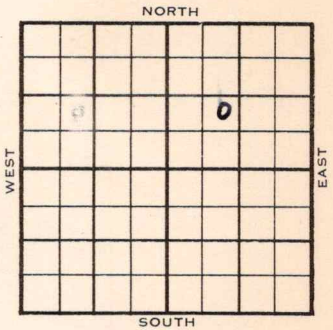

1954	ELEVATION 1295'	REPORT
8/25	Spud 8-23-54 8" @ 80'	
10/6	Spud 8-23-54 Oil well TD 2642 8" @ 80 Lans 2037 Simp. 2517 Arb. 2602 TD 2640 Schl tops: KC 2038 Simp sh 2522 Simp. sd 2543' Simp sd 2543' Arb. 2604 TD 2642 5" @ 2640 CO 38/2625-37 S/50 BWPH SP 2620 ~~58X25~~ 58/2543-58 B/7 qt. OPH Hydro. F/140 BO 30 BW Comp. 121 BOPD 65 BW COMPLETED	

DX-78

FORM 275 FOR SALE BY KANSAS BLUE PRINT CO.


County Butler State Kansas

Sec. 35 (Blk.) (Twp.) 27 (Sur.) (Rge.) 4E Map No.

Operator Sinclair

Well No. 20 Farm Skaer

Elev. Location NE SW NE

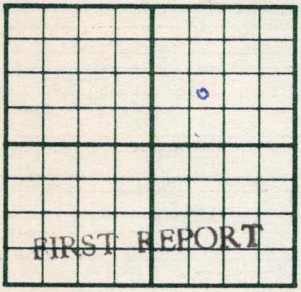

990 Ft. From S Line NE

990 Ft. From W Line Quarter

1st. Report AUG 25 1954

Completion

Remarks Smitherman - Contr.

Spudding Date 8-23-54

Drlg. Data Augusta Pool

8" @ 30

FABEN GILSTRAP

FORM 275 FOR SALE BY KANSAS BLUE PRINT CO.


County Butler State Kansas

Sec. 35 (Blk. Twp.) 27 (Sur. Rge.) 4E Map No.

Operator Sinclair

Well No. 20 Farm Skaer

Elev. 1295 Location NE SW NE

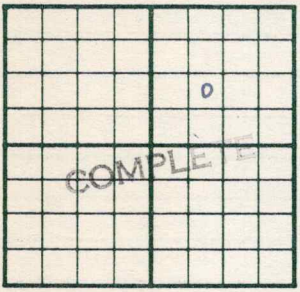

990 Ft. From S Line NE

990 Ft. From W Line Quarter

1st. Report

Completion OCT 6 1954

Remarks Augusta Pool

Smitherman - Contr.

Spudding Date 8-23-54

Drlg. Data Oil well TD 2642

8" @ 80 Lans. 2037 Simp. 2517

Arb. 2602 TD 2640 SCHLUMBERGER TOPS

KC 2038 Simp. sh. 2522 Simp. sd. 2543

Simp. sd. 2543 Arb. 2604 TD 2642

5" @ 2640 CO 38/ 2625-37 S/ 50 bwph

SP 2620 58/ 2543-58 B/ 7 qt oph

Hydro. F/ 140 bo 30 bw

Comp. 121 bopd 65 bw

FABEN GILSTRAP