
Form 51 5M 8-24 16567

Map No. Kans Sec. 2 Twp. 23 R. 9E

Well No. 2 (B) Hartley Farm

~~Rodgers Riverley et al.~~ Company

Grenland Oil

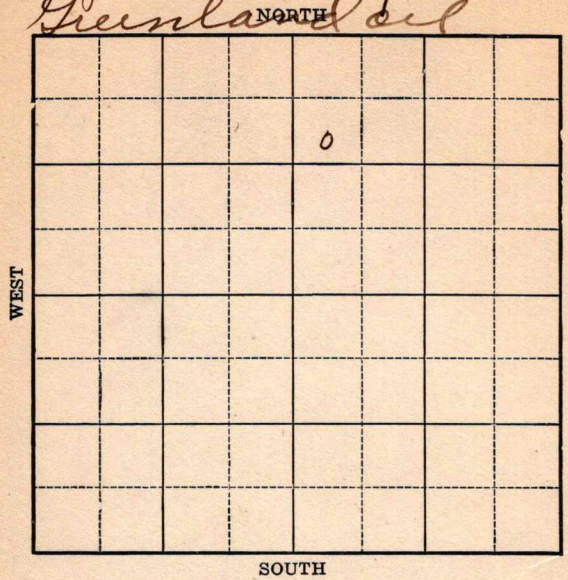

Location

Drilling Remarks

Rig Up

Drilling Remarks

RECORD

Cased in. ft.

Sand

Gas

Oil

Total Depth

PRODUCTION

1st 24 hrs. Nat.

1st. 24 hrs. after shot

Gas cu. ft.

Dry Hole

Abandoned

Form 252A 5M 8-24 16529

Map No. Kansas Sec. 2 Twp. 23 R 9 E

Well No. 2 B Hartley Farm


~~Rodgers Riverley etal~~ Company
Grelnland out

990 Ft. from N. Line

Ft. from S. Line

Ft. from E. Line

330 Ft. from W. Line

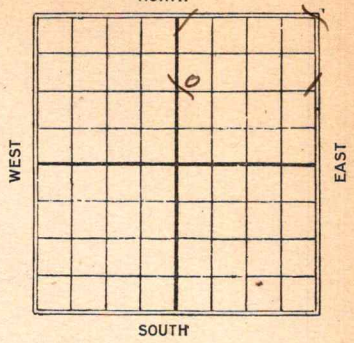

Date 1925	REPORT
4/6	Location
5/21	2340-2397 3 M Gas/ Flowing 300 Bbls

Form 26—1M Bks.—3-23—11959.

Map No. 15 KANSAS Sec. 2 Twp. 23 R. 9 E


Well No. 2 (B) Hartley

Rodgers Rumley etal Company

Contractor

FIRST REPORT

SECTION PLAT

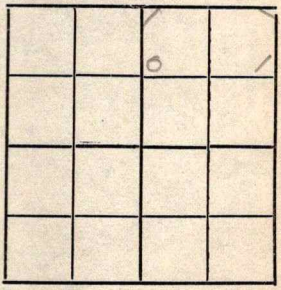

990' Ft. from N. Line

Ft. from S. Line

Ft. from E. Line

330' Ft. from W. Line

Location

Rig up

Drilling and Remarks:

RECORD

Cased in., ft.

Sand

Gas

Oil

Total Depth

PRODUCTION

1st 24 hrs. Nat.

1st 24 hrs. after shot

Gas Cu. Ft.

Dry Hole

Abandoned

Date APR 6 1925

192

M. A. BENEAR Scout

Form 26—1M Bks.—3-23—11958.

Map No. 12 Linda Sec. 2 Twp. 23 R. 9

Well No. Hartley

Mon land Oil Co Company

Note Formerly carried as Hoodly & Co Contractor

CORRECTION


_____Ft. from N. Line

_____Ft. from S. Line

_____Ft. from E. Line

_____Ft. from W. Line

SECTION PLAT

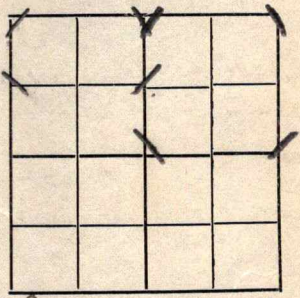

Correction on Company name

Location _____

Rig up _____

Drilling and Remarks:

CORRECTION

Chg ownership to Monland Oil Co. on the outlined acreage

RECORD

Cased _____ in., _____ ft.

Sand _____

Gas _____

Oil _____

Total Depth _____

PRODUCTION

1st 24 hrs. Nat. _____

1st 24 hrs. after shot _____

Gas _____ Cu. Ft.

Dry Hole _____

Abandoned _____

Date APR 17 1925 192_

Lts L Sherwood Scout

Form 26—1M Bks.—3-23—11959.

Map No. 13 Sec. 2 Twp. 23 R. 9

Well No. 2 "B" Hartley

Producers Oil Co. Company

Contractor

COMPLETED


990 Ft. from N. Line

Ft. from S. Line

Ft. from E. Line

330 Ft. from W. Line

SECTION PLAT

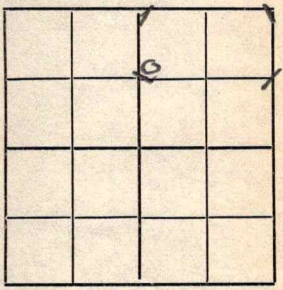

Location

Rig up

Drilling and Remarks:

3rd gtz

Flowing 300 b/s

natural.

RECORD

Cased in., ft.

Sand 2340-2397

Gas

Oil

Total Depth 2397

PRODUCTION

1st 24 hrs. Nat.

1st 24 hrs. after shot

Gas Cu. Ft.

Dry Hole

Abandoned

Date

MAY 21 1925

192

CHAS. L. SHERWOOD Scout