


Map No. Kansas Sec. 2 Twp. 23 R. 9Well No. 7 B Hartley Farm~~Greenland Oil~~ Company

Manhattan Oil

Ft. from N. Line

330 Ft. from S. Line990 Ft. from E. Line

Ft. from W. Line

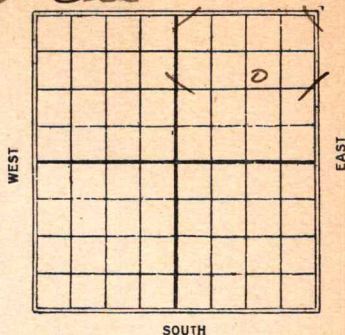

Date

REPORT

192511/19 Timbers11/27 —12/3 —12/10 —12/17 —12/23 —12/31 —19261/8 —1/14 Bldg rig1/20 Rig1/27 Spudding2/4 Dlg 5120'2/10 Dlg 1210' (chq ownership)2/17 " 1665'3/3 Sand 2397-2447100 gts 200 barrels

Greenwood Co

K15
Map No. KANSAS Sec. 2 Twp. 22 R. 9

Well No. 7 B Hartby

Greenland Oil Co Company

Contractor

FIRST REPORTS

SECTION PLAT

Ft. from N. Line

330

Ft. from S. Line

990

Ft. from E. Line

Ft. from W. Line

Location

Rig up

Drilling and Remarks:

RECORD

Cased _____ in., _____ ft.

Sand _____

Gas _____

Oil _____

Total Depth _____

PRODUCTION

1st 24 hrs. Nat. _____

1st 24 hrs. after shot _____

Gas _____ Cu. Ft.

Dry Hole _____

Abandoned _____

Date

NOV 19 1925

CHAS. L. SHERWOOD

192

Scout

1515 KANSAS 2 23 9
 Map No. Sec. Twp. R.

Well No. *Hartley*
manhattan oil Co Company

Contractor


SECTION PLAT

_____ Ft. from N. Line

_____ Ft. from S. Line

_____ Ft. from E. Line

_____ Ft. from W. Line

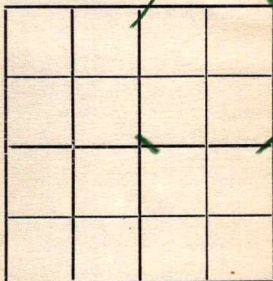

CORRECTION

Location _____

Rig up _____

Drilling and Remarks:

*chg ownership
 on this lease
 to above.*

RECORD

Cased _____ in., _____ ft.

Sand _____

Gas _____

Oil _____

Total Depth _____

PRODUCTION

1st 24 hrs. Nat. _____

1st 24 hrs. after shot _____

Gas _____ Cu. Ft.

Dry Hole _____

Abandoned _____

Date

FEB 10 1926

192

CHAS. I. SHERWOOD

Scout

1215
Map No. **KANSAS** Sec. **2** Twp. **23** R. **9**

Well No. **7 B Hartley**
Manhattan oil Co. Company

Contractor

COMPLETED

SECTION PLAT

			o

_____ Ft. from N. Line

330 _____ Ft. from S. Line

990 _____ Ft. from E. Line

_____ Ft. from W. Line

Location _____

Rig up _____

Drilling and Remarks:

100/200 BB.

RECORD

Cased _____ in., _____ ft.

Sand **2297-2447'**

Gas _____

Oil _____

Total Depth **2447'**

PRODUCTION

1st 24 hrs. Nat. _____

1st 24 hrs. after shot _____

Gas _____ Cu. Ft.

Dry Hole _____

Abandoned _____

Date

MAR 3 1926

192

CHAS. L. SHERWOOD

Scout