
Form 51—10M—8-19—CroMac

Map No. _____ Sec. 18 Twp. 23 R. 4

Well No. 2 Dedrick Farm

Sinclair Co Company

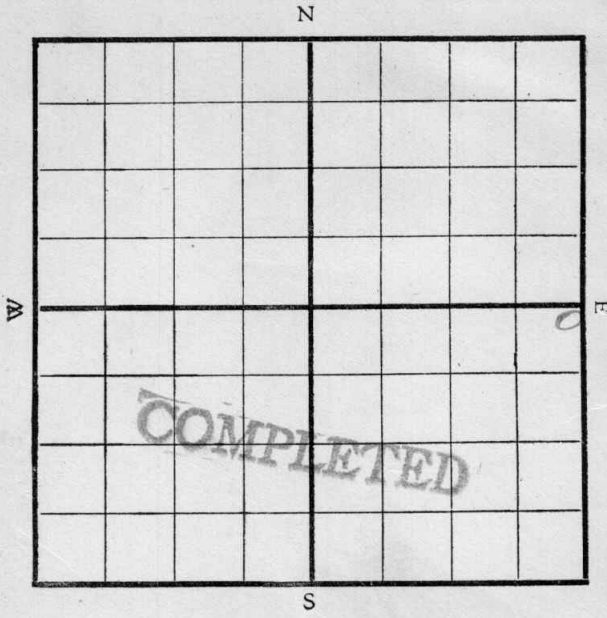

Location _____

Drilling Remarks:

Rig Up _____

Drilling Remarks:

RECORD

Cased _____ in. _____ ft.

Sand _____

Gas _____

Oil _____

Total Depth _____

PRODUCTION

1st 24 hrs. Nat. _____

1st 24 hrs. after shot _____

Gas _____ cu. ft.

Dry Hole _____

Abandoned _____

Form 252A 2M-9-19-CroMac.

Map No. _____ Sec. 18 Twp. 23 R. 4

Well No. 2 Dedrick Farm

Sinclair Oil & Gas Co. Company

_____ Contractor


SE. Quarter

700 Ft. from N. Line

_____ Ft. from S. Line

700 Ft. from E. Line

_____ Ft. from W. Line

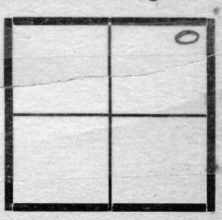

Date 1919	REPORT
10/11	Rig up.
10/21	Spudding.
10/31	Drlg. 750'
11/4	LD boiler trouble 960
12	1430
14	DRlg 1600
25	Drlg. 1950'
12/2	DRlg 2100
9	Drlg. 2180'
16	DRl 2210'
23	WR. 6" to 2293'
1/4/20	Drlg. 2330'
6	2418'
14	Sand 2418'-2419 show.
19	Sand 2418'-22' small show - Tubing
27	2418'-22' - Tubing show
2/2	2418'-22' - 20 Bbl

COMPLETED

Form 26—1M—4-19—Mid-West


Map No._____ Sec. 18 Twp. 23 R. 4

Well No. 2 Dedrick

Sinclair O & G Company

_____ Contractor

SECTION PLAT

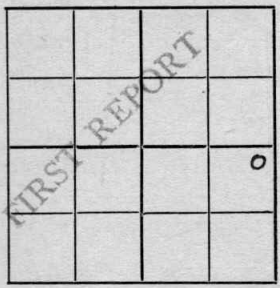

200 Ft. from N. Line

_____ Ft. from S. Line

200 Ft. from E. Line

_____ Ft. from W. Line

Location _____

Rig up _____

Drilling and Remarks:

Timbers

RECORD

Cased _____ in., _____ ft.

Sand _____

Gas _____

Oil _____

Total Depth _____

PRODUCTION

1st 24 hrs. Nat. _____

1st 24 hrs. after shot _____

Gas _____ Cu. Ft.

Dry Hole _____

Abandoned _____

Date

_____ 191____

Pyle

_____ Scout

Form 26—1M—4-19—Mid-West


Map No. K14 Sec. 18 Twp. 23 R. 4

Well No. 3 Dedrick

Sinclair Company

Contractor

SECTION PLAT

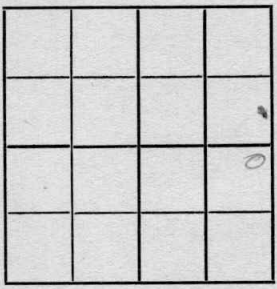

200 Ft. from N. Line

Ft. from S. Line

200 Ft. from E. Line

Ft. from W. Line

Location

Rig up

Drilling and Remarks:

RECORD

Cased in., ft.

Sand

Gas

Oil

Total Depth

PRODUCTION

1st 24 hrs. Nat.

1st 24 hrs. after shot

Gas C

Dry Hole

Abandoned

Date

9/30 191 9.

Pyle

Form 26—1M—4-19—Mid-West


Map No. K14 Sec. 18 Twp. 23 R. 4

Well No. 2 Dedrick

Sinclair Company

Contractor

SECTION PLAT

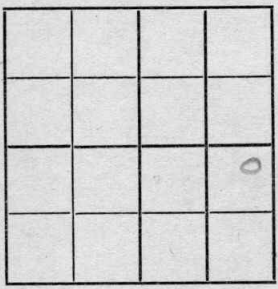

200 Ft. from N. Line

Ft. from S. Line

200 Ft. from E. Line

Ft. from W. Line

Location

Rig up

Drilling and Remarks:

Rig.

RECORD

Cased in., ft.

Sand

Gas

Oil

Total Depth

PRODUCTION

1st 24 hrs. Nat.

1st 24 hrs. after shot

Gas Cu. Ft.

Dry Hole

Abandoned

Date

10/14 1919. Pyle Scout

Form 26—1M—4-19—Mid-West


Map No. K14 Sec. 18 Twp. 23 R. 4

Well No. 2 Dedrick

Lindsair Company

Contractor

SECTION PLAT

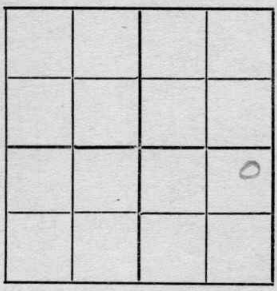

200 Ft. from N. Line

Ft. from S. Line

200 Ft. from E. Line

Ft. from W. Line

Location

Rig up

Drilling and Remarks:

Spud

RECORD

Cased in., ft.

Sand

Gas

Oil

Total Depth

PRODUCTION

1st 24 hrs. Nat.

1st 24 hrs. after shot

Gas Cu. Ft.

Dry Hole

Abandoned

Date

10/21 191 9

Pyle Scout

Form 26—1M—4-19—Mid-West


Map No. K14 Sec. 18 Twp. 23 R. 4

Well No. 2 Dedrick

Sinclair Company

Contractor

SECTION PLAT

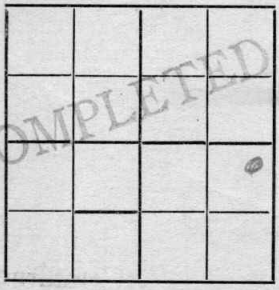

200 Ft. from N. Line

Ft. from S. Line

200 Ft. from E. Line

Ft. from W. Line

COMPLETED

Location

Rig up

Drilling and Remarks:

RECORD

Cased in., ft.

Sand 2418-2422

Gas

Oil

Total Depth

PRODUCTION

1st 24 hrs. Nat. 20 bbls

1st 24 hrs. after shot

Gas Cu. Ft.

Dry Hole

Abandoned

Date

2/2 1920.

Pyle Scout