


Map No. _____ Sec. 35 Twp. 27 R. 4Well No. 1 Slover Farm Starkey_____Empire Company

NORTH

WEST

EAST

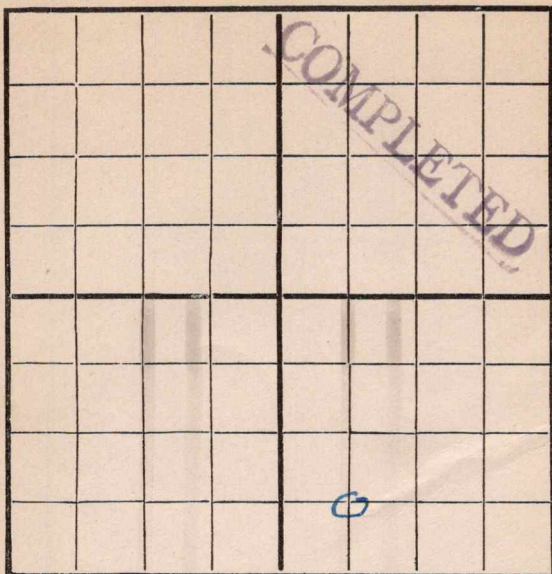

SOUTH

Location _____

Rig Up 8/2

Drilling Remarks:

Drilling Remarks:

9/19-1850-10/2-2085-10/10-228010/17-2200-10/24

RECORD

Cased _____ in _____ Ft.

Sand 2358-2628

Gas _____

Oil _____

Total Depth _____

PRODUCTION

1st 24 hrs. Nat. 300

1st 24 hrs. after shot _____

Gas _____ Cu. Ft.


Dry Hole _____

Abandoned _____

Map No. _____ Sec. 35 Twp. 22 R. 4
 Well No. 1 Farm _____
 _____ Company _____

NORTH

WEST

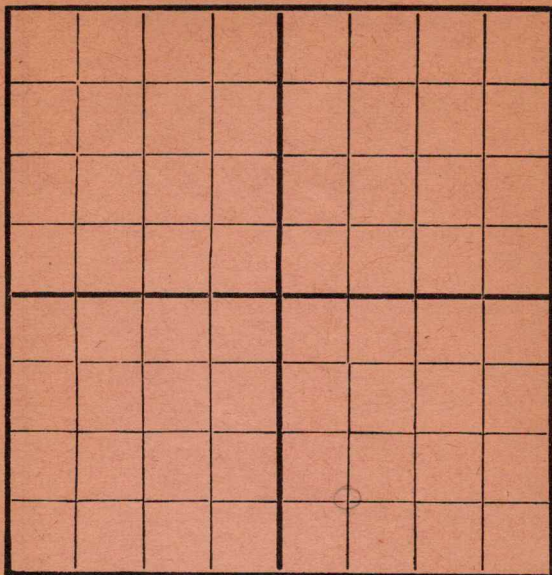

EAST

SOUTH

Location _____
 Rig Up _____
 Drilling and remarks _____

RECORD

Cased _____ in. _____ Ft.
 Sand _____
 Gas _____
 Oil _____
 Total Depth _____

PRODUCTION

1st 24 hrs. Nat. _____
 1st 24 hrs. after shot _____
 Gas _____ Cu. Ft.
 Dry Hole _____
 Abandoned _____

Date

8/12, 1916 _____ Scout

Map No. _____ Sec. 35 Twp. 27 R. 4Well No. 1 _____ Farm _____

_____ Company _____

NORTH

WEST

EAST

SOUTH

Location _____

Rig Up _____

Drilling and remarks _____

RECORD

Cased _____ in. _____ Ft.

Sand _____

Gas _____

Oil _____

Total Depth _____

PRODUCTION

1st 24 hrs. Nat. _____

1st 24 hrs. after shot _____

Gas _____ Cu. Ft.

Dry Hole _____

Abandoned _____


Date

8/8, 1916 Scout

Map No. _____ Sec. 35 Twp. 22 R. 4
 Well No. 1-20 Farm _____
Empire Company _____

NORTH

WEST

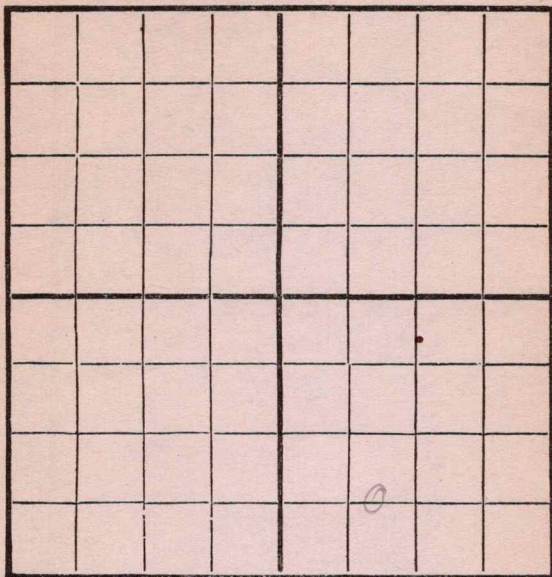

EAST

SOUTH

Location _____
 Rig Up _____
 Drilling and remarks _____

RECORD

Cased _____ in. _____ Ft.
 Sand _____
 Gas _____
 Oil _____
 Total Depth _____

PRODUCTION

1st 24 hrs. Nat. _____
 First 24 hrs. after shot _____
 Gas _____ Cu. Ft.
 Dry Hole _____
 Abandoned _____

Date

8/15, 1916 Scout

Map No. _____ Sec. 35 Twp. 27 R. 4Well No. 1 Slater Farm _____Company Engine _____

NORTH

WEST

EAST

SOUTH

Location _____

Rig Up _____

Drilling and remarks

380

RECORD

Cased _____ in. _____ Ft.

Sand _____

Gas _____

Oil _____

Total Depth _____

PRODUCTION

1st 24 hrs. Nat. _____

First 24 h.s. after shot _____

Gas _____ Cu. Ft.

Dry Hole _____

Abandoned _____

Date


421, 1916Scout

Map No. _____ Sec. 35 Twp. 37 R. 4
 Well No. 1 Storker Farm
Empire Company

NORTH

WEST

EAST

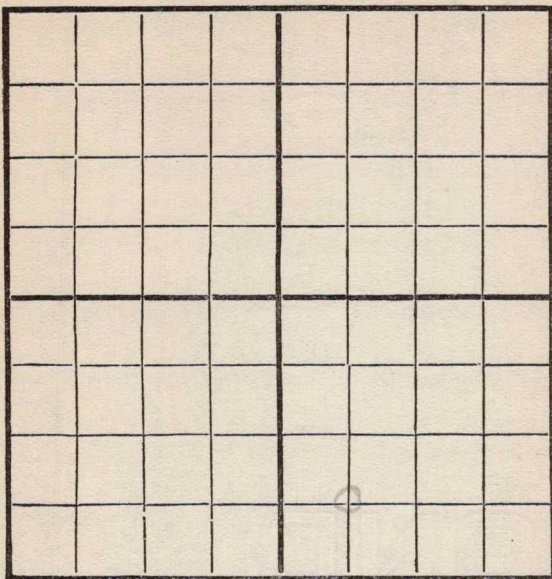

SOUTH

Location _____
 Rig Up _____
 Drilling and remarks _____

780

RECORD

Cased _____ in. _____ Ft.
 Sand _____
 Gas _____
 Oil _____
 Total Depth _____

PRODUCTION

1st 24 hrs. Nat. _____
 First 24 h. s. after shot _____
 Gas _____ Cu. Ft.
 Dry Hole _____
 Abandoned _____

Date


191

Scout

AUG 30 1916

John D. Jeff

Map No. _____ Sec. 35 Twp. 27 R. 4
 Well No. 1 Starke Farm _____
Engine Company _____
 NORTH

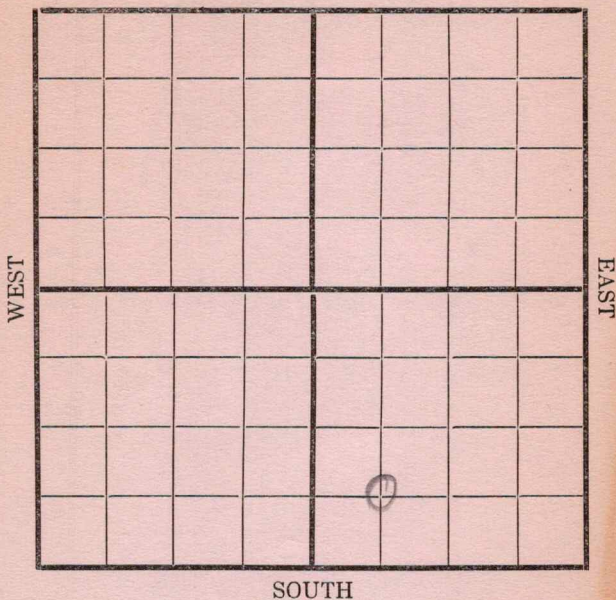

Location _____
 Rig Up _____
 Drilling and remarks

1170

RECORD

Cased _____ in. _____ Ft.
 Sand _____
 Gas _____
 Oil _____
 Total Depth _____

PRODUCTION

1st 24 hrs. Nat. _____
 1st 24 hrs. after shot _____
 Gas _____ Cu. Ft.
 Dry Hole _____
 Abandoned _____

Date

9/5, 1916


A. R. R. Scout

Map No. _____ Sec. 35 Twp. 27 R. 4
 Well No. 1 Stanley Farm _____
Empire Company _____

NORTH

WEST

EAST

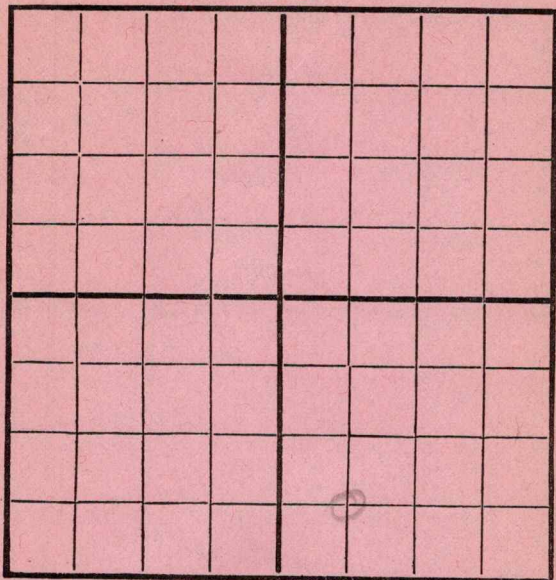

SOUTH

Location _____
 Rig Up _____
 Drilling and remarks

1650

RECORD

Cased _____ in. _____ Ft.
 Sand _____
 Gas _____
 Oil _____
 Total Depth _____

PRODUCTION


1st 24 hrs. Nat. _____
 1st 24 hrs. after shot _____
 Gas _____ Cu. Ft.
 Dry Hole _____
 Abandoned _____

Date

7/11, 1916 Read Off Scout

Map No. _____ Sec. 35 Twp. 27 R. 4
 Well No. 1 Stanley Farm _____
Camp Company _____

NORTH

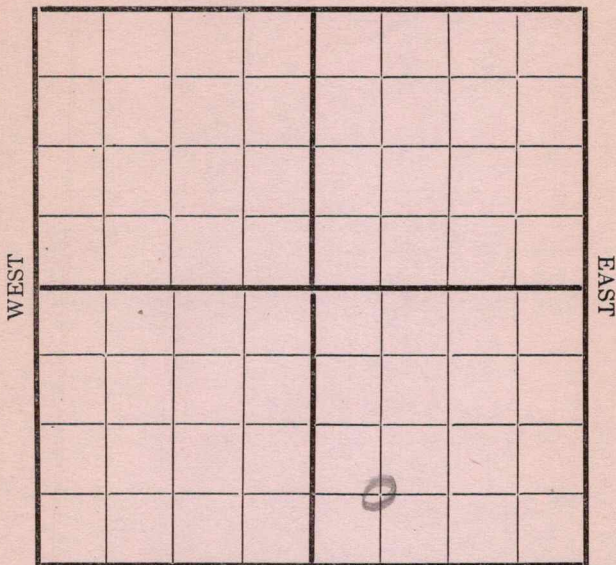

SOUTH

Location _____
 Rig Up _____
 Drilling and remarks _____

1850

RECORD

Cased _____ in. _____ Ft.
 Sand _____
 Gas _____
 Oil _____
 Total Depth _____

PRODUCTION

1st 24 hrs. Nat. _____
 1st 24 hrs. after shot _____
 Gas _____ Cu. Ft.
 Dry Hole _____
 Abandoned _____

Date

9/19, 1916 C. L. Conley Scout

Map No. _____ Sec. 35 Twp. 27 R. 4Well No. 1 Starkey Farm _____

_____ Company _____

NORTH

WEST

EAST

SOUTH

Location _____

Rig Up _____

Drilling and remarks

Made big
show oil & gas
shut down at
present

RECORD

Cased _____ in. _____ Ft.

Sand 2065-2085

Gas _____

Oil _____

Total Depth _____

PRODUCTION

1st 24 hrs. Nat. _____

First 24 hrs. after shot _____

Gas _____ Cu. Ft.

Dry Hole _____

Abandoned _____

Date

9/25, 1916 Academy Scout _____


Map No. _____ Sec. 35 Twp. 27 R. 4Well No. 1 Stanley Farm _____

_____ Company _____

NORTH

WEST

EAST

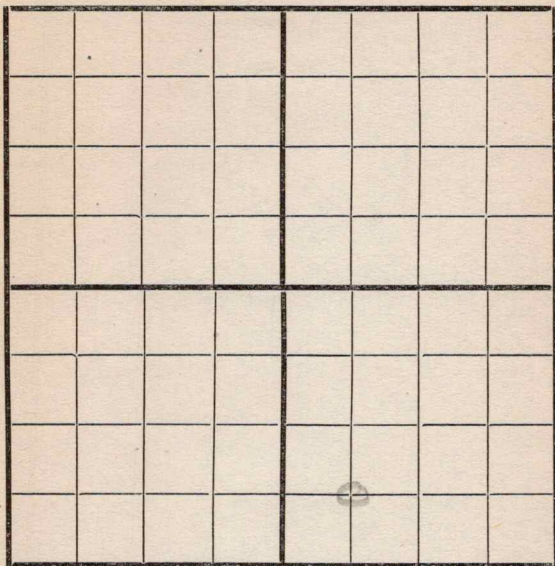

SOUTH

Location _____

Rig Up _____

Drilling and remarks

*Run deep
off this well
and will go
deeper*

RECORD

Cased _____ in. _____ Ft.

Sand 2065-2085

Gas _____

Oil _____

Total Depth _____

PRODUCTION

1st 24 hrs. Nat. _____

1st 24 hrs. after shot _____

Gas _____ Cu. Ft.

Dry Hole _____

Abandoned _____


Date

10/2, 1916 _____ Scout

Map No. _____ Sec. 35 Twp. 27 R. 4
 Well No. 1 Shatkey Farm _____
Empire Company _____

NORTH

WEST

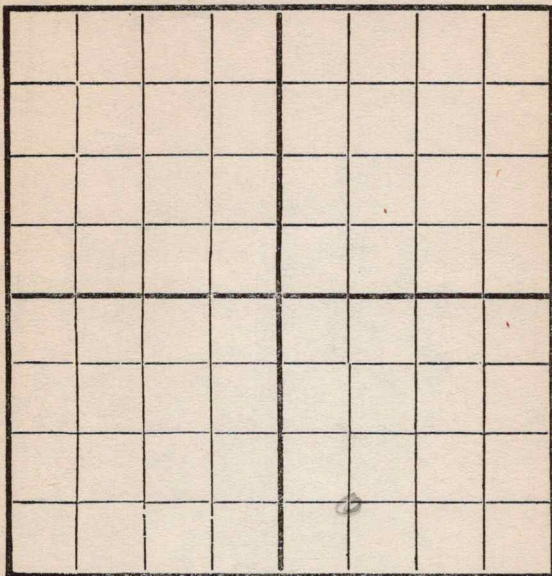

EAST

SOUTH

Location _____
 Rig Up _____
 Drilling and remarks _____

2280
going to
deeper sand

RECORD

Cased _____ in. _____ Ft.
 Sand 2065-2085
 Gas _____
 Oil _____
 Total Depth _____

PRODUCTION

1st 24 hrs. Nat. _____
 First 24 hrs. after shot _____
 Gas _____ Cu. Ft.
 Dry Hole _____
 Abandoned _____

Date


10/10, 191 6 McCandless Scout

Map No. _____ Sec. 35 Twp. 27 R. 4
 Well No. 1 Stanley Farm _____
Engine Company _____

NORTH

WEST

EAST

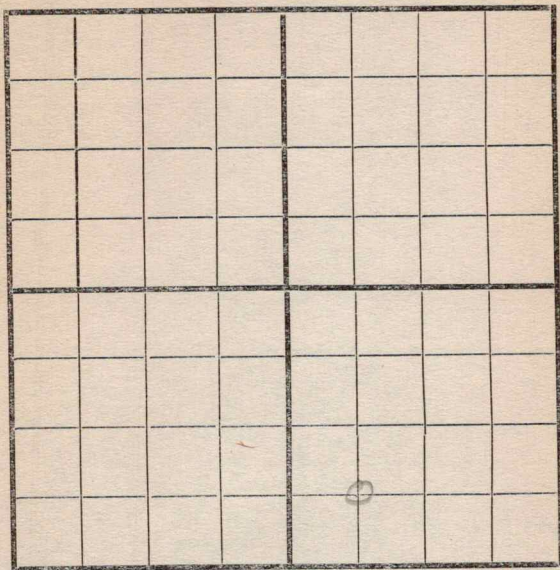

SOUTH

Location _____

Rig Up _____

Drilling and remarks

2200

RECORD

Cased _____ in. _____ Ft.

Sand _____

Gas _____

Oil _____

Total Depth _____

PRODUCTION

1st 24 hrs. Nat. _____

1st 24 hrs. after shot _____

Gas _____ Cu. Ft.

Dry Hole _____

Abandoned _____

Date


10/17, 1916 SCCordoff Scout

Map No. _____ Sec. 35 Twp. 27 R. 4
 Well No. 1 Shutter Farm _____
Company Company _____

NORTH

WEST

EAST

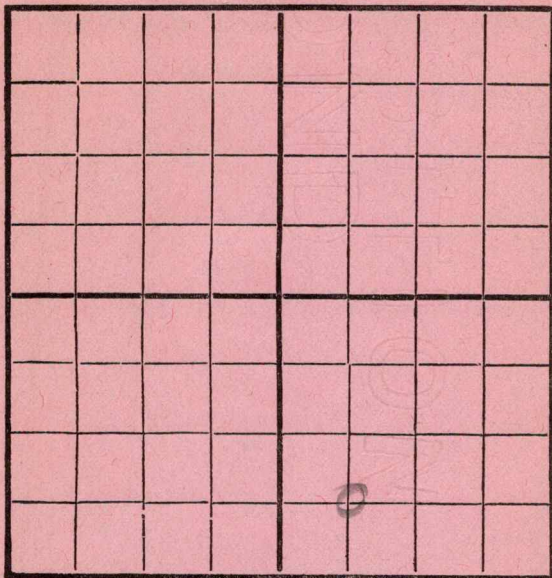

SOUTH

Location _____
 Rig Up _____
 Drilling and remarks _____

Shut Down
2200

RECORD

Cased _____ in. _____ Ft.
 Sand _____
 Gas _____
 Oil _____
 Total Depth _____

PRODUCTION

1st 24 hrs. Nat. _____
 First 24 h.s. after shot _____
 Gas _____ Cu. Ft.
 Dry Hole _____
 Abandoned _____

Date 10/24/16 Blair Scout _____
 191 _____

Map No. _____ Sec. 35 Twp. 27 R. 4
 Well No. 1 Starkley Farm
Engine Company

NORTH

WEST

EAST

SOUTH

Location _____
 Rig Up _____
 Drilling and remarks _____

Top sand

2558

44' in and

showing 600' oil in

RECORD

Cased _____ in. _____ Ft.
 Sand 2558
 Gas _____
 Oil _____
 Total Depth _____


PRODUCTION

1st 24 hrs. Nat. _____
 1st 24 hrs. after shot _____
 Gas _____ Cu. Ft.
 Dry Hole _____
 Abandoned _____

Date Nov 30, 1916

Scout

Map No. _____ Sec. 35 Twp. 27 R. 4
 Well No. 1 Starker Farm _____
Empire Company _____
 NORTH

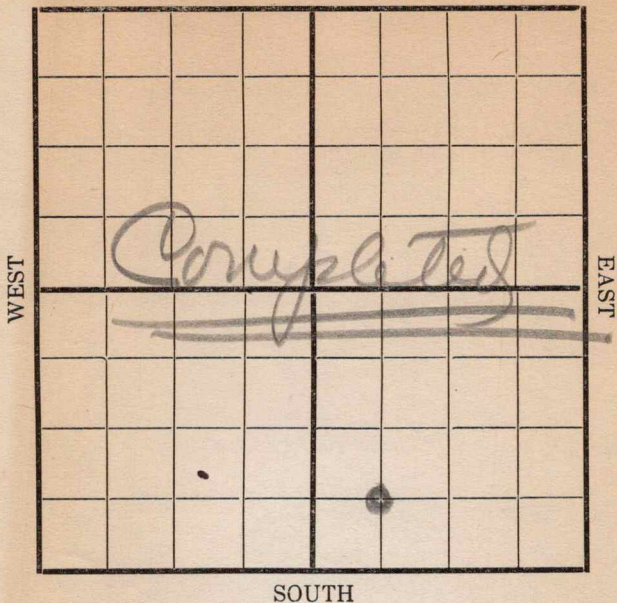

Location _____
 Rig Up _____
 Drilling and remarks

Estimated
at 300 ft.

RECORD

Cased _____ in. _____ Ft.
 Sand 2558-2628
 Gas _____
 Oil _____
 Total Depth _____

PRODUCTION

1st 24 hrs. Nat. _____
 1st 24 hrs. after shot _____
 Gas _____ Cu. Ft.
 Dry Hole _____
 Abandoned _____


Date 4/9, 191 6 Scout

Map No. _____ Sec. 35- Twp. 27 R. 4E
 Well No. 1 W. Starkey Farm
Empire Oil & Gas Company

NORTH

WEST

EAST

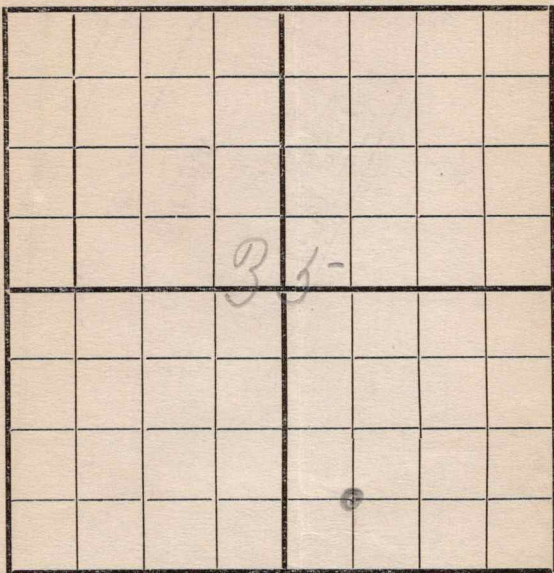

SOUTH

Location _____

Rig Up _____

Drilling and remarks

400 barrels
natural
Production

RECORD

Cased _____ in. _____ Ft.

Sand _____

Gas _____

Oil _____

Total Depth _____

PRODUCTION

1st 24 hrs. Nat. _____

1st 24 hrs. after shot _____

Gas _____ Cu. Ft.

Dry Hole _____

Abandoned _____

Date

11-28, 1916 Ray Stright Scout